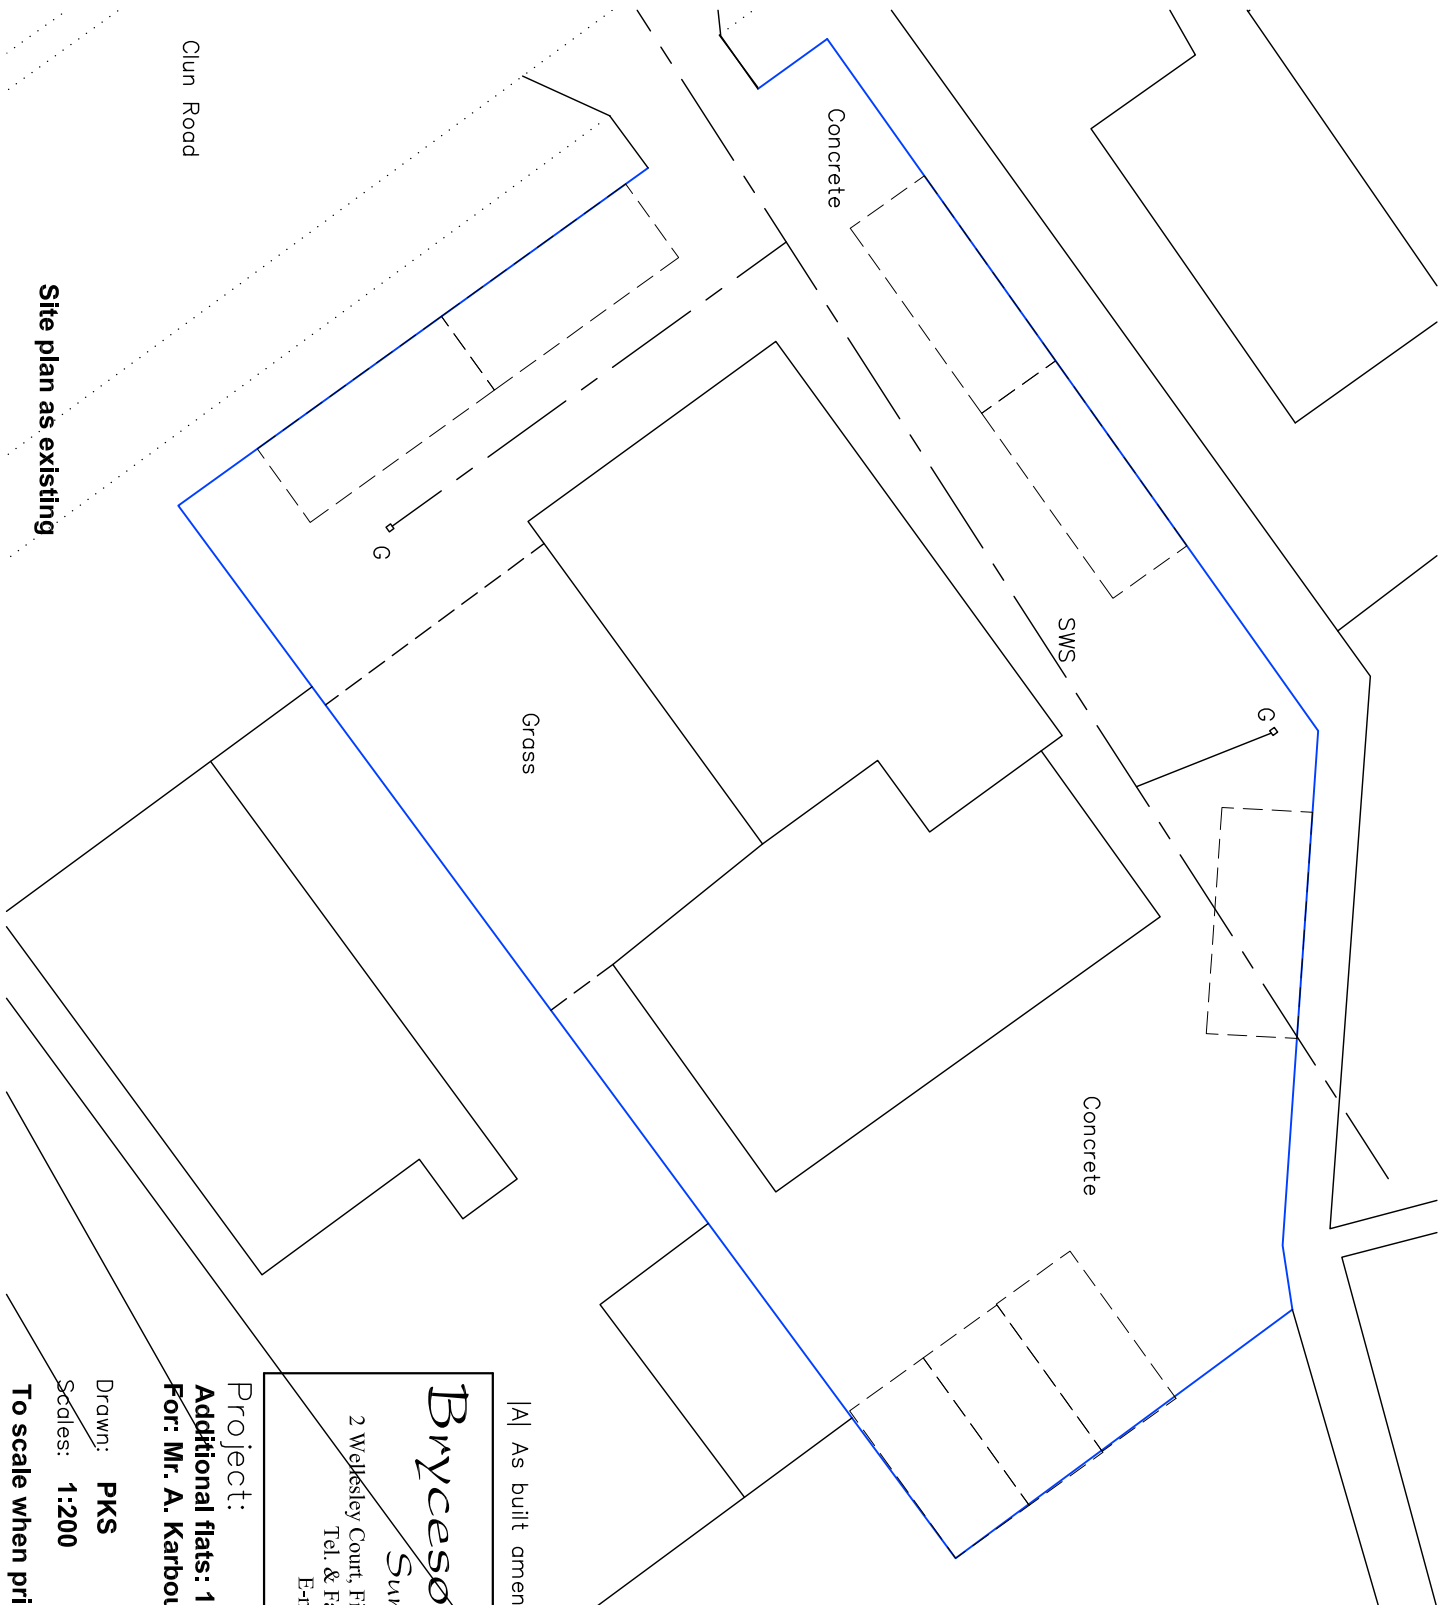


[A] As built amendments

08/10/2013

Bryceson Shaw Associates
Surveyors and Designers

2 Wellesley Court, Fitzalan Road, Littlehampton, West Sussex BN17 5JW
Tel. & Fax 01903 734381 Mobile: 07889 651301
E-mail: brycesonshaw@btinternet.com

Project:

Additional flats: 114 Clun Road, Littlehampton BN17 7ER
For: Mr. A. Karboub

Drawn: **PKS**

Date: **August 2013**

Scales: **1:200**

No: **920/01/11/A**

To scale when printed on A4

Clun Road

Site plan as existing