




1. Contractors must check all dimensions on site. Only figured dimensions are to be worked from. Discrepancies must be reported to the Architect or Engineer before proceeding. © This drawing is copyright
2. Reproduced from OS Sitemap © by permission of Ordnance Survey® on behalf of The Controller of Her Majesty's Stationery Office. © Crown copyright 2008. All rights reserved. Licence number 100007126.

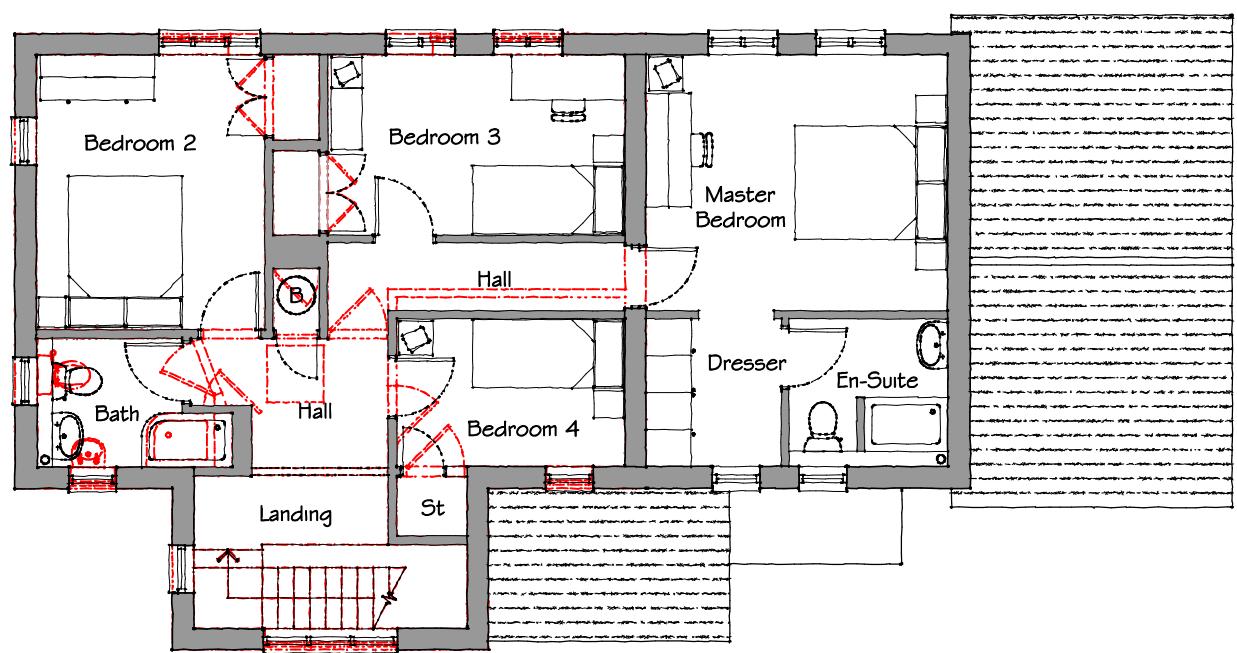


FIRST FLOOR PLAN

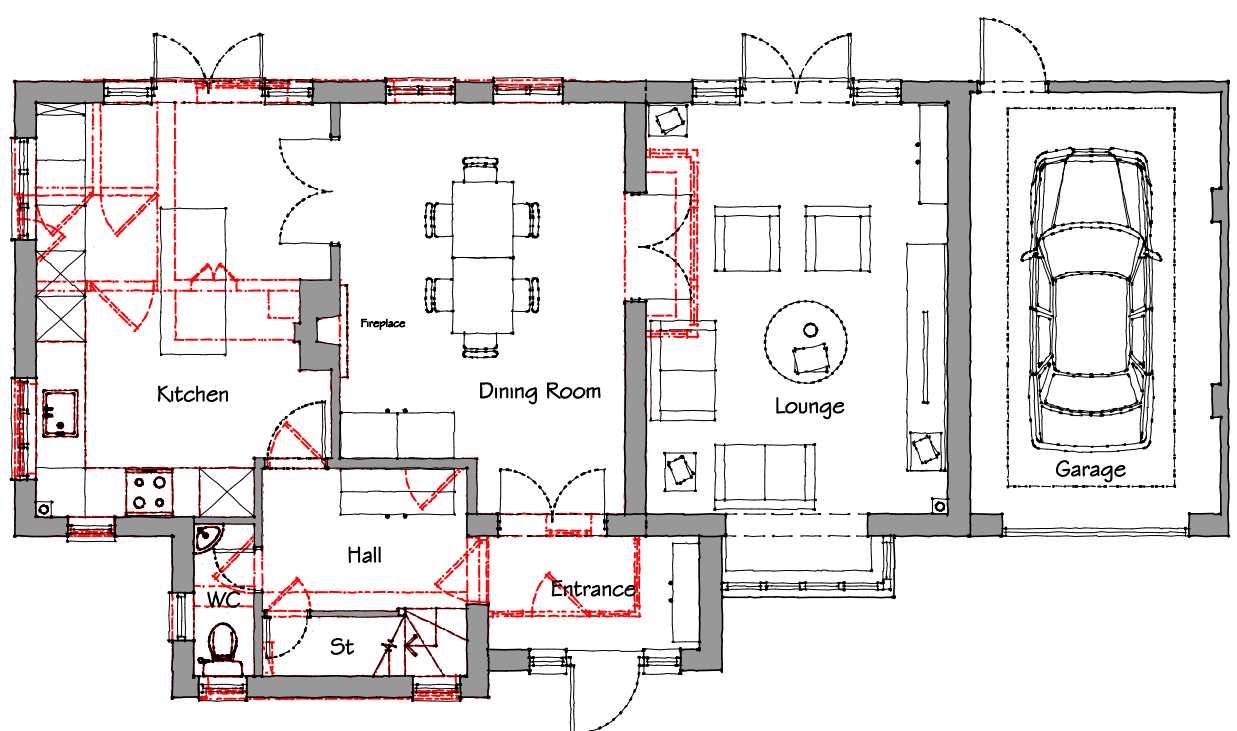


GROUND FLOOR PLAN

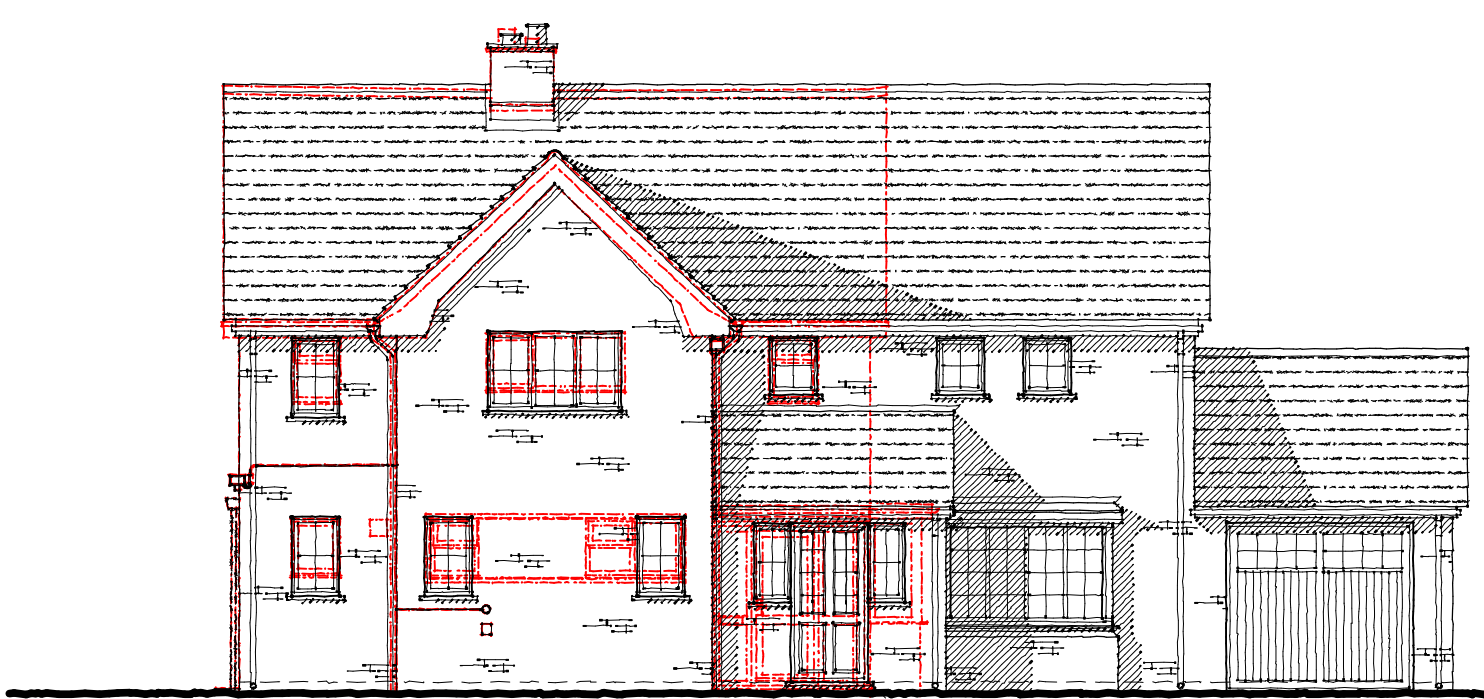


FRONT ELEVATION

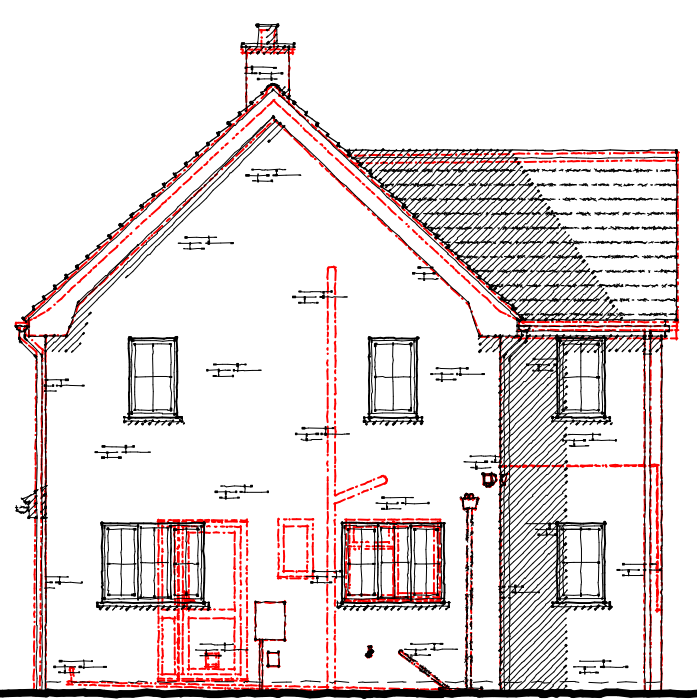

SIDE ELEVATION

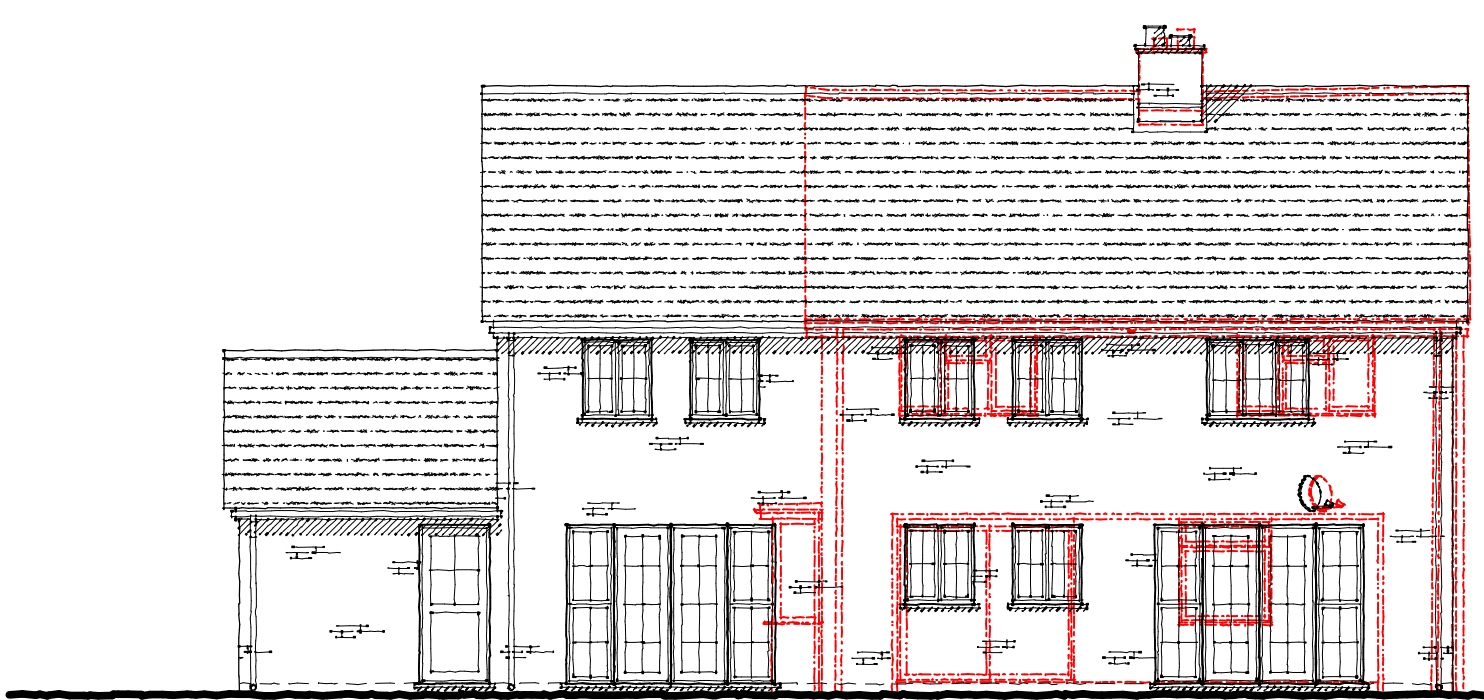


REAR ELEVATION

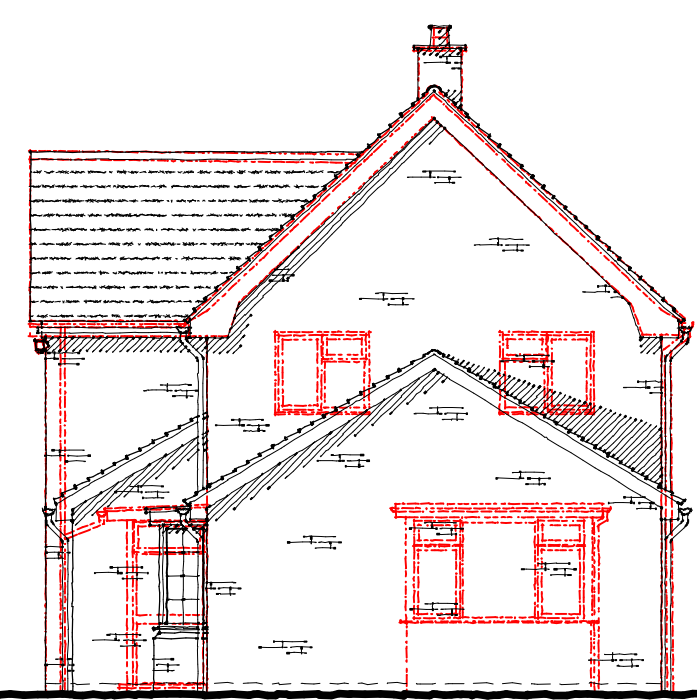


SIDE ELEVATION

Revision	Description	Drawn	Checked	Date
Preliminary	Information	Tender	Construction	As Built

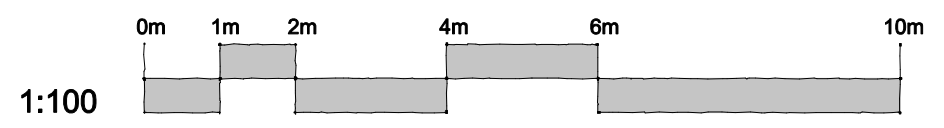

1:100

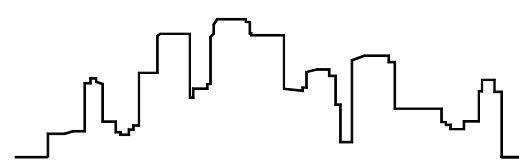

Woods Hardwick

Architects, Engineers and Development Consultants

15-17 Goldington Road
Bedford
MK40 3NH
United Kingdom
T. +44 (0)1234 268862
F. +44 (0)1234 353034
mail@woodshardwick.com
www.woodshardwick.com

Title

Barn Close
Littlehampton

Details

Existing & Proposed
Plans & Elevations Overlay

Scale

1:100@A2

Date

OCT 2017

Drawn

S.A

Chk

T.F

 Please consider the environment before printing this drawing

17808/102