


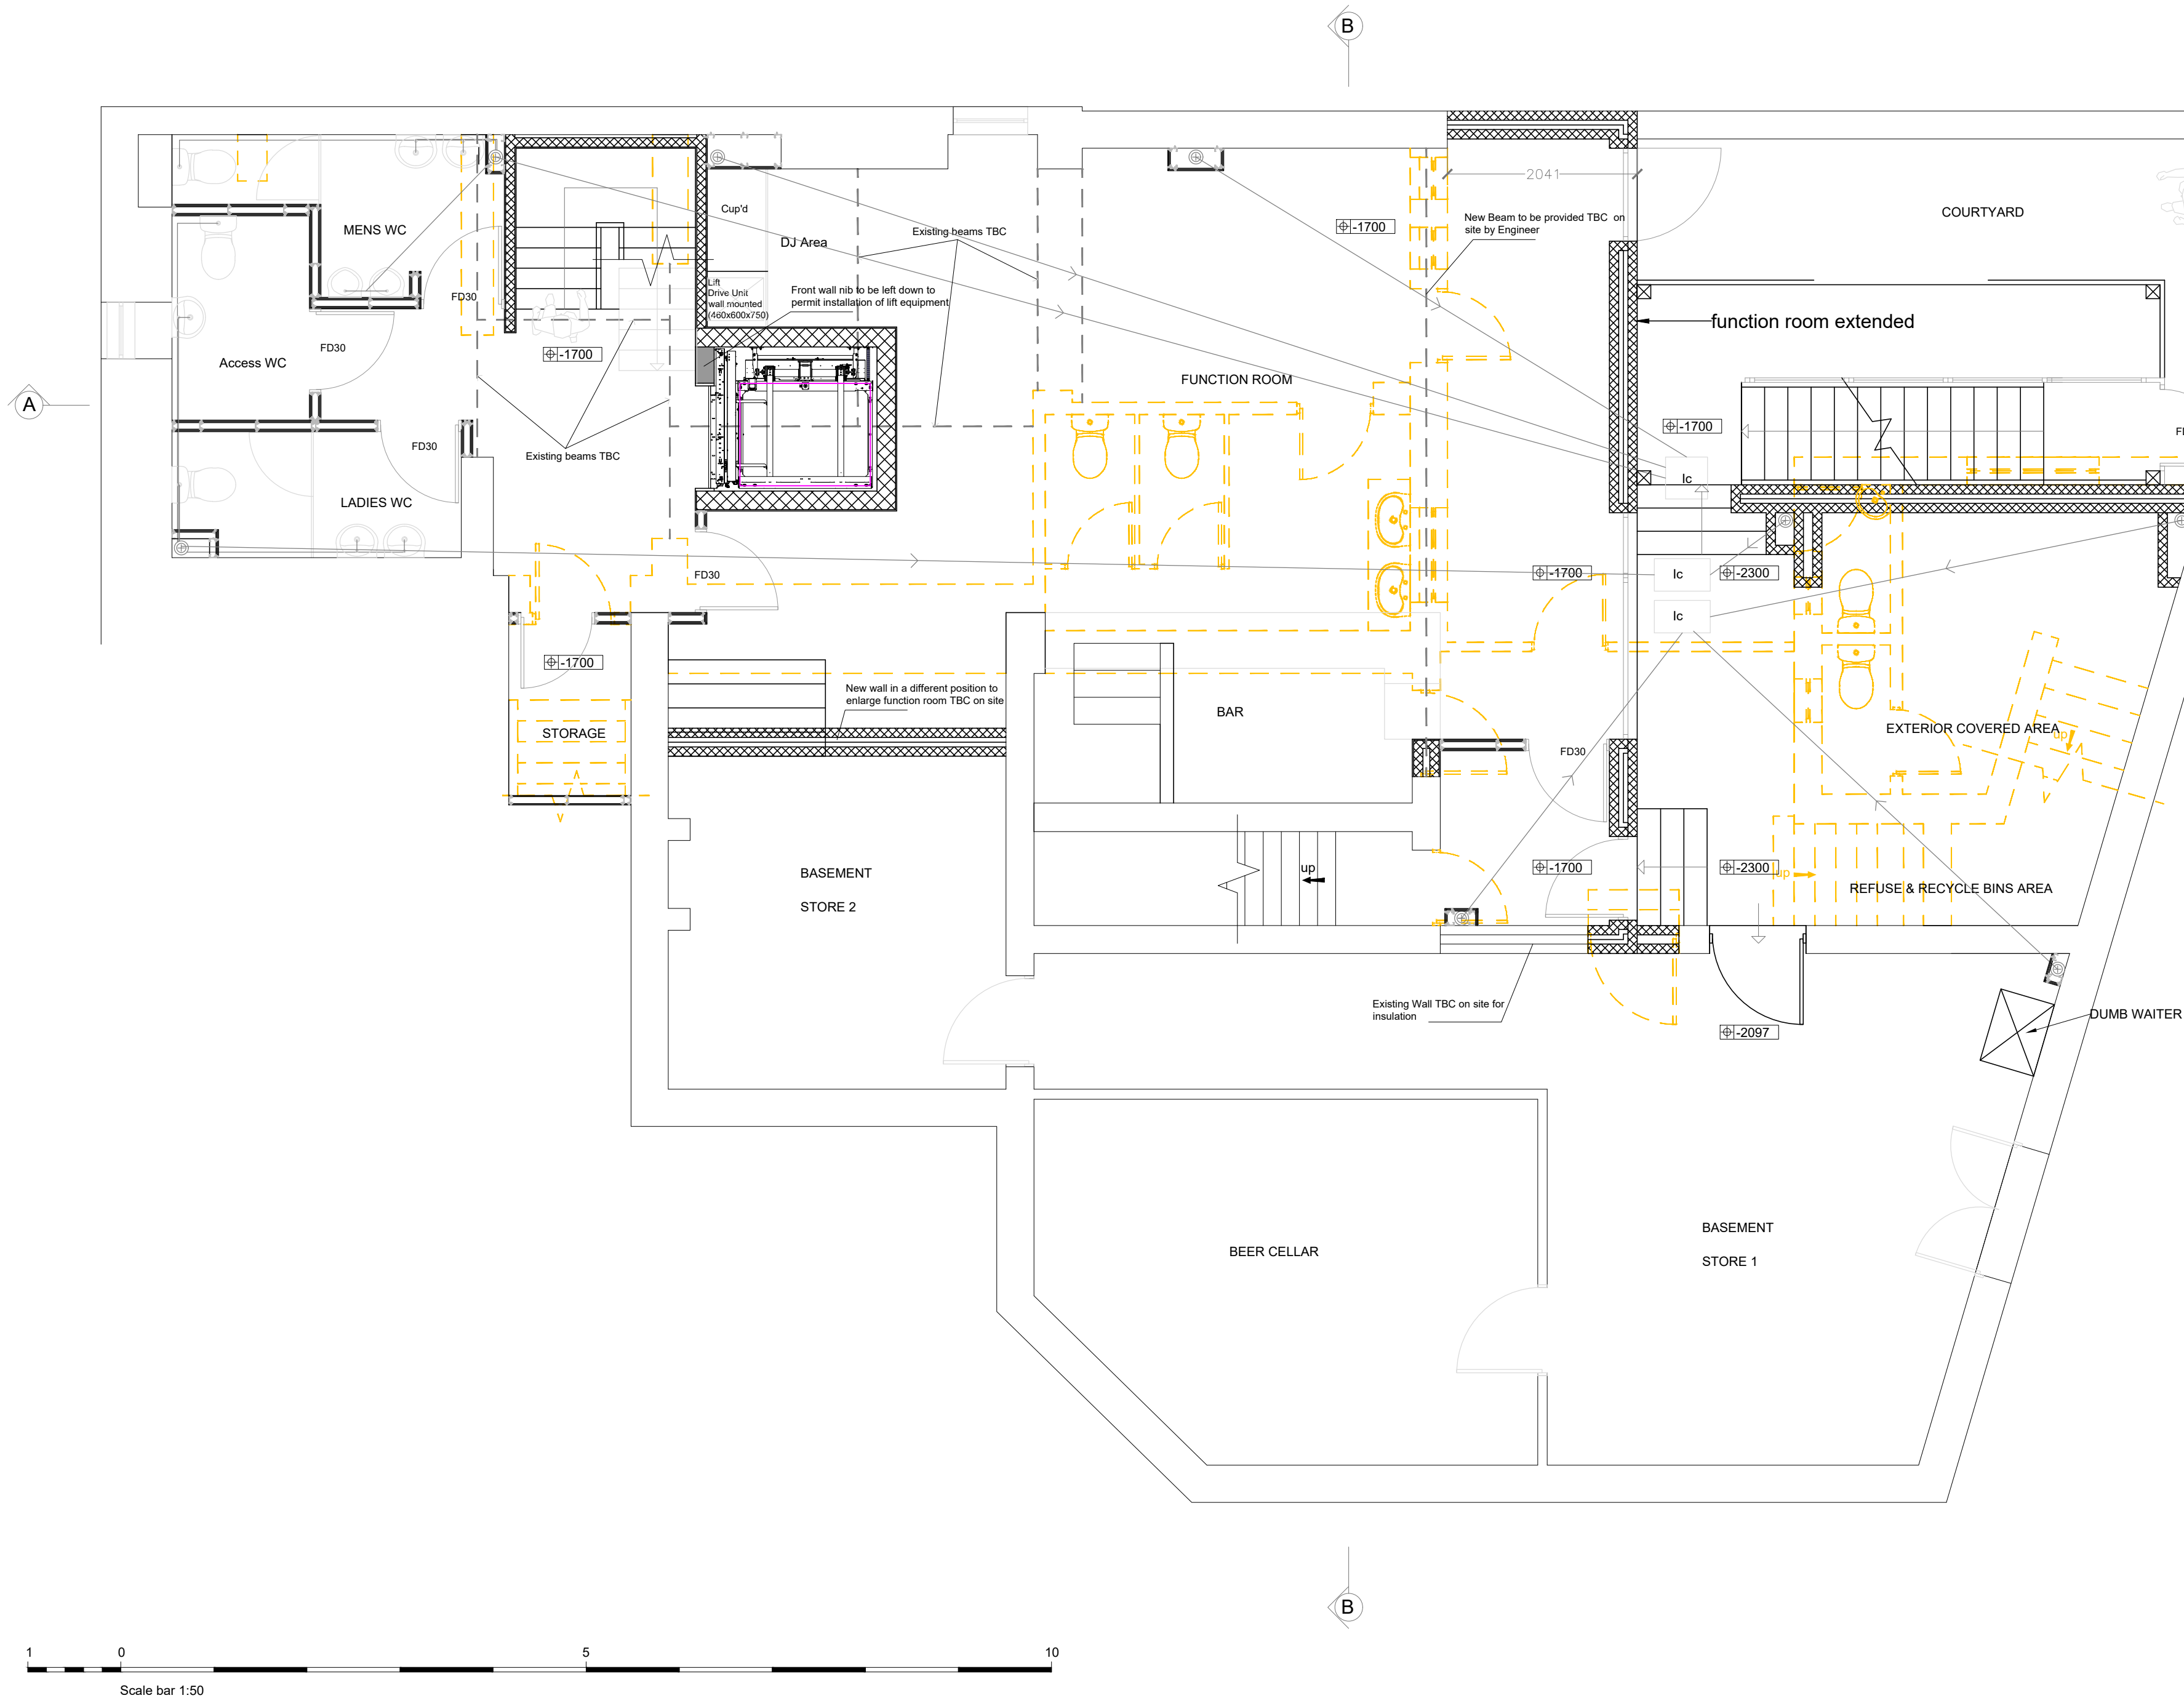

Dimensions & Scales
Do not scale off this drawing unless for Local Authority purposes. The Contractor is responsible for checking all levels, site dimensions etc. prior to ordering materials and starting work on any element.

Any discrepancies or anomalies should be brought to the attention of the designer prior to commencement of the works.

Rev.	Details	Date

Liz Galloway
Design & Health & Safety
Consultancy

41 Willowhayne Avenue
East Preston
West Sussex
BN16 1PL

01903 859176
liz@lizgalloway.co.uk

Issued for:
Discussion
Planning Application X
Building Control
Construction Issue
As Built

Proposed Basement

Client
Site Address
The Nelson
Pier Road
Littlehampton
West Sussex
BN17 5LP

Mr & Mrs Stojanovski

Printed
Date
Drawing Number

As Shown on A2
18/01/22
15219/02a