
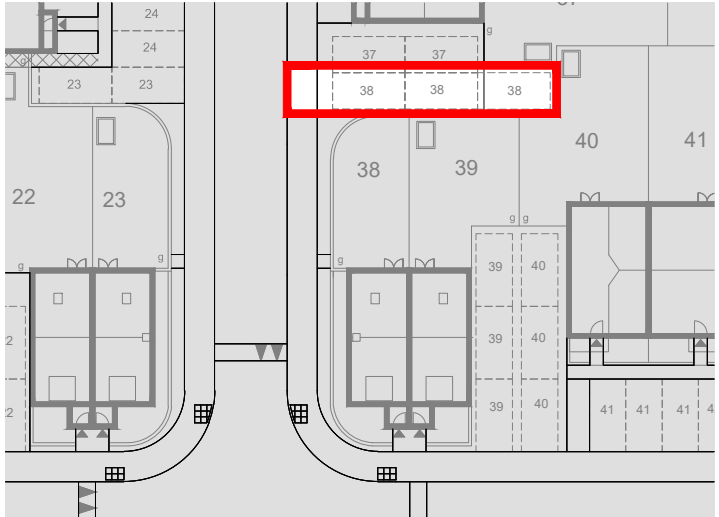


EXISTING APPROVED 126 UNIT SCHEME
CURRENTLY UNDER CONSTRUCTION

able Discharge=
es / Second

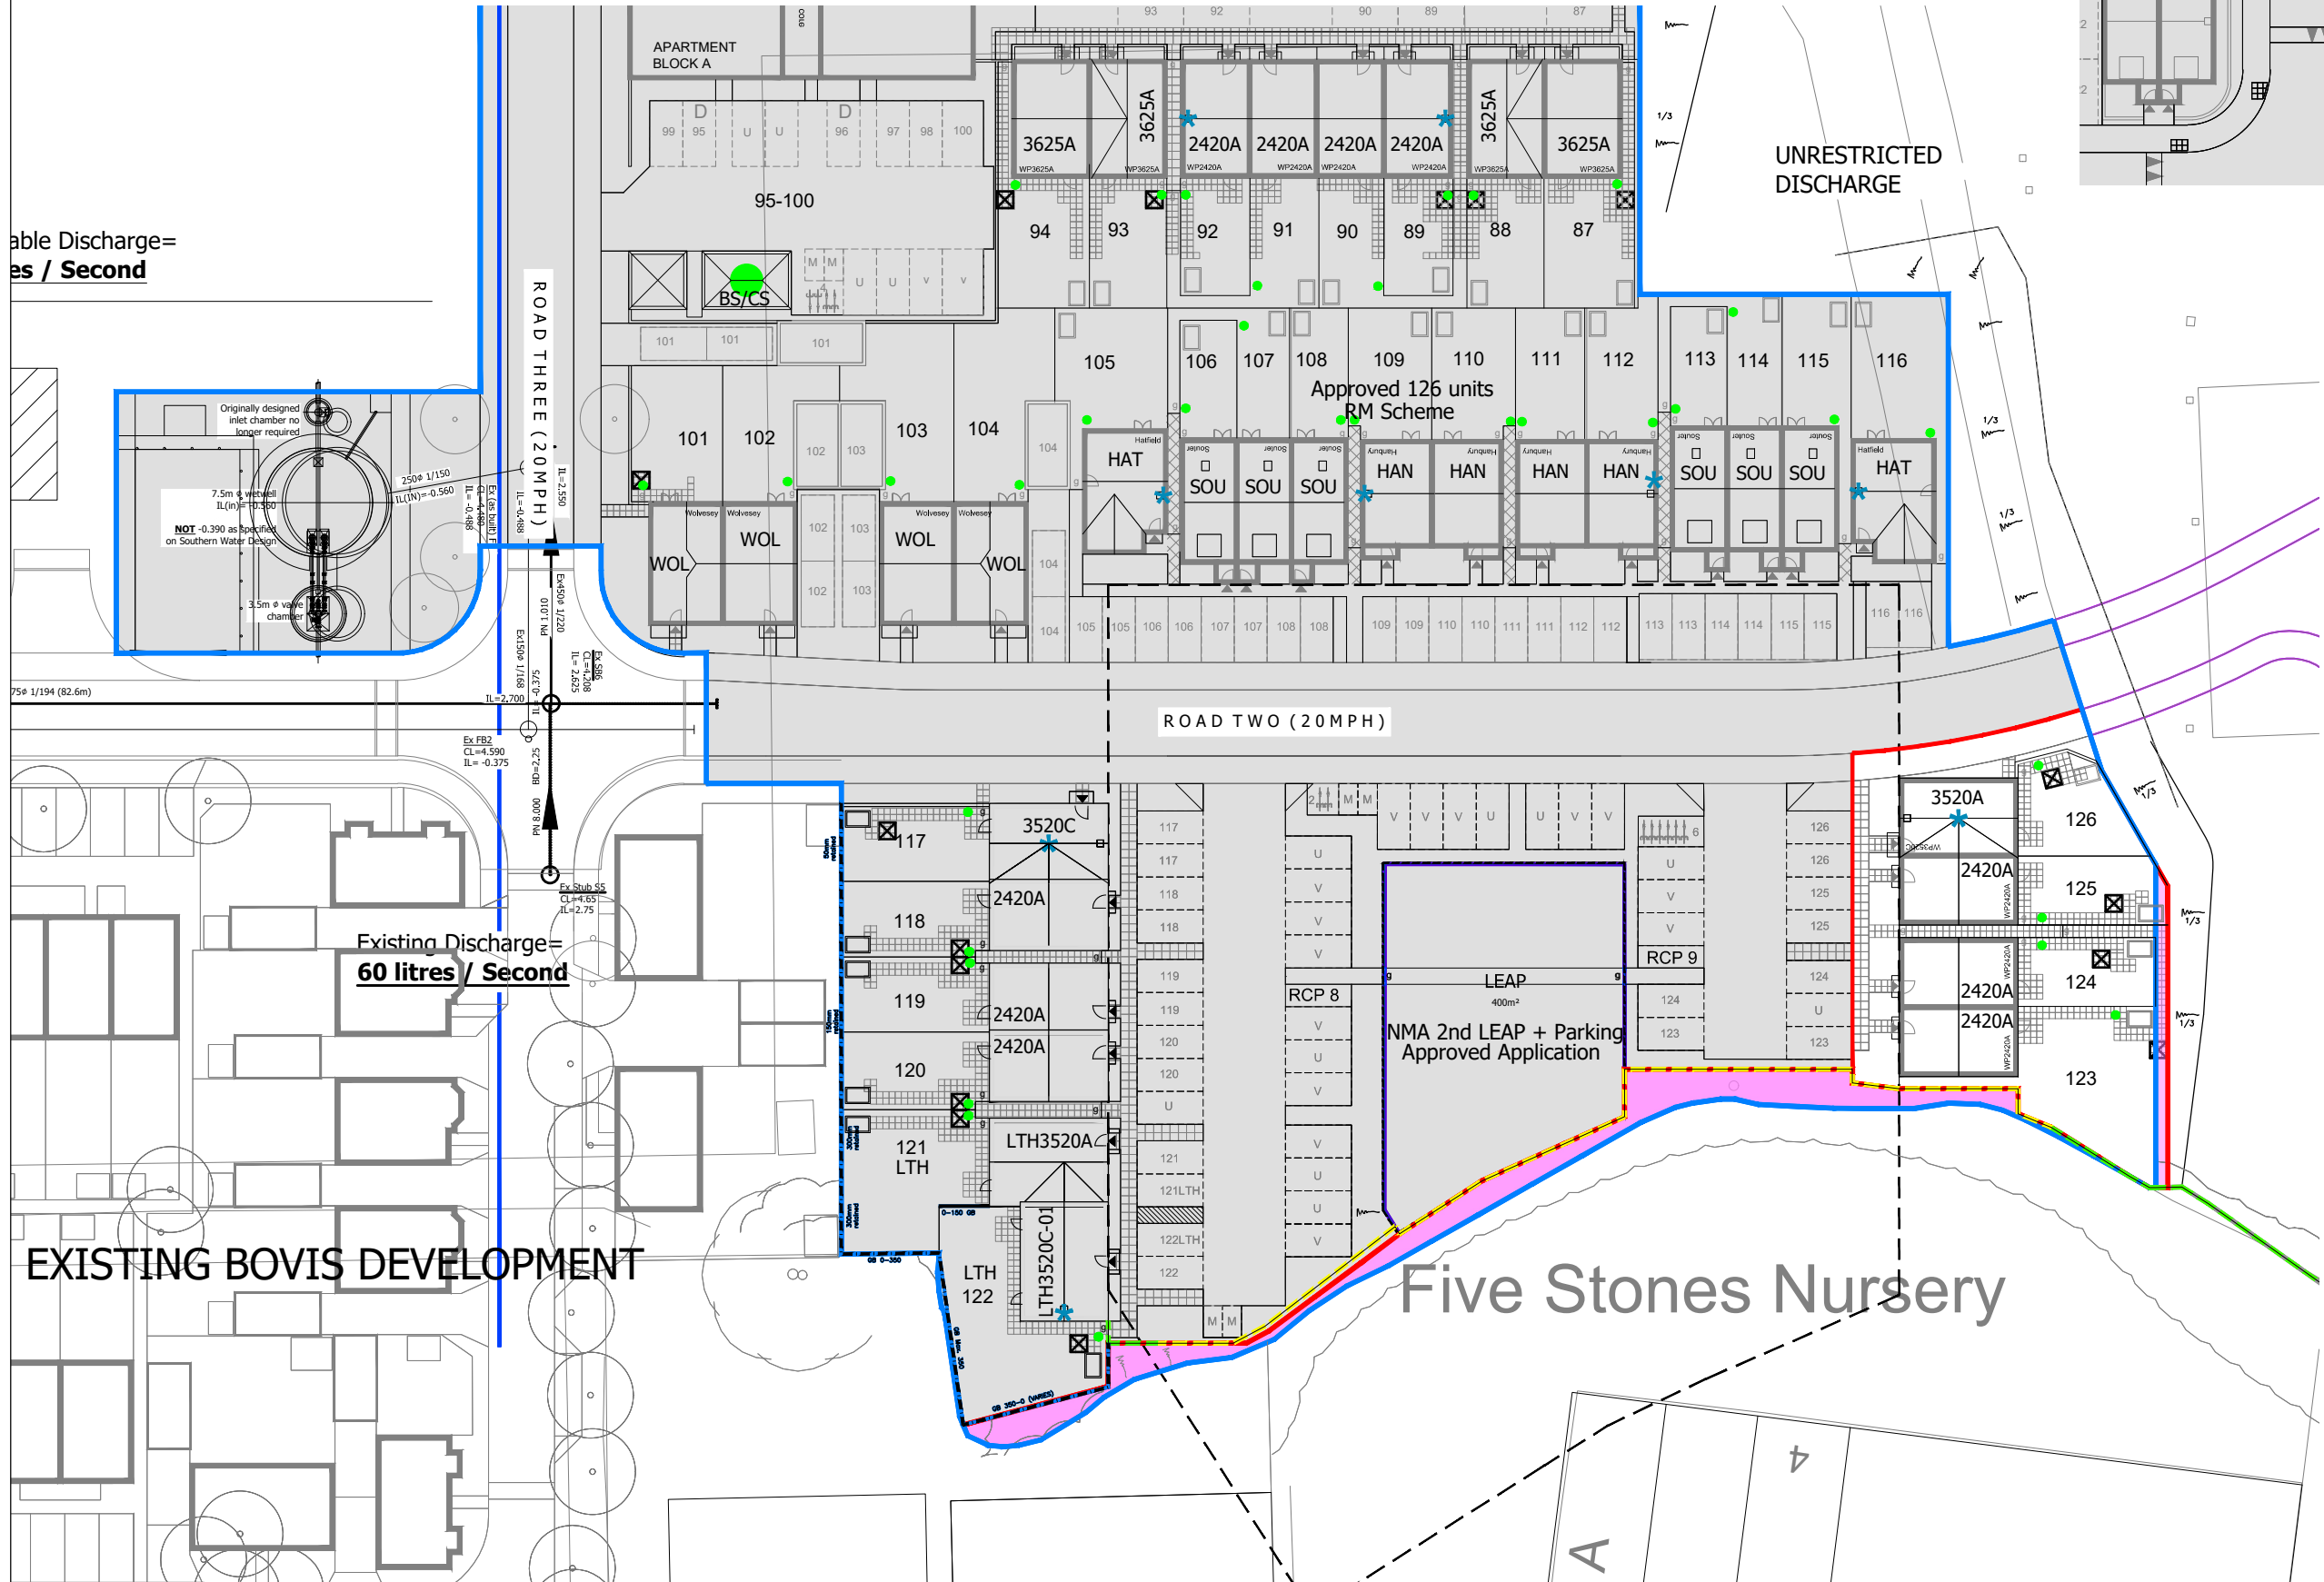

LEGEND

- Proposed 3rd NMA Application Boundary
- Redline Boundary
Pink hatched area indicates Revised boundary lines to rationalise southern edge in relation to levels and retaining wall/acoustic fence requirements.
- Approved LU/121/17/RES Application Boundary
- Location of Proposed 2.8m Acoustic Fence on retaining wall.
- Location of Proposed 2.8m Acoustic Fence
- Location of required gravel board - as per Engineer's details
- Areas already Approved.



Scale
1:500

-	-	-
-	-	-
-	-	-
Rev		Date
PERSIMMON Together, we make a home		
Persimmon Homes Thames Valley Persimmon House, Knoll Road, Camberley, Surrey GU15 3TQ Tel: 01276 808080		
Site:	Date:	
Phase 2 Littlehampton	Jan. 2021	
	Scale:	1:500 @ A3
	Org No:	543_PL_APP3_100
Drawing Title: 3rd NMA Application Site Layout - Plots 123 - 126 & Ancillary		
Drawing Status:	Drawn by:	Checked by:
SUBMITTED	AT	ME/RC
	Rev:	-