


EXISTING APPROVED 126 UNIT SCHEME
CURRENTLY UNDER CONSTRUCTION

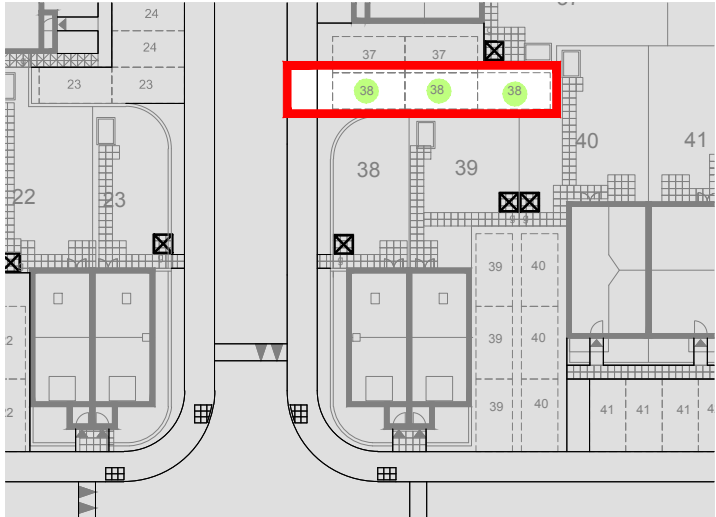

LEGEND

- Proposed 3rd NMA Application Boundary
- Redline Boundary
Pink hatched area indicates Revised boundary lines to rationalise southern edge in relation to levels and retaining wall/acoustic fence requirements.
- Approved LU/121/17/RES Application Boundary
- Areas already Approved.

LEGEND - PARKING ALLOCATION

- Allocated Parking
3 of 256 spaces total for whole site
- Allocated Garage
0 of 7 spaces total for whole site

Total of 301 parking spaces on site
(301 spaces required - see WSCC car parking demand calculator)



Scale
1:500

-	-	-
-	-	-
-	-	-
Rev		Date
PERSIMMON Together, we make a home Persimmon Homes Thames Valley Persimmon House, Knoll Road, Camberley, Surrey GU15 3TQ Tel: 01276 808080		
Site:	Date:	
Phase 2 Littlehampton	Jan. 2021	
	Scale:	1:500 @ A3
	Org No:	543_PL_APP3_105
Drawing Title:		
3rd NMA Application - Parking Strategy Site Layout - Plots 123 - 126 & Ancillary		
Drawing Status:		Drawn by: AT Checked by: ME/RC
SUBMITTED		Rev: -

