


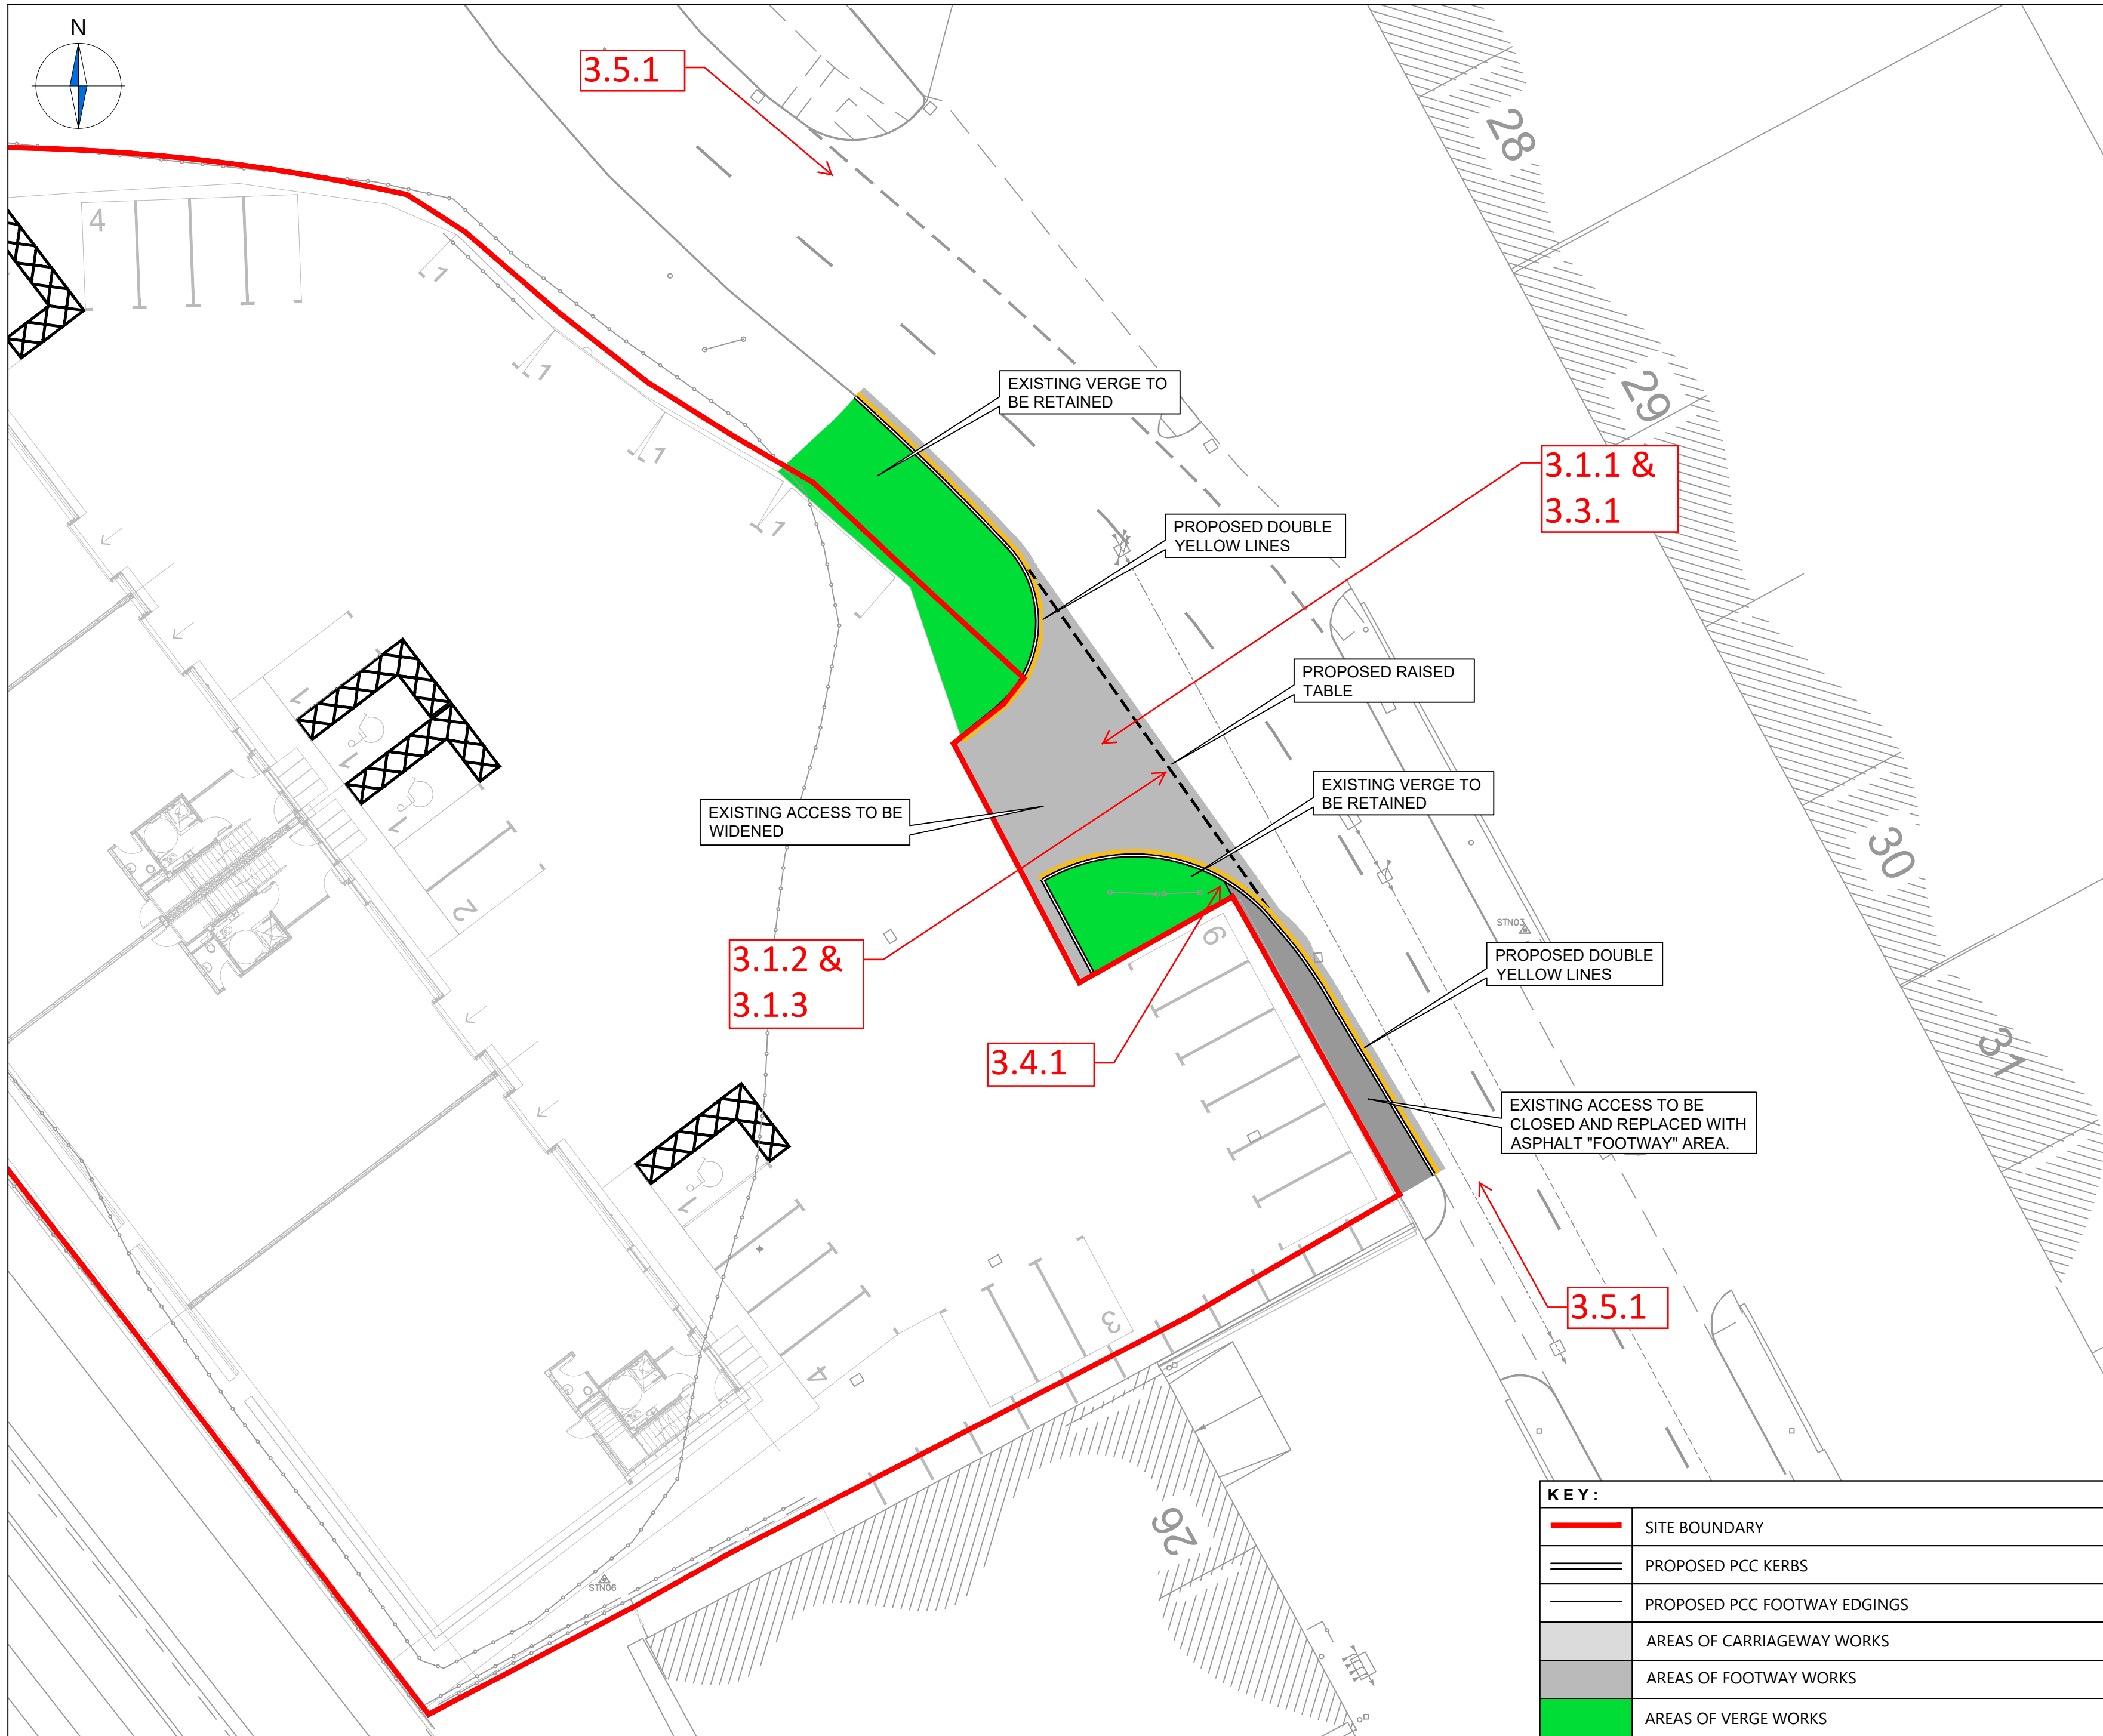

NOTES

- GENERAL**
- Do not scale from this drawing.
 - This drawing to be read in conjunction with other contract drawings.
 - This drawing to be read & printed in colour.

- CONSTRUCTION**
- Works shall comply with the current Department of Transport Specification for Highway Works.
 - All inspection covers / service valve covers to be raised / lowered to suit proposed levels.

- CDM (RISKS & HAZARDS)**
- Prior to commencement of construction the contractor is to liaise with all relevant statutory undertakers and protect / divert apparatus and to protect the workforce during the works. Any damage caused to the apparatus to be the responsibility of the contractor.
 - Contractor to undertake their own statutory plant checks on site prior to the commencement of excavation exercise.
 - The contractor is to make sure that any excavation should be adequately covered at night to protect both public and wildlife from becoming trapped.

- DISCLAIMERS**
- The topographical survey information has been provided by *Malcom Hollis (Drg No.75625-MHL-00-Z0-M2-G-10100-A7-A)*, and Caneparo Associates shall not be liable for any inaccuracies or deficiencies.
 - All works to be carried out in accordance to DMRB, West Sussex County Council Standard Detail Drawings and Engineers Satisfaction.
 - All road marking and signs to be to the approval of West Sussex County Council.

Rev	Details	Drawn	Checked	Date
REVISION HISTORY				
Status:	☐ Preliminary ☐ For Approval ☐ For Construction			
	☒ For Information ☐ For Tender ☐ As Built			

Client:
Legal and General Assurance Ltd

Project:
Lineside Industrial Estate

Drawing Title:
**S278 Highway Works
Proposed General Arrangement**

Scale: 1:200 Size: A2

Drawn by: AFG Checked by: RB Date: 22.07.2019

CANEPARO ASSOCIATES
Transport Planning & Highway Design
21 Little Portland Street • London • W1W 8BT • Tel. 020 3617 8200

Scheme Ref: 3548 Drawing No: 100 Sheet: 1 of 1 Rev: ...