



Site plan 1:500

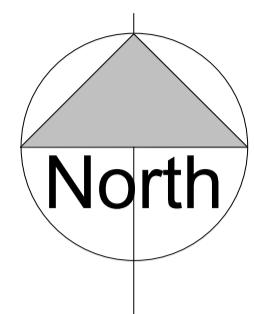

Site plan 1:1250

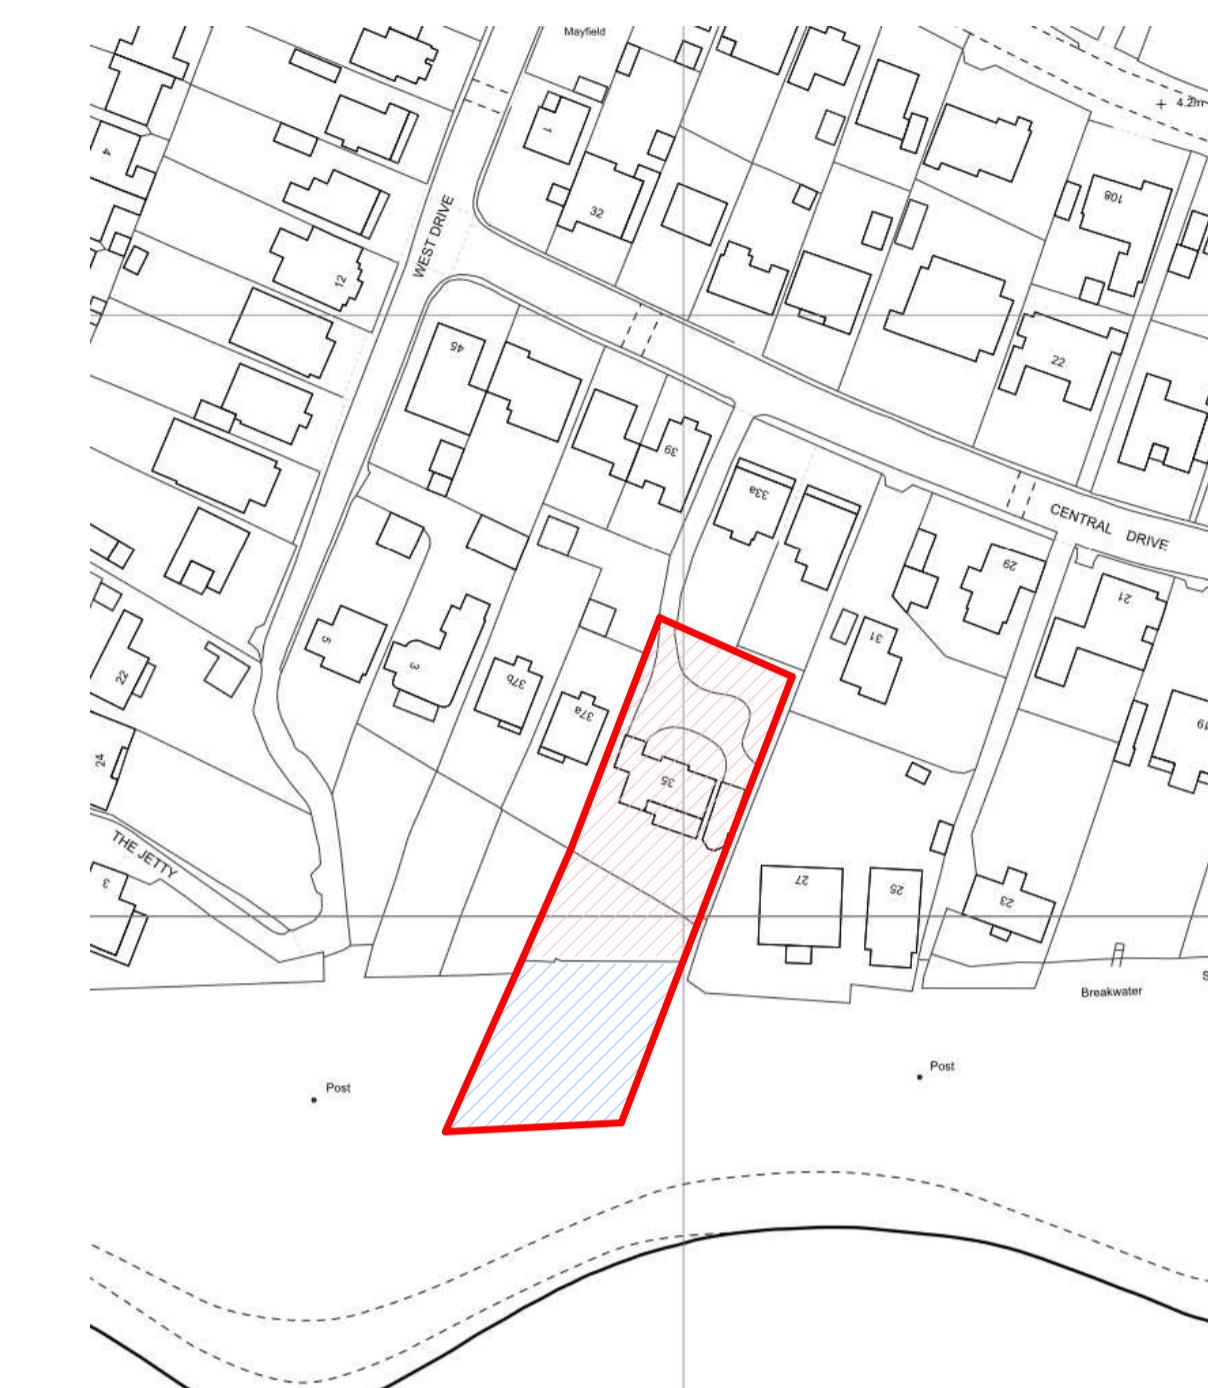

Revisions	
5	0
10	15
20	25
SCALE 500	m
10	0
20	30
40	50
SCALE 1250	m
1:	
Materials	
Drawing Number 2024/161 Sheet 1 of 1	
Size A1 Scale 1:500, 1:1250	
Project As built details October 2024	
Job Title Sea Willow Elmer Bognor Regis PO22 7TT	
Do Not scale from this drawing except for planning as photocopies will be subject to distortion. Drawings to be read in conjunction with all other Designers and structural engineers contract drawings and specifications: Any discrepancies must be brought to the attention of the Designer immediately. The contractor must verify all dimensions by site measurement before ordering materials or manufacturing components. Substitute materials and products to those named will be acceptable if proven to be of equal or higher performance and not in conflict with other elements	
M.J.Humphrey Ltd	
 RICS  cabe chartered association of building engineers	
Mel Humphrey MRICS, MBEEng Adam Humphrey 9 Aldsworth Avenue 4 Thalassa Road Goring By Sea Worthing West Sussex West Sussex BN12 4XQ BN11 2HH	
Mel@mhumphrey.co.uk Adam@mjhumphrey.co.uk 07701055182 07812419142	