
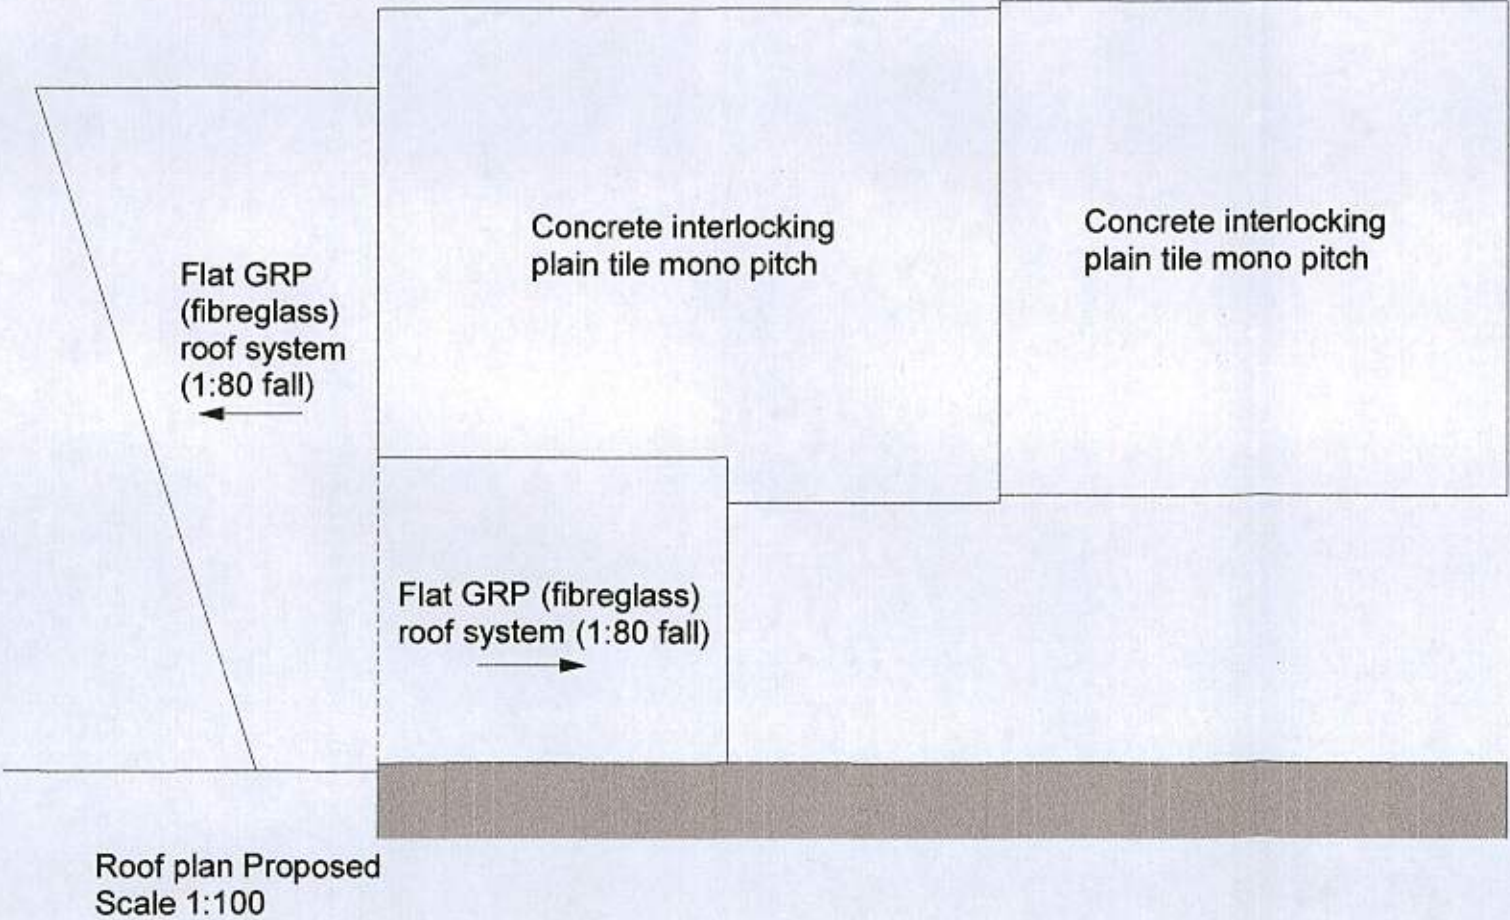


Notes:
 During original submission P/112/14/HH
 a public foul rising main sewer was found
 located across the proposed extension. The
 resubmission alters the extension to ensure the
 building is outside the 3m restriction zone.
 Actual location found on site, see report
 ABPS01.

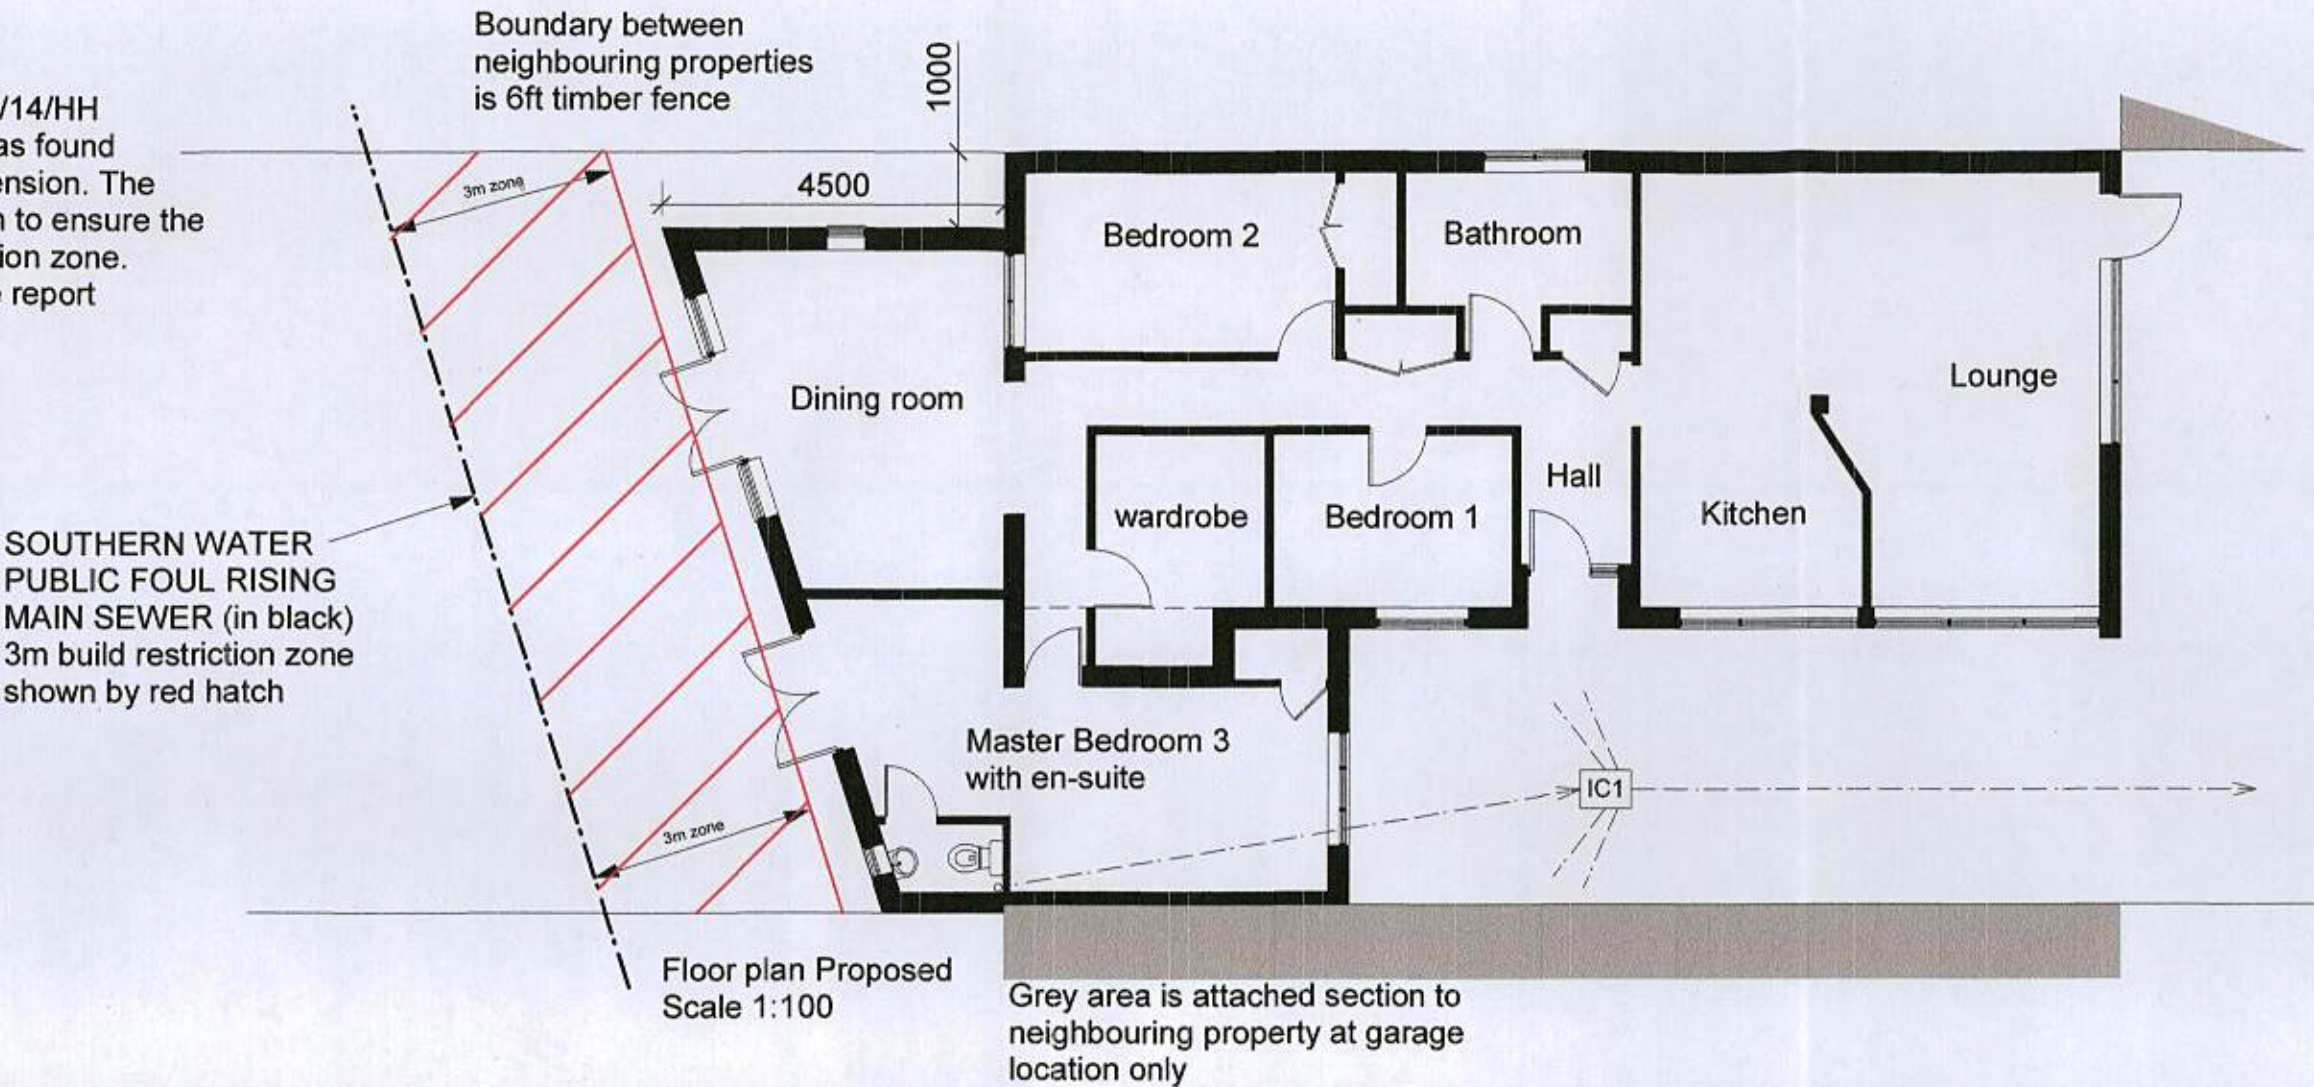

All dims and details to be checked on site prior to any commencement of work. This plan is not a full specification or schedule of work and has been produced solely for the purpose of obtaining the necessary local authority consents/approvals. For Party Wall etc. Act 1996 see ODPM booklet or website.	Status:			Client: Mr A Bateman 31 Swan Dene Pagham Bognor Regis West Sussex PO21 4UR	Revision: B	Project: Extension
	Preliminary	☐	Tender		Scale: 1:100 @A3	Content: Proposed floor and roof plan
	Planning	☒	Construction		Date:	
	Building Regulations	☐	As Built		Dwg No: A8004	