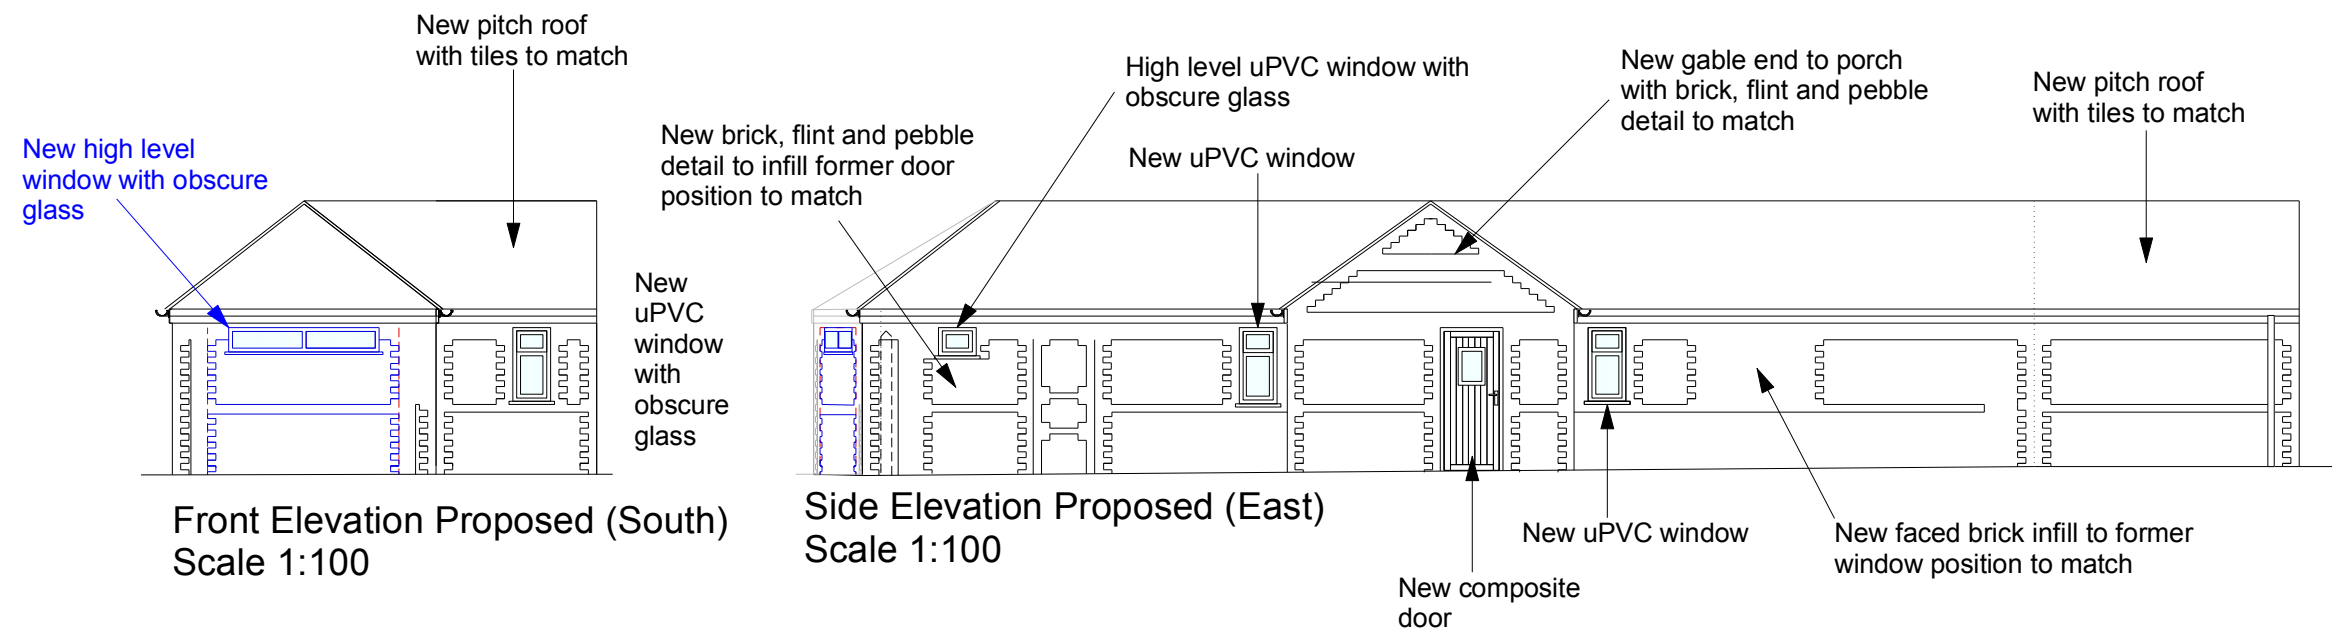


Non Material Amendment application notes:
 1. Change of doors to window and matching brick, flint and pebble detail arrangement on the Front Elevation Proposed, shown in blue line for clarity. The red dotted line outlines the former timber door position.

Non Material Application - P/119/20/HH

All dims and details to be checked on site prior to any commencement of work. This plan is not a full specification or schedule of work and has been produced solely for the purpose of obtaining the necessary local authority consents/approvals. For Party Wall etc. Act 1996 see Government booklet or website.	Status:		Client: Zoe Ireland 8 Church Lane Pagham Bognor Regis West Sussex PO21 4NS	Revision: B	Project: Extensions
	Preliminary	☐ Tender		Scale: 1:50 & 100 @A3	Content: Proposed elevations
	Planning	☒ Construction		Date: Feb 21	
	Building Regulations	☐ As Built		Dwg No: Z1003	