



- NOTES:
1. Do not scale this drawing. Use figured dimensions only, except for Planning purposes.
 2. All dimensions must be checked on site by the contractor prior to commencement of work.
 3. All construction details are indicative and are to be checked and confirmed on site and any divergences are to be agreed with the Contract Administrator.


THIS DRAWING TO BE READ IN-CONJUNCTION WITH THE BUILDING CONTROL AND CONSTRUCTION NOTES

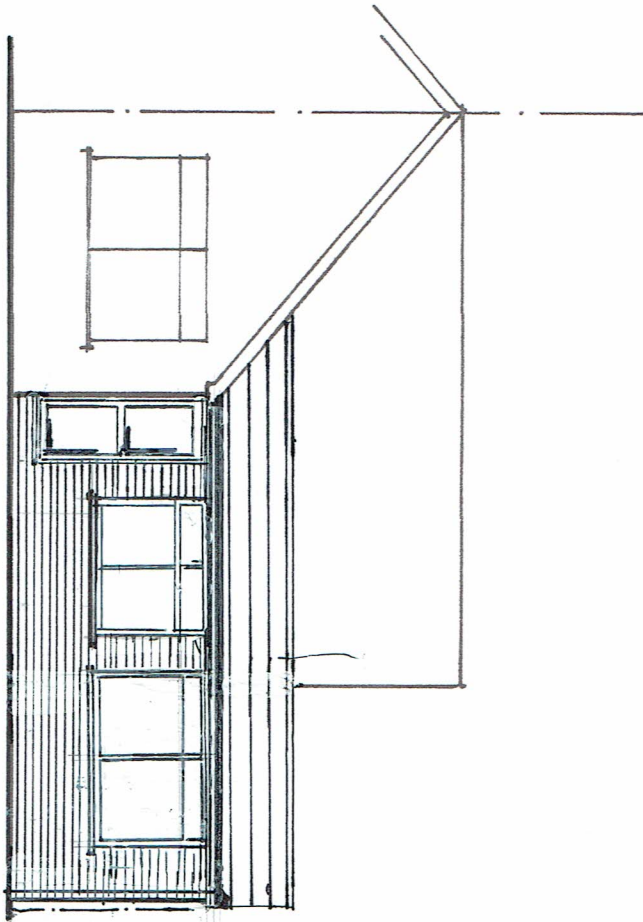


EAST ELEVATION.

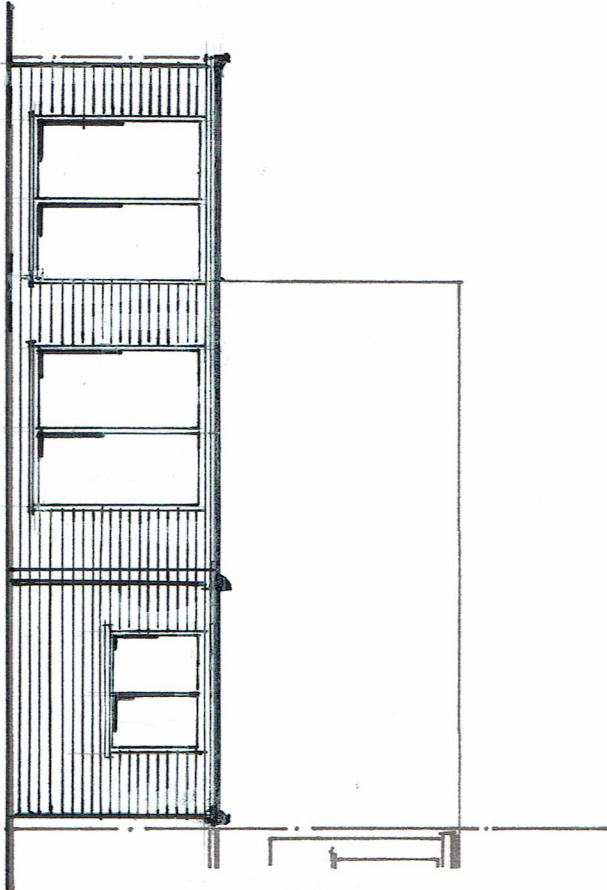

WEST ELEVATION.

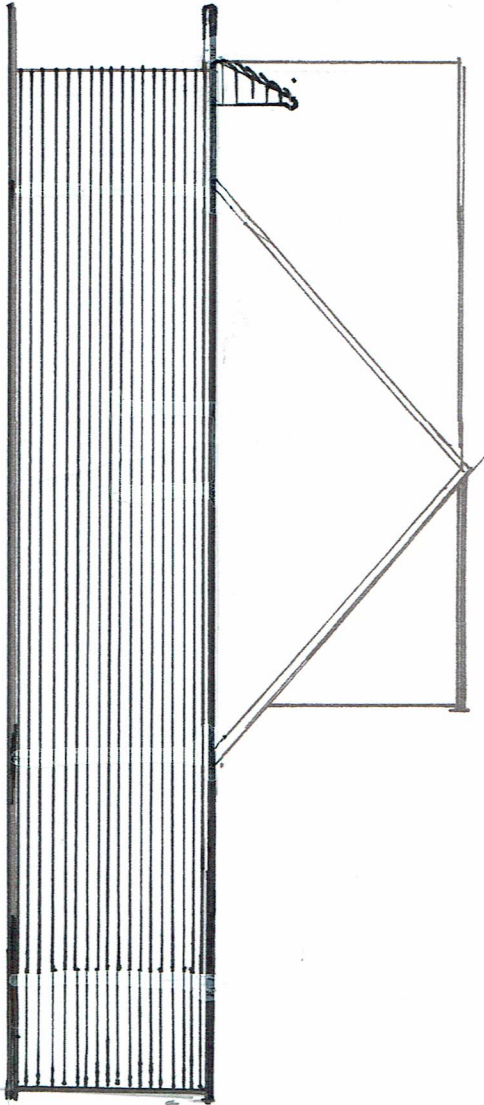

NORTH ELEVATION.

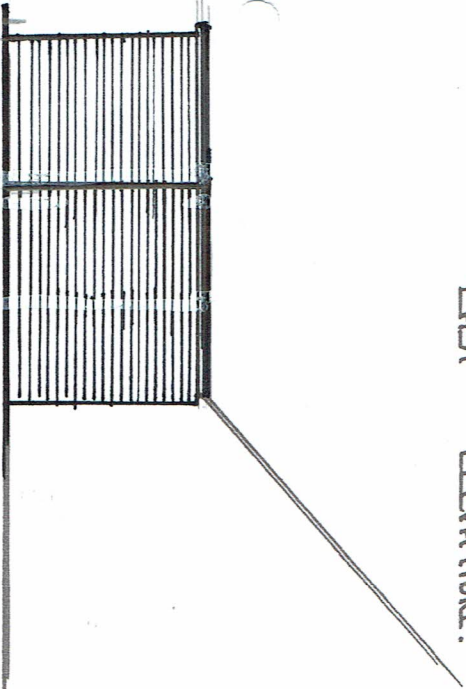

SOUTH ELEVATION.

MATERIALS:-
All New MATERIALS
To MATCH EXISTING MAIN
House.

REV.A. MAT.15. EAST
ELEVATION AMENDED:
REV.B. FALSE ROOF
ADDED.
REV.C. MAY 16
EMERGED EXT. WINDOW
ADDED TO FRONT ELEVATION
LEADS TO PORCH.
REV.D.
AS BUILT. JAN 17

C.R. BARROW & ASSOCIATES LTD.	
Structural & Architectural Technicians	
Studio 1	Tel: 01243 771158
Manor Nursery	Mobile: 07816 581480
Lagness Road	
Chichester	
West Sussex	
PO20 1LJ	E-Mail: chris.barrow@hotmail.co.uk

ELEVATIONS. [As Proposed]	
Scale	1:100
Date	FEB.15
Drawn By	C.R.B.
Checked	
Drawing Number	1194-5
ABC/B	

Extension – 94 Harbour View Road, Pagham, Bognor Regis,
West Sussex, PO21 4RH.