


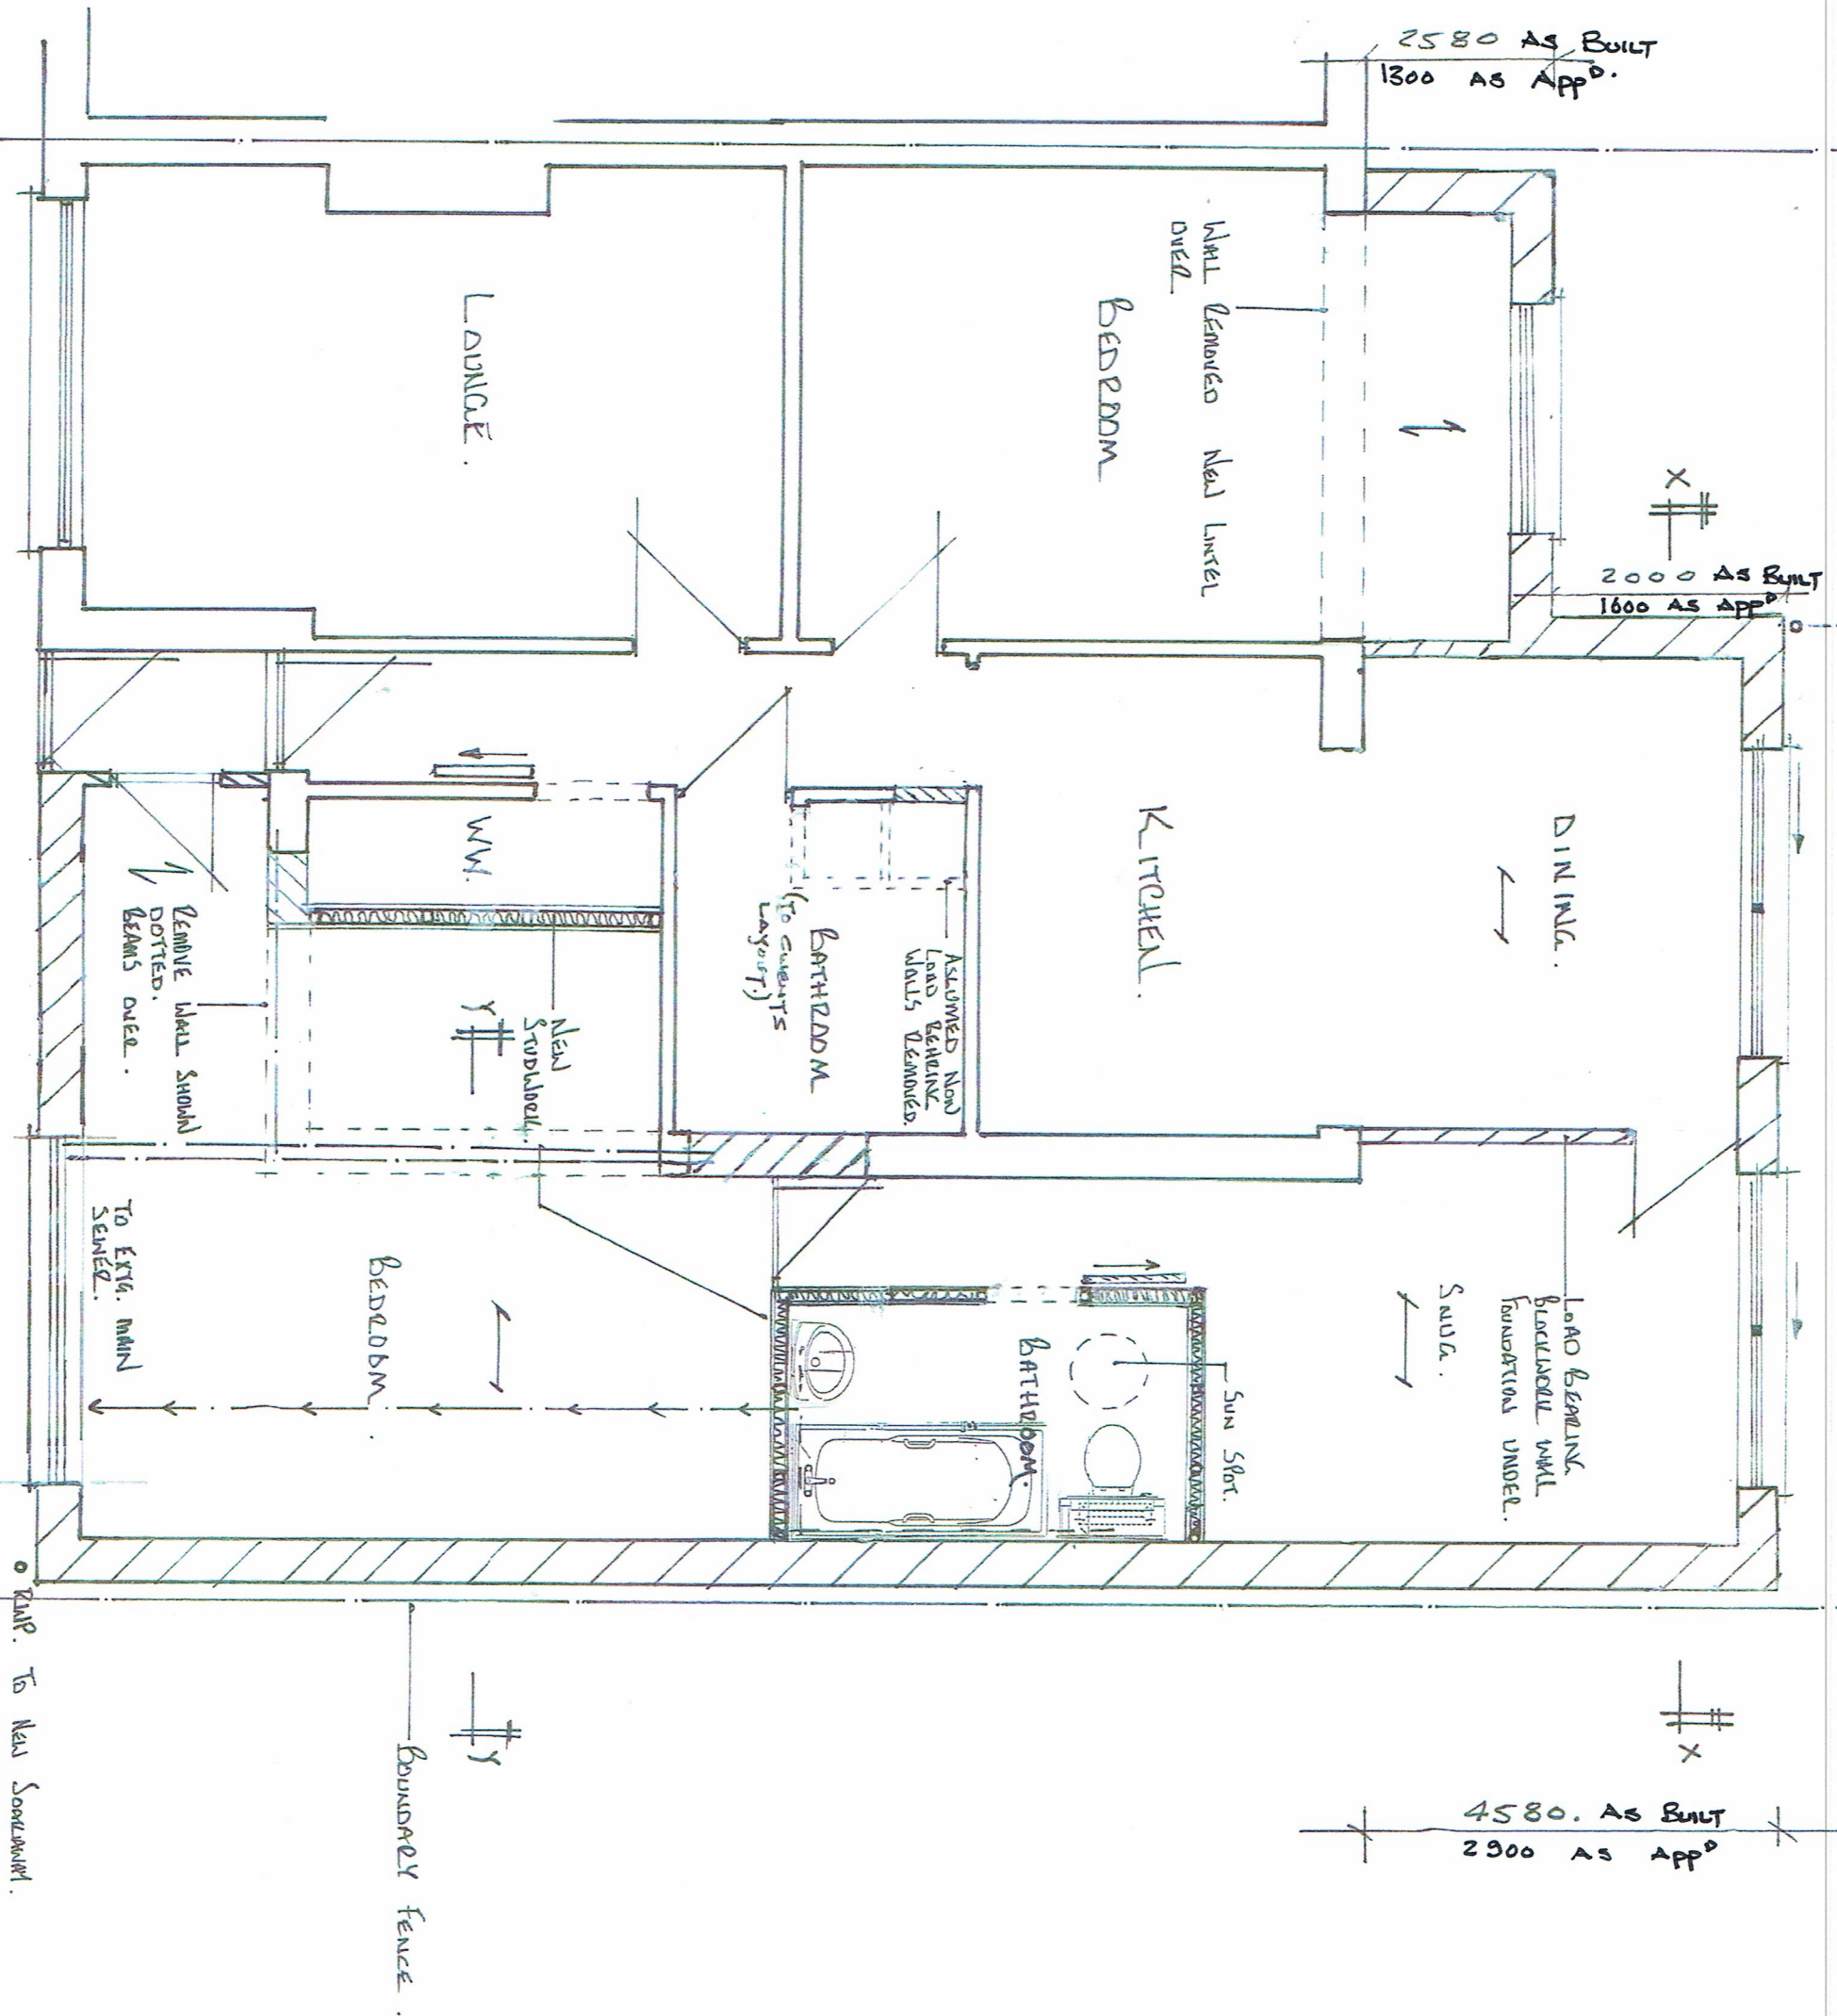

Extension - 94 Harbour View Road, Pagham, Bognor Regis,
West Sussex, PO21 4RH.

NOTES:
1. Do not scale this drawing. Use figured dimensions only, except for Planning purposes.
2. All dimensions must be checked on site by the contractor prior to commencement of work.
3. All construction details are indicative and are to be checked and confirmed on site and any divergences are to be agreed with the Contract Administrator.

THIS DRAWING TO BE READ IN CONJUNCTION WITH THE BUILDING CONTROL AND CONSTRUCTION NOTES

0 10mm 20mm 30mm 40mm 50mm
SCALE BAR

DIMENSIONS SHOWN AS BUILT
WIDTH HAS NOT ALTERED.

Rev. B. Aug. 16 'DIMS' ADDED TO AS BUILT.
Rev. A. MAR 15 'FRONT ELEVATION WINDOW'.

C.R. BARROW & ASSOCIATES LTD.
Structural & Architectural Technicians

Studio 1
Manor Nursery
Lagness Road
Chichester
West Sussex
PO20 1LJ

Tel: 01243 771158
Mobile: 07816 591490
E-Mail: chris.barrow@hotmail.co.uk

Ground Floor Plan.
[As Proposed.]

Scale: FEB. 15'

Date: FEB. 15'

Drawn By: C.R.B.

Checked: A

Drawing Number: 1194-4B

NORTH