


HOUSE B
KITCHEN
GARDEN B



HOUSE A
KITCHEN
GARDEN A

SIDE
GARDEN B


FRONT
GARDEN A

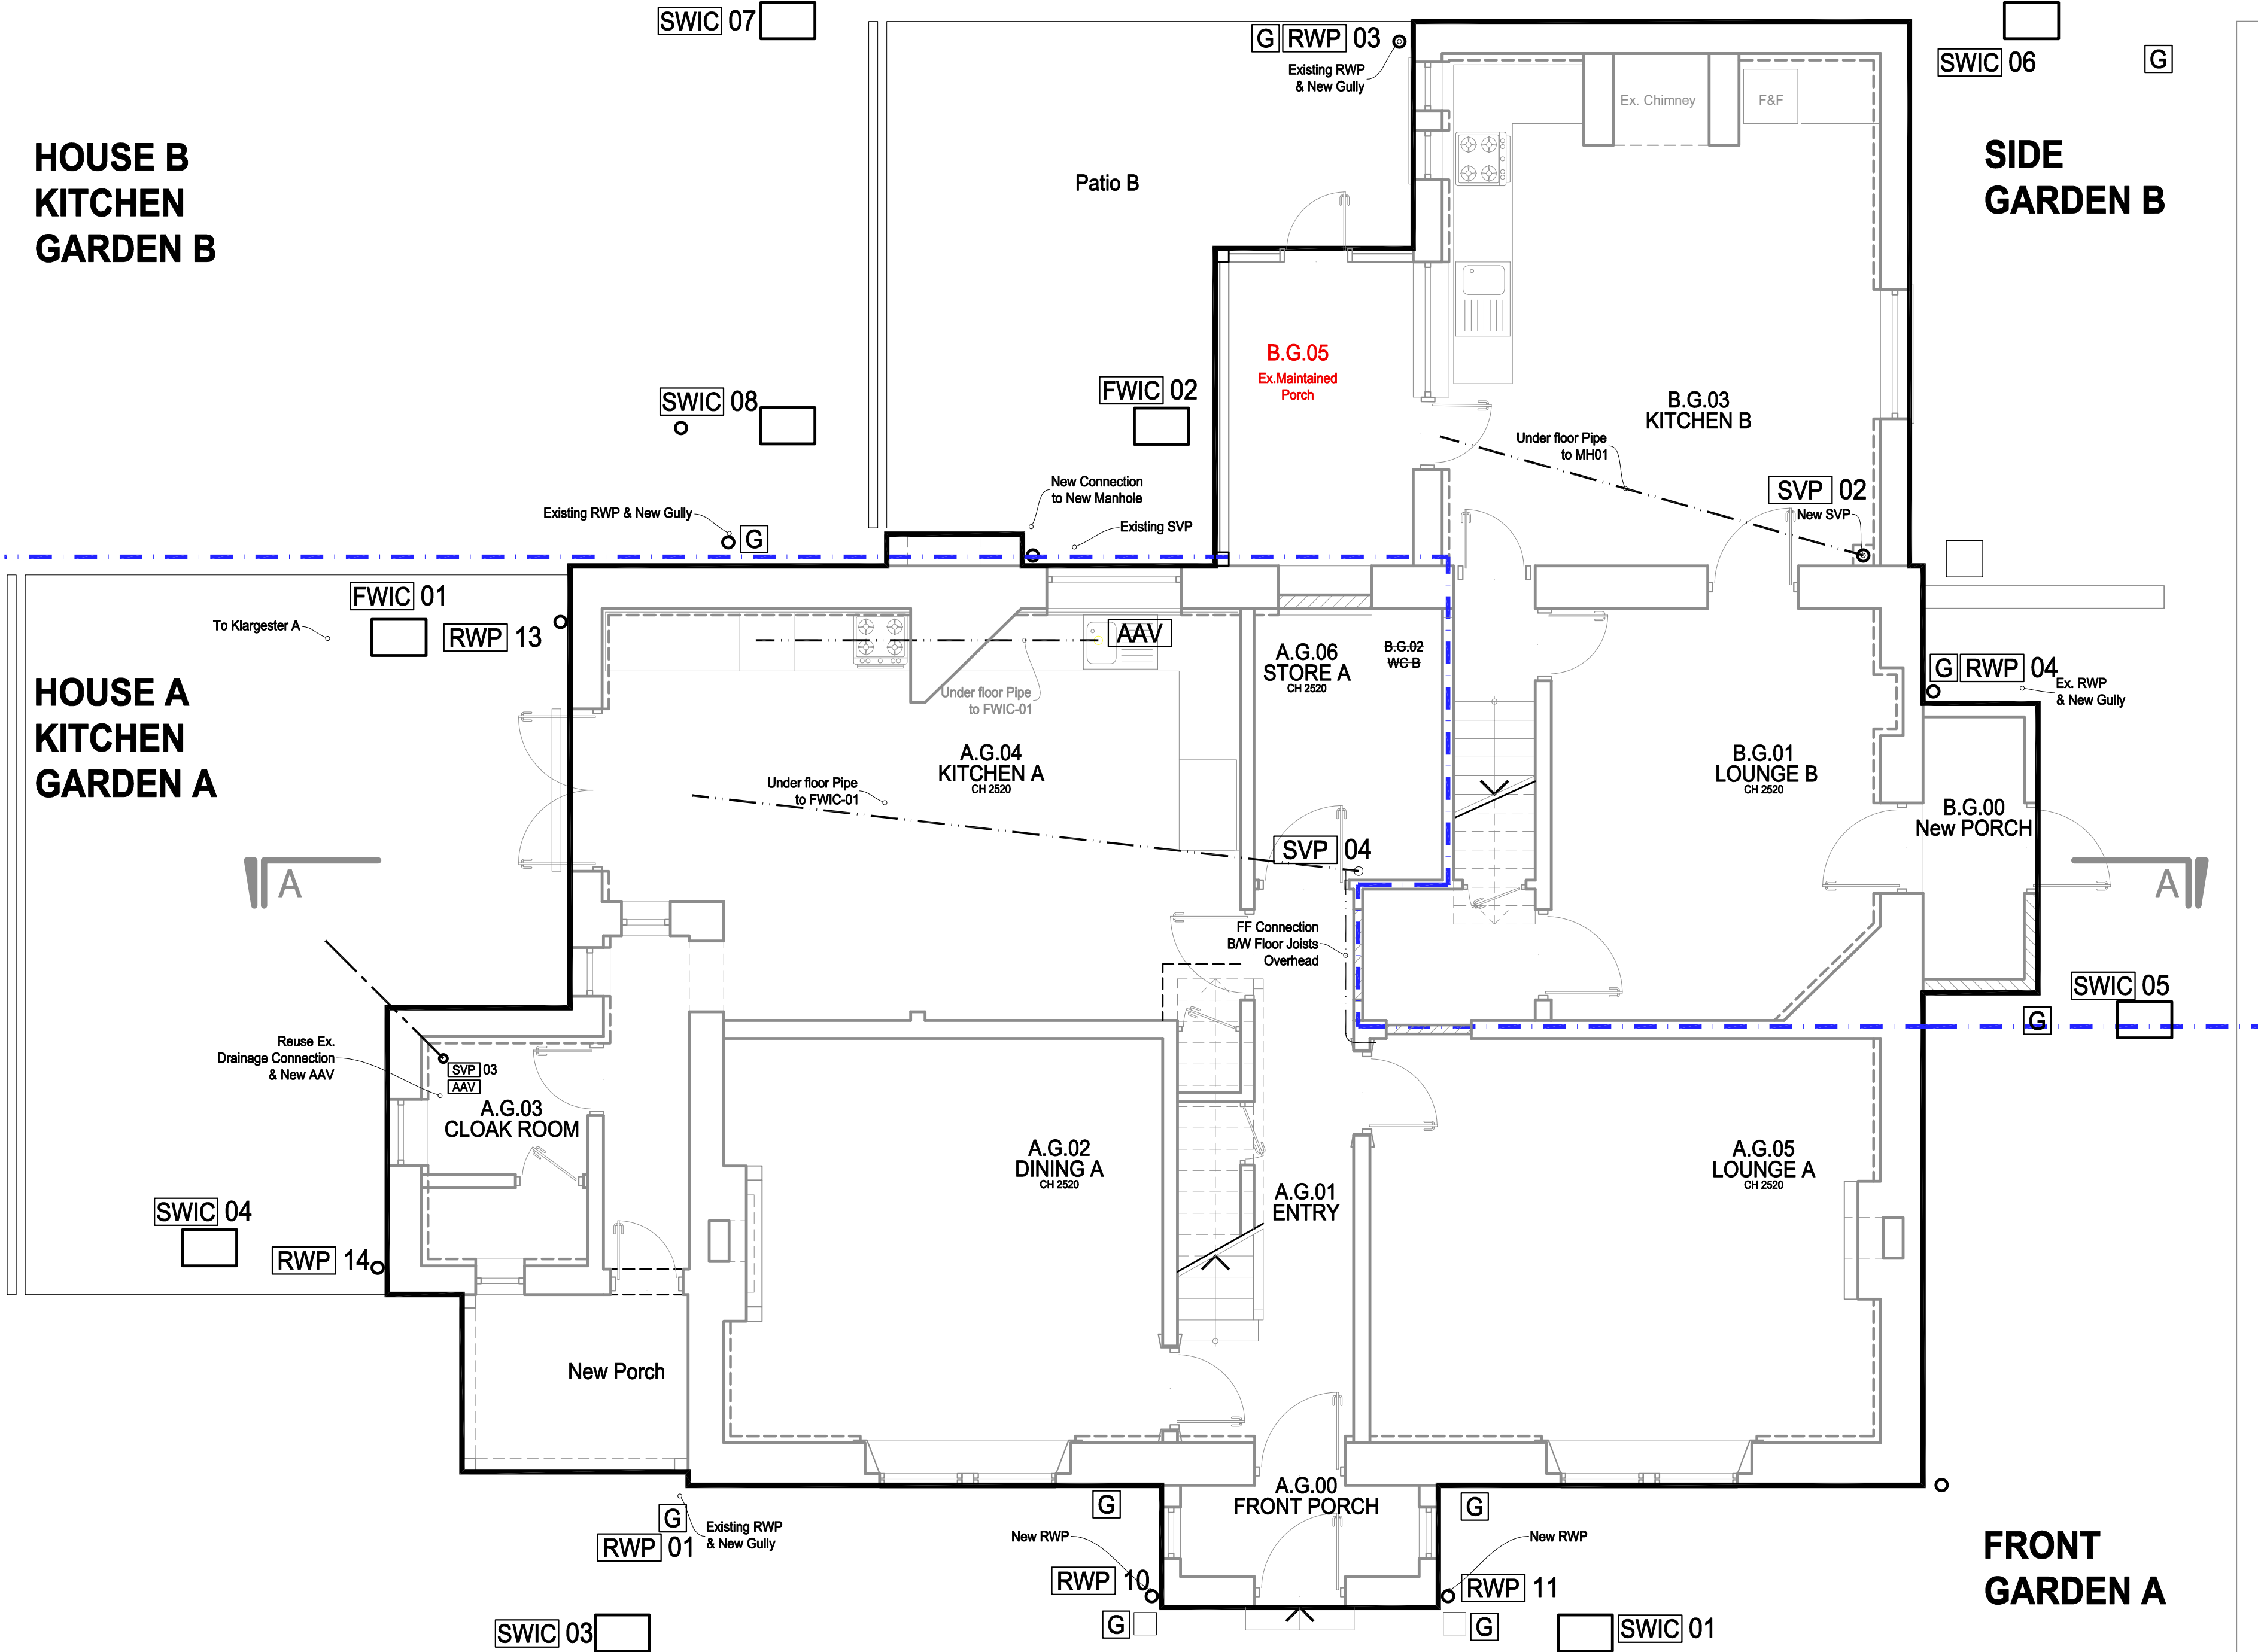

DRAINAGE	PART H
Manhole	[MH]
Gully	[G]
Manhole Cover Level	[Co.Lv.]
Rainwater Pipe	[RWP]
Soil Vent Pipe	[SVP]
Manhole Invert Level	[Inv.Lv.]
Existing	[EX]
Surface Water	
Foul	

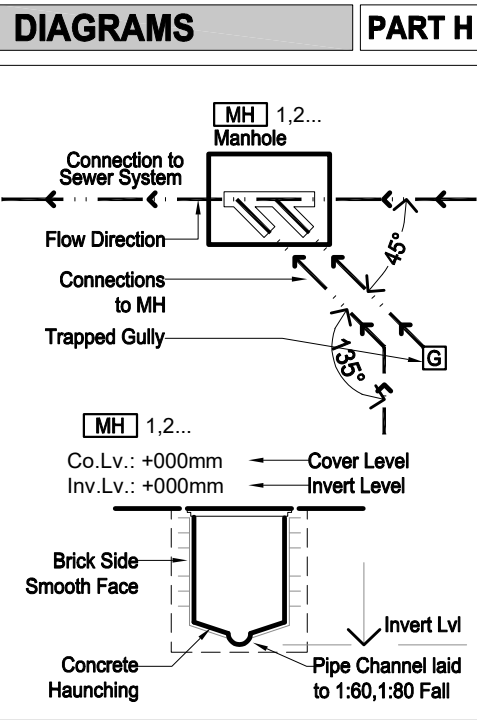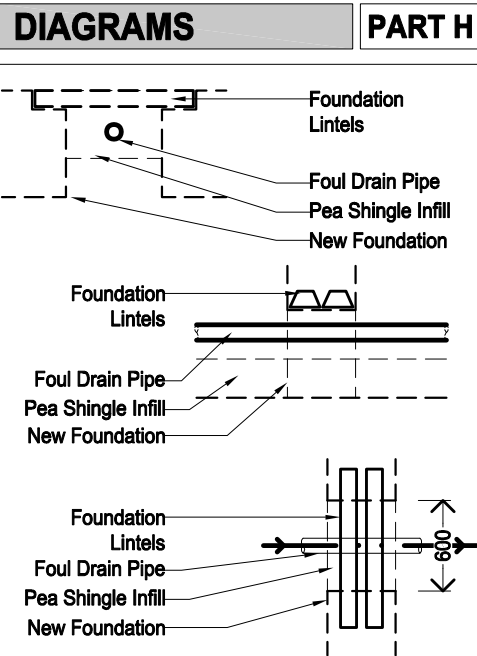

Under Floor & External Drainage
is as per Spilways Design, see:
1451-SPW-Z0-GF-DR-C-6000
Below Ground Drainage - P2

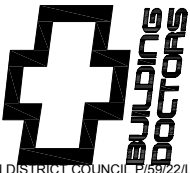

Architect @
Buildingdoctors.co.uk
Office: 137, EN1 1QT
0208 363 5764
RIBA

Disclaimer,
No Reproduction without Consent
Do not Scale from this Drawing
Only use Dimensions Shown
Dims & Areas accurate to 5%
© Copyright 2022 Building Doctors

Date	Amendments
05.05.21	Notes Added
14.07.21	Existing Chimney Added, Boundary Line altered, Alterations added as Highlighted Notes
27.07.21	New Ensuite & Wardrobe added, Bath Layouts Added, Notes Added
17.11.21	New WC, Alterations to Markups
07.03.22	Alterations to Client comments
06.07.22	Existing Maintained Porch

Ve.	In.	Date	Amendments	Ve.	In.
A	FR				
B	FR				
C	FR				
D	FR				
E	FR				

Project Pennicotts Farm
PO20 1LN
Draft Planning B. Control
Tender Constr. Other

Title GF Plan
DRAINAGE
Client Mr. S.
Cox-Rusbridge

971 - B110 F
0 M 0.5 M 1 M 1.5 M 2 M
1:50
0 M 1 M 2 M 3 M 4 M
1:100
A2