



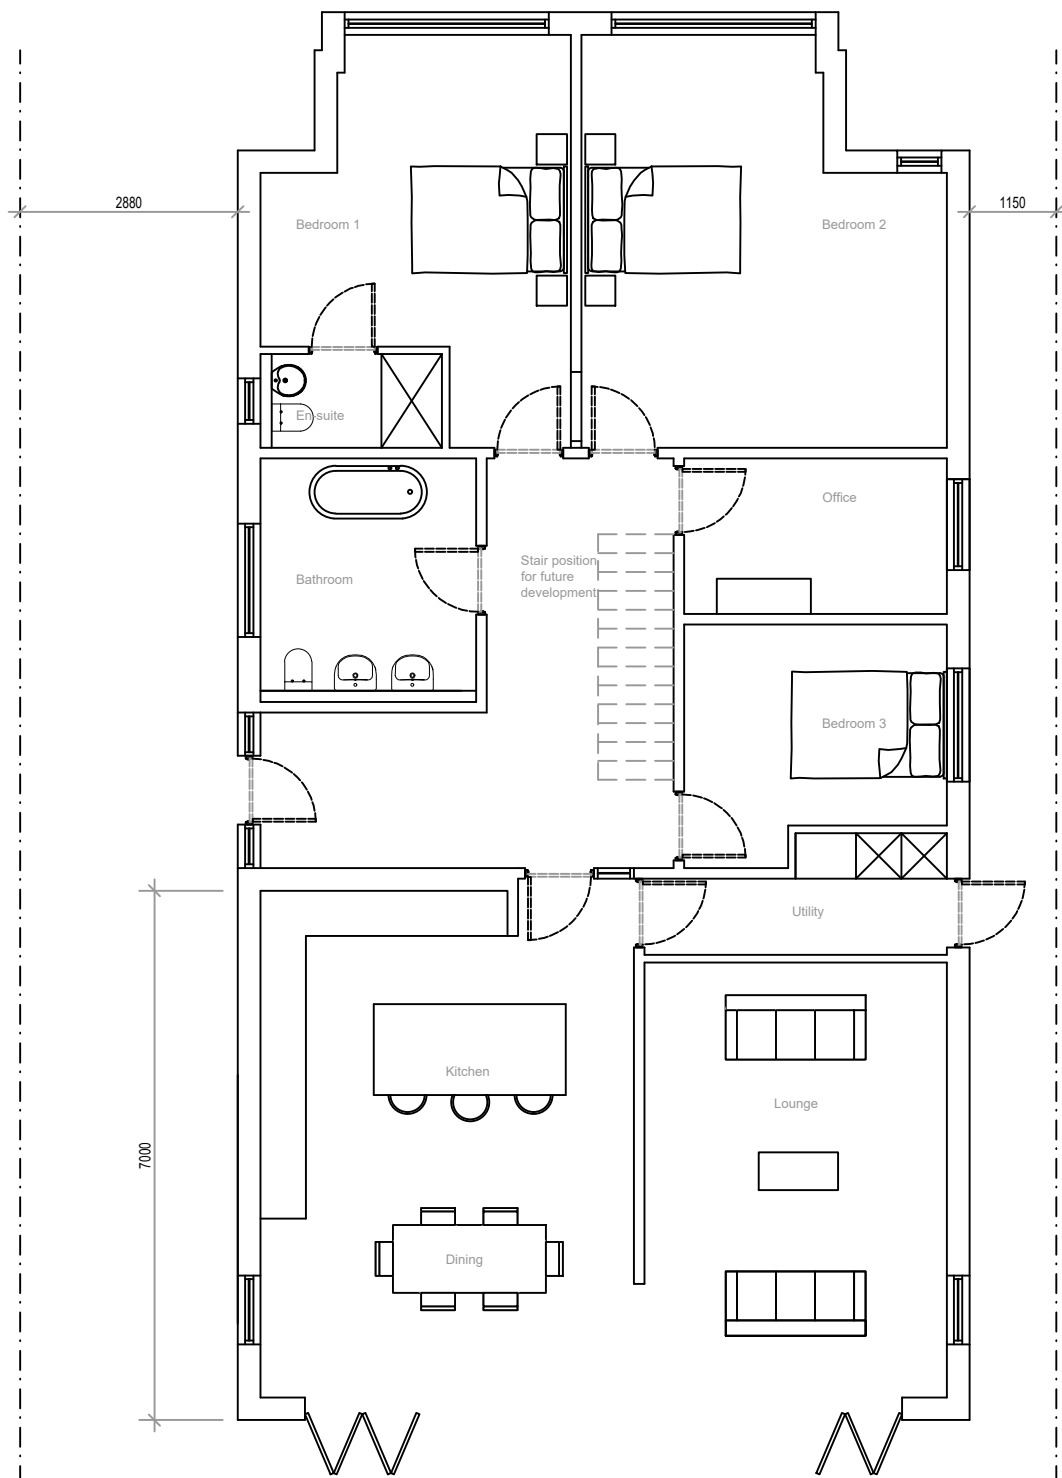

As Built Ground Floor Plan
Scale 1:100

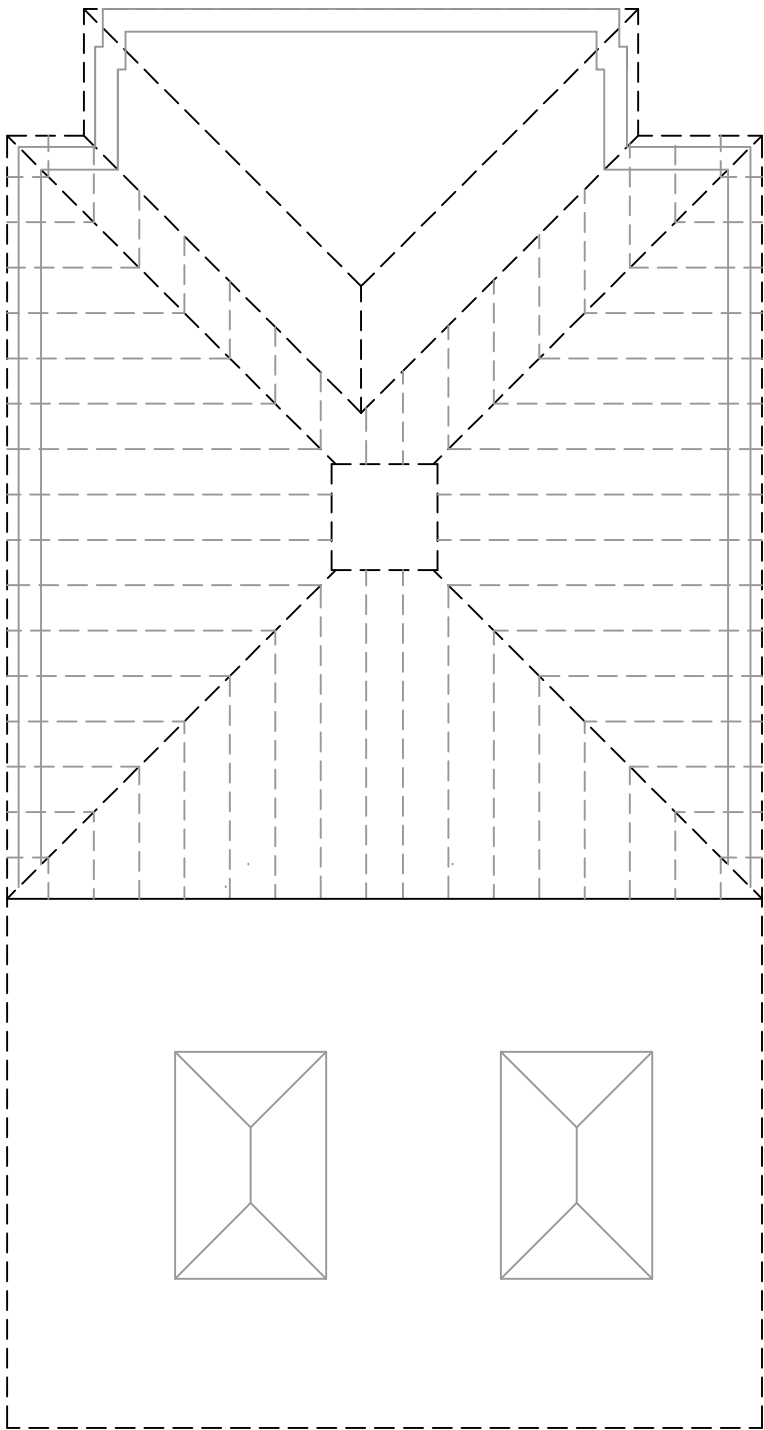

As Built Roof Plan
Scale 1:100

NOTE: This drawing has been prepared using "As Built" information to reflect the single storey rear extension constructed to the rear of 9 Kings Road.

Extension to
9 Kings Drive, Pagham,
Bognor Regis

client
Mr. & Mrs. Wheeler

dwg.title As Built Floor Plan and Roof Plan

scale 1: 100 @ A3

Drawing Number: 0101-08

date 30.12.20