




As Built South West Rear Elevation



As Built North East Front Elevation

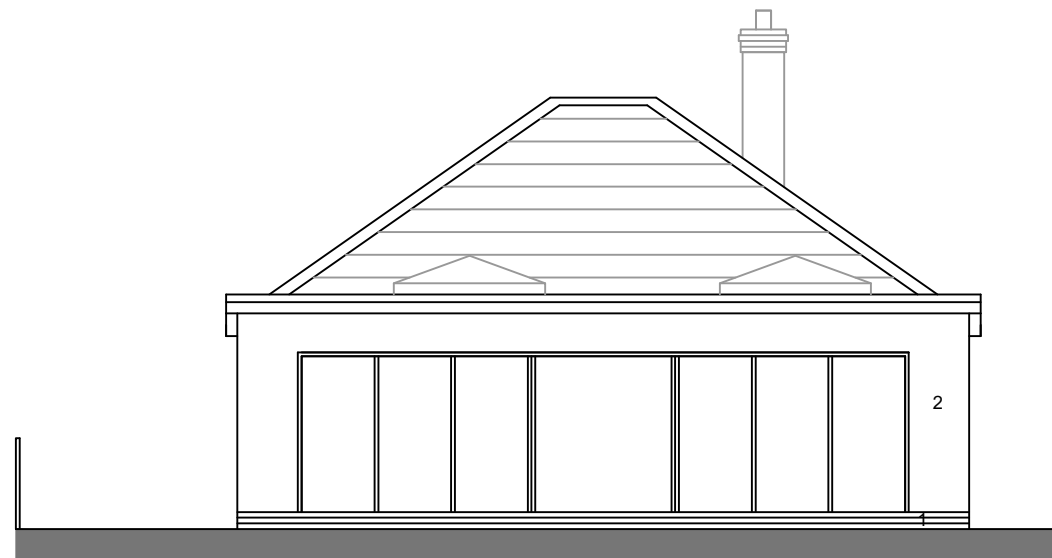

As Built North Facing Elevation



As Built South Facing Elevation

Proposed Materials

1. Brick plinth to match existing
2. Render finish (white)
3. PVC-u windows (grey - RAL 7016)
4. Aluminium glazed entrance door and window system (grey - RAL 7016)
5. Aluminium bi-fold/tilt and turn door systems
6. Roof Light

NOTE: This drawing has been prepared using "As Built" information to reflect the single storey rear extension constructed to the rear of 9 Kings Road.

Extension to 9 Kings Road, Pagham, Bognor Regis

client

Mr. & Mrs. Wheeler

dwg.title As Built Elevations @ A3

scale 1: 100

Drawing Number: 0101-09

date 30.12.20

Rev: 00