




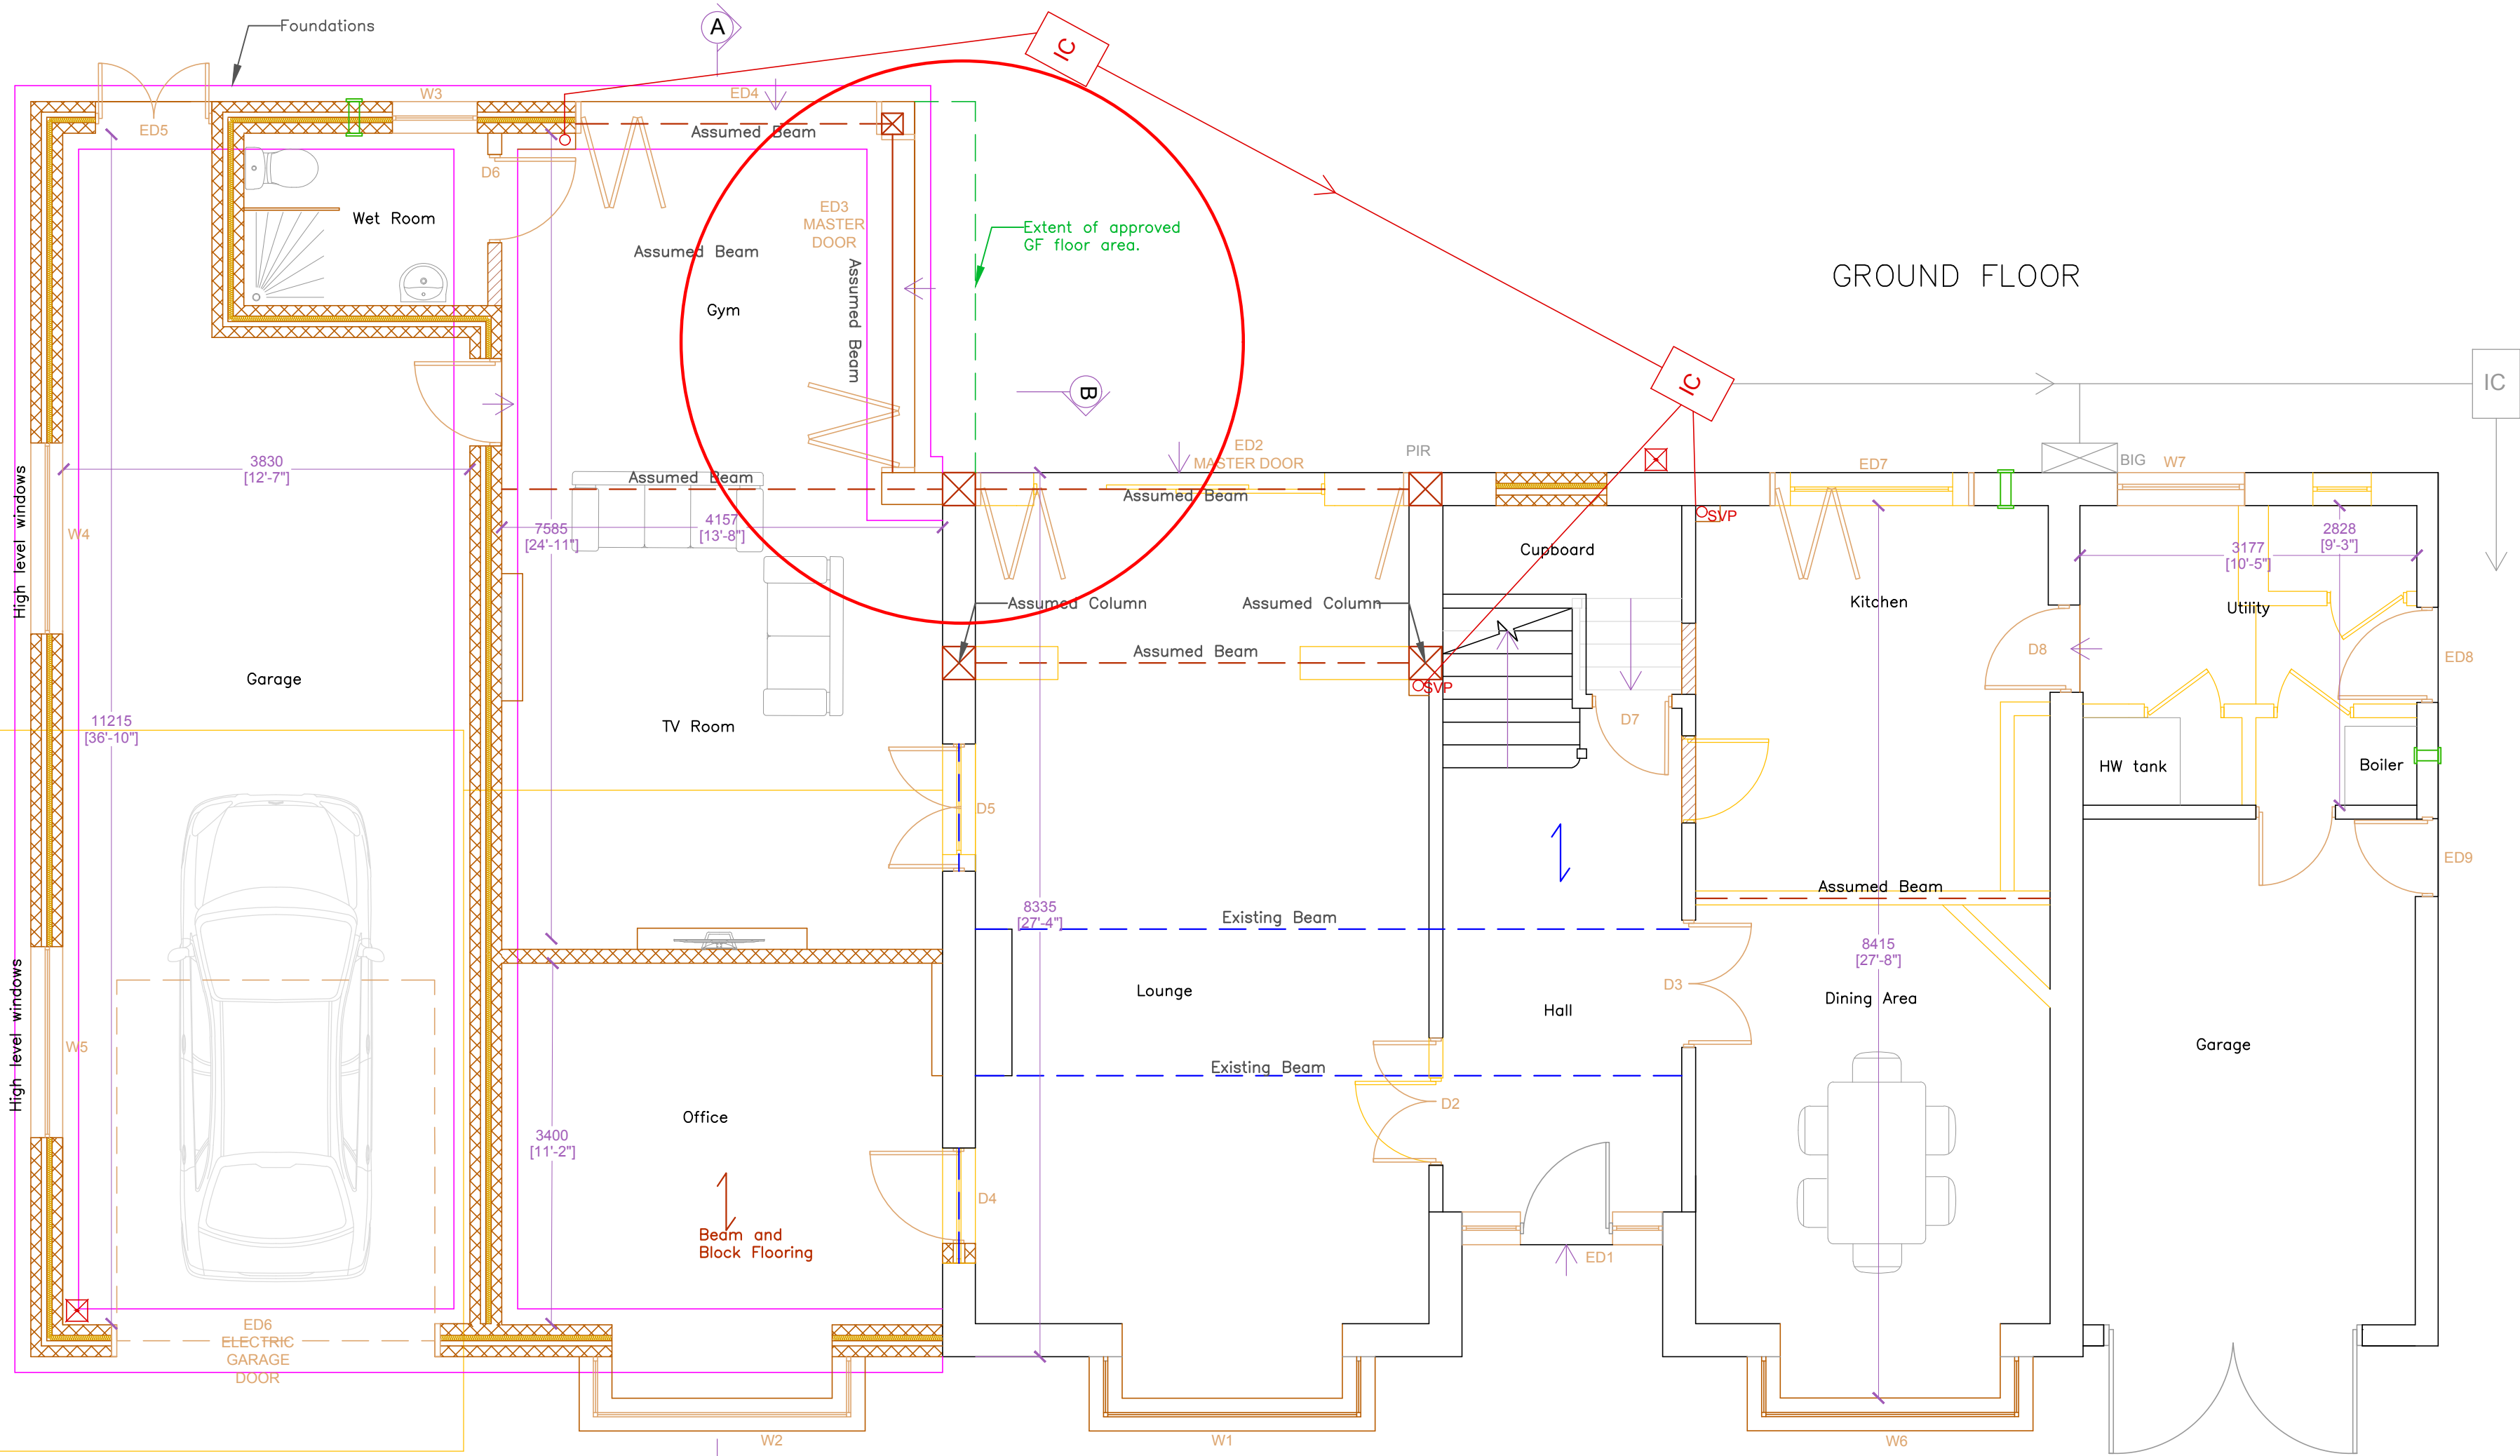

GROUND FLOOR

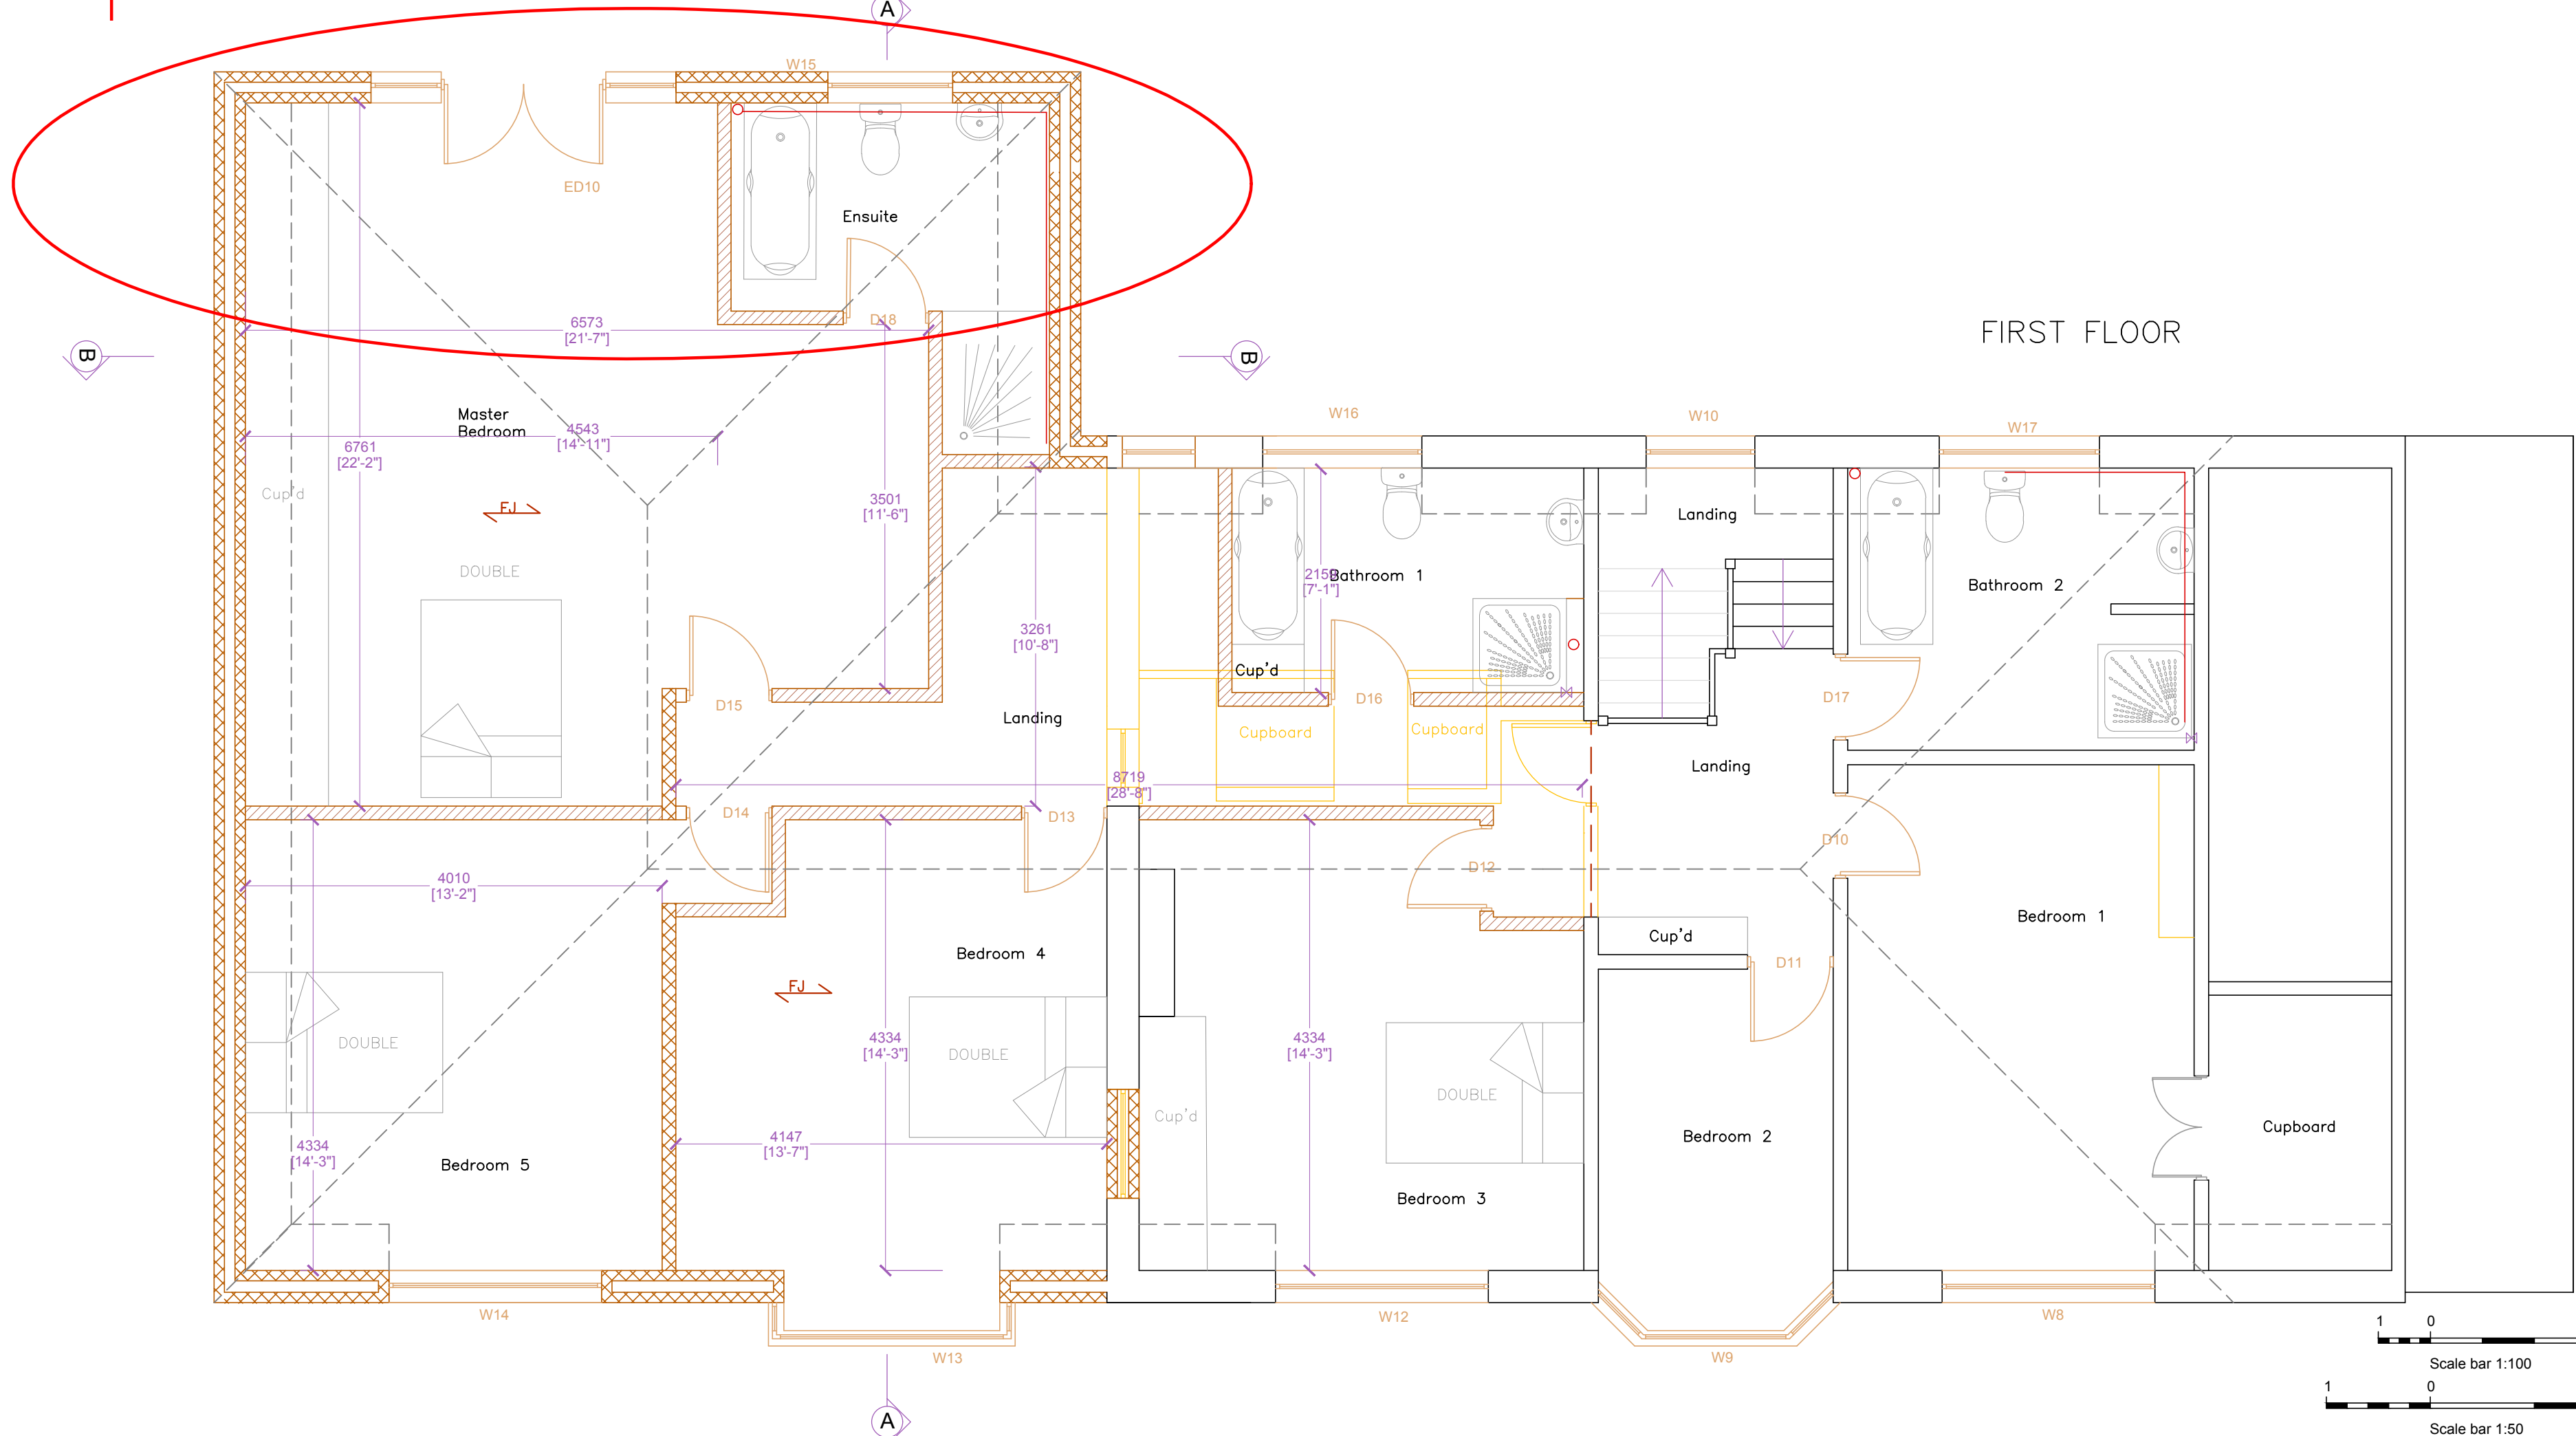

FIRST FLOOR

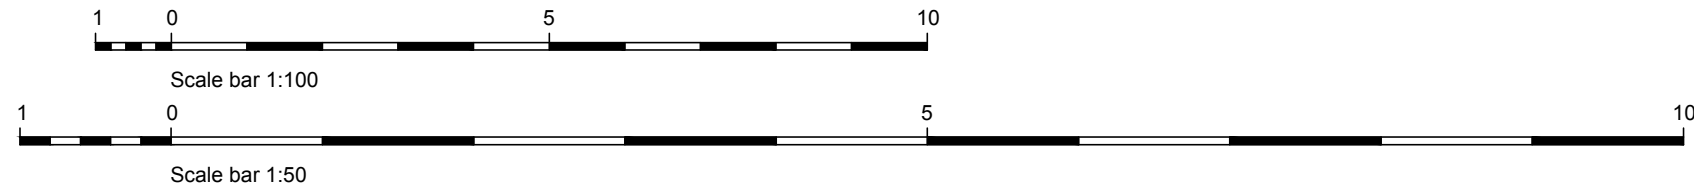

This drawing is the property of Fuller Associates and is not to be copied reproduced, retained or disclosed to any unauthorised person either wholly or in part without prior consent. Do not scale from this drawing except for Planning purposes. Use all figured dimensions only. All figured dimensions to be checked on site prior to construction. All discrepancies, errors and omissions to be reported to Fuller Associates prior to construction. Layout and dimensions existing building to be checked on site.

Rev.	Details	Date
R4.	REMOVAL OF BALCONY	09/05/19

FULLER ASSOCIATES
Chartered Surveyors • Architectural Design

10-11 The Parade
Willowhayne Crescent
East Preston
West Sussex
BN16 1NS

01903 774754
www.fuller-associates.co.uk

Issued for:	Drawn	Checked
Discussion	KW	DF
Planning Application	X	X
Building Control	X	X
Construction Issue	X	X
As Built	X	X

PROPOSED FLOOR PLANS
1:50

Client
Site Address
36 The Parkway
Rustington
BN16 2BU

Mr and Mrs Selva

Printed
Date
Drawing Number

As Shown on A1
16/05/2019
163034/02R4