


NOTES
WRITTEN DIMENSIONS TO BE TAKEN IN PREFERENCE TO SCALE, AND
ANY DISCREPANCIES ARE TO BE REFERRED IMMEDIATELY TO THE
PROJECT DESIGNER.
THIS DRAWING IS COPYRIGHT, AND SHOULD NOT BE USED OR
REPRODUCED WITHOUT PERMISSION.
IT IS THE CONTRACTOR'S RESPONSIBILITY TO ENSURE COMPLIANCE
WITH THE BUILDING REGULATIONS.

DRAWING SHOWS SCHEME AS BUILT

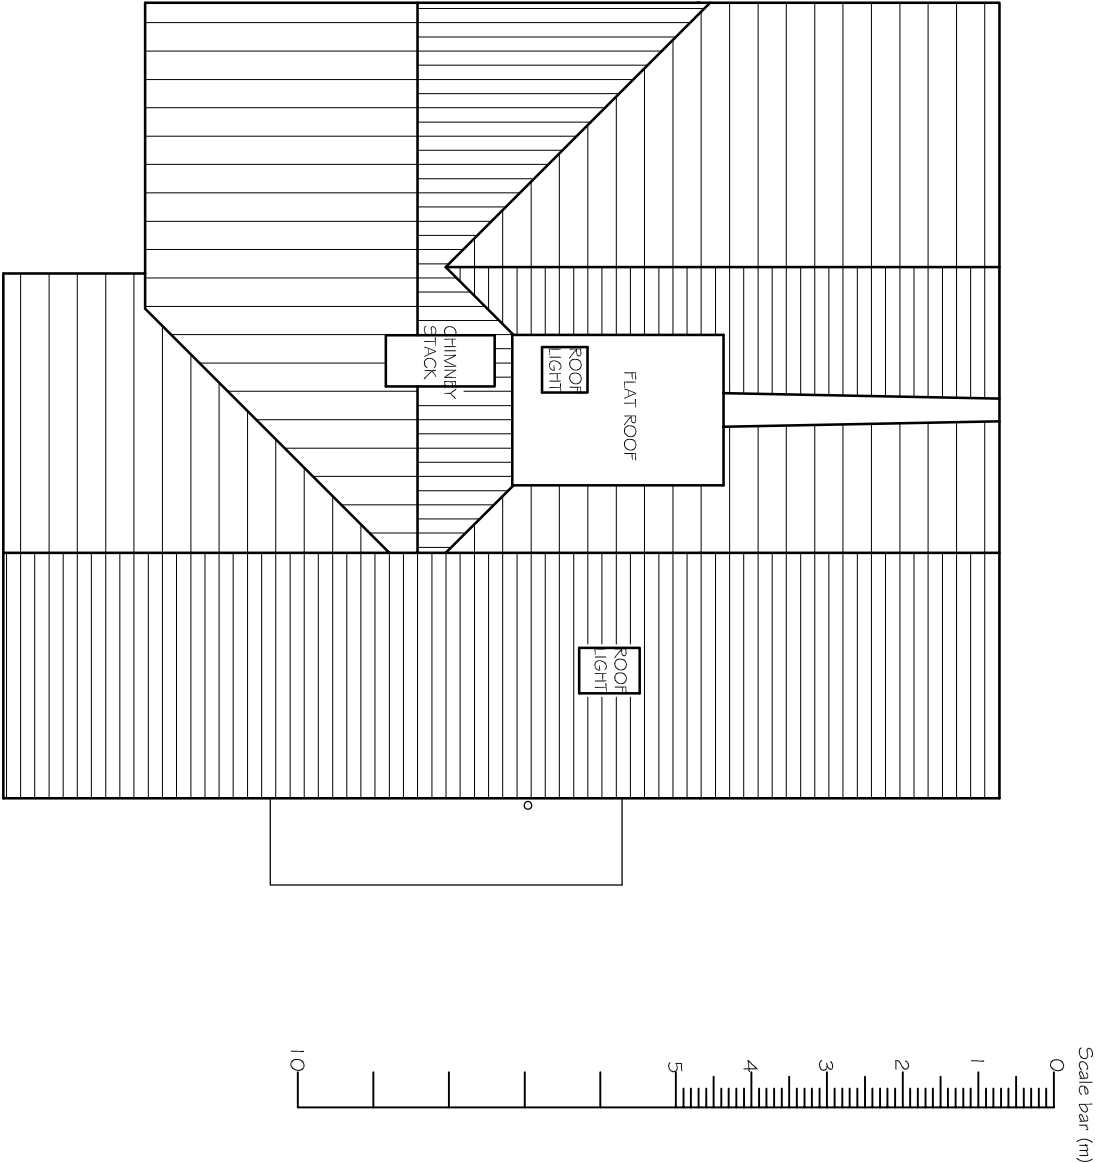

ROOF PLAN

CLIENT
MR E FITZMAURICE

PROJECT
3 BUSHBY AVENUE
RUSTINGTON
WEST SUSSEX

DRAWING TITLE
AS BUILT ROOF PLAN

SCALE 1:100 @A3
DWG NO 660/06
REV. C

DRAWN BY
PLB

DATE
MAR 17

03.07.18
27.06.18
22.03.17
DATE

CHARTERED BUILDING SURVEYORS
SLOANE
&
BROWN
ARCHITECTURAL SERVICES

Unit 3b Woodhorn Business Centre
Woodhorn Lane
Oving Chichester
West Sussex PO20 2BX
Tel 01243 774764
www.sloaneandbrown.co.uk