



NOTES  
WRITTEN DIMENSIONS TO BE TAKEN IN PREFERENCE TO SCALE, AND  
ANY DISCREPANCIES ARE TO BE REFERRED IMMEDIATELY TO THE  
PROJECT DESIGNER.  
THIS DRAWING IS COPYRIGHT, AND SHOULD NOT BE USED OR  
REPRODUCED WITHOUT PERMISSION  
IT IS THE CONTRACTOR'S RESPONSIBILITY TO ENSURE COMPLIANCE  
WITH THE BUILDING REGULATIONS.

DRAWING SHOWS SCHEME AS BUILT

Scale bar (m)

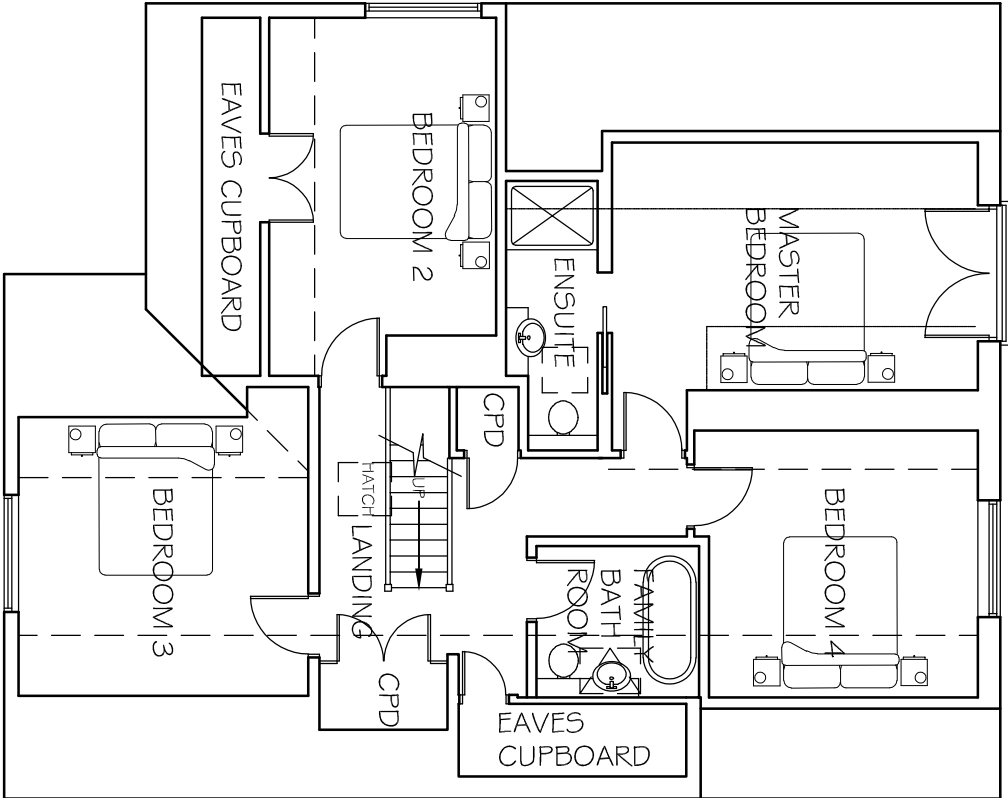

FIRST FLOOR PLAN

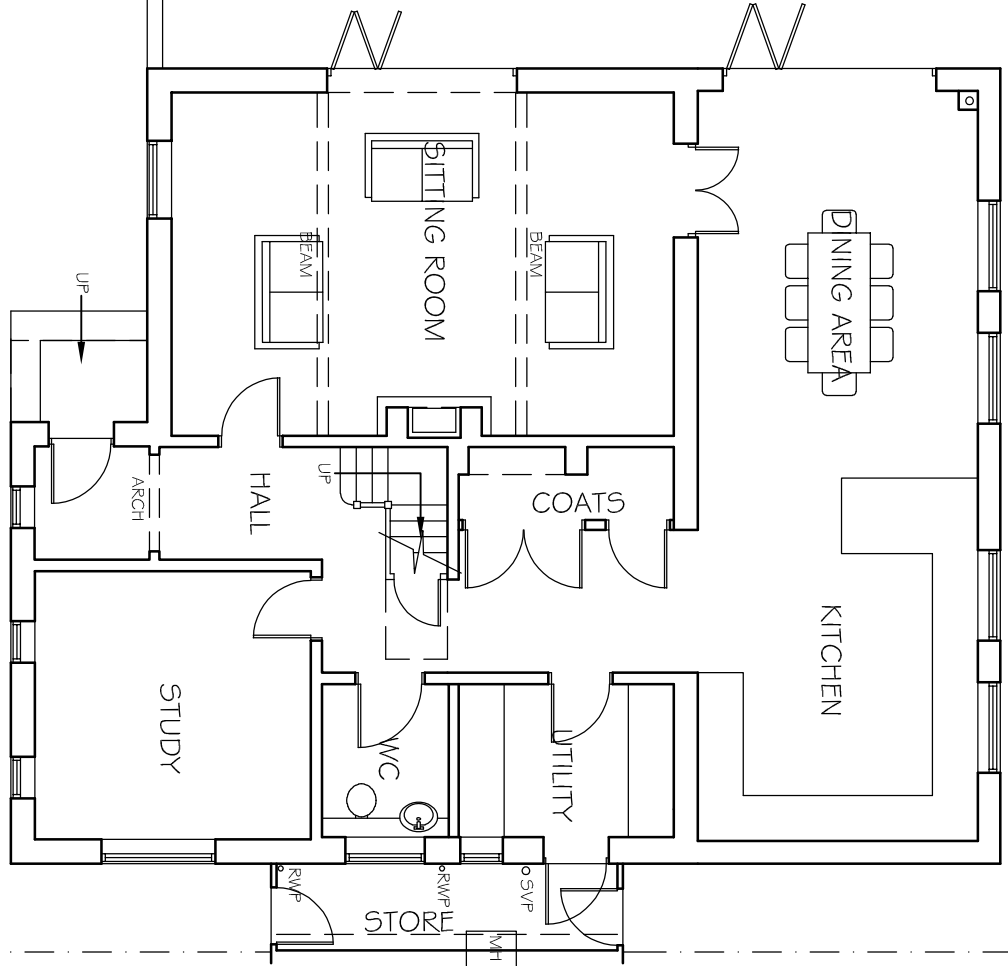

GROUND FLOOR PLAN

CLIENT

MR E FITZMAURICE

PROJECT

3 BUSHBY AVENUE  
RUSTINGTON  
WEST SUSSEX

SCALE

1:100 @A3

DRAWN BY

PLB

DATE

MAR 17

DWG NO

660/07

REV.D

- |     |                              |          |
|-----|------------------------------|----------|
| D   | NOTE ADDED                   | 03.07.18 |
| C   | VARIOUS AMENDMENTS           | 27.06.18 |
| B   | MASTER BED & ENSUITE AMENDED | 17.05.17 |
| A   | MINOR AMENDMENTS             | 22.03.17 |
| REV | DESCRIPTION                  | DATE     |

CHARTERED BUILDING SURVEYORS

SLOANE & BROWN

ARCHITECTURAL SERVICES

Unit 3b Woodhorn Business Centre  
Woodhorn Lane  
Oving Chichester  
West Sussex PO20 2BX  
Tel 01243 774764  
www.sloaneandbrown.co.uk