




NOTES
WRITTEN DIMENSIONS TO BE TAKEN IN PREFERENCE TO SCALE, AND
ANY DISCREPANCIES ARE TO BE REFERRED IMMEDIATELY TO THE
PROJECT DESIGNER.
THIS DRAWING IS COPYRIGHT, AND SHOULD NOT BE USED OR
REPRODUCED WITHOUT PERMISSION.
IT IS THE CONTRACTOR'S RESPONSIBILITY TO ENSURE COMPLIANCE
WITH THE BUILDING REGULATIONS.

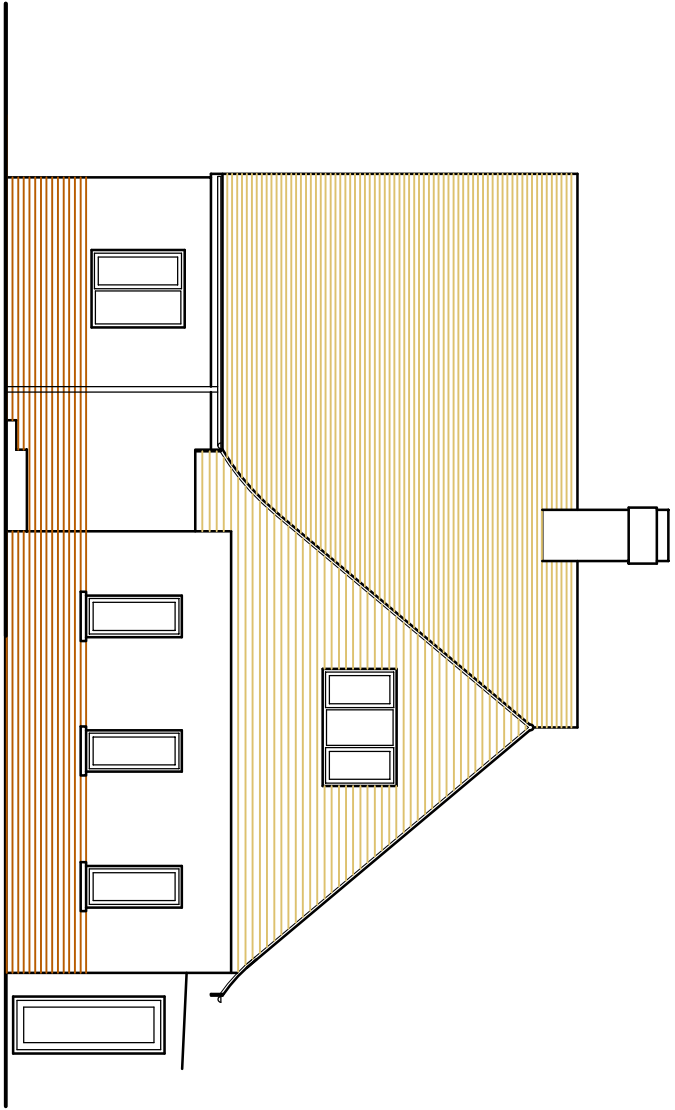


FRONT (SOUTH) ELEVATION

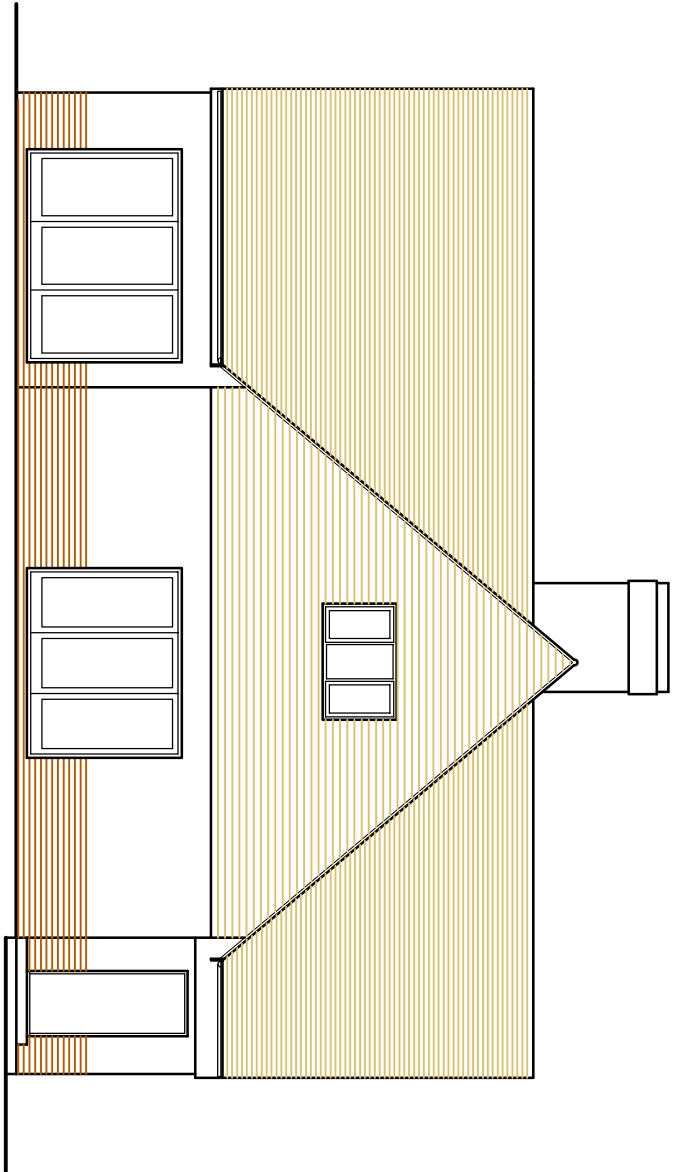

SIDE (WEST) ELEVATION

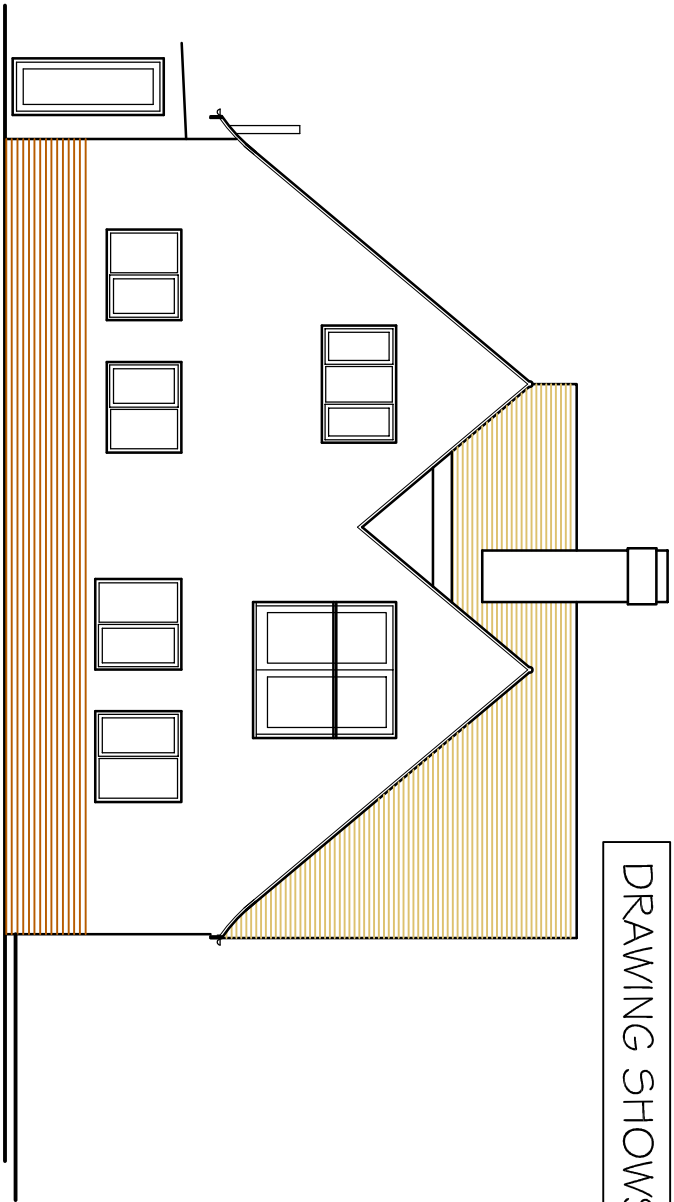


REAR (NORTH) ELEVATION

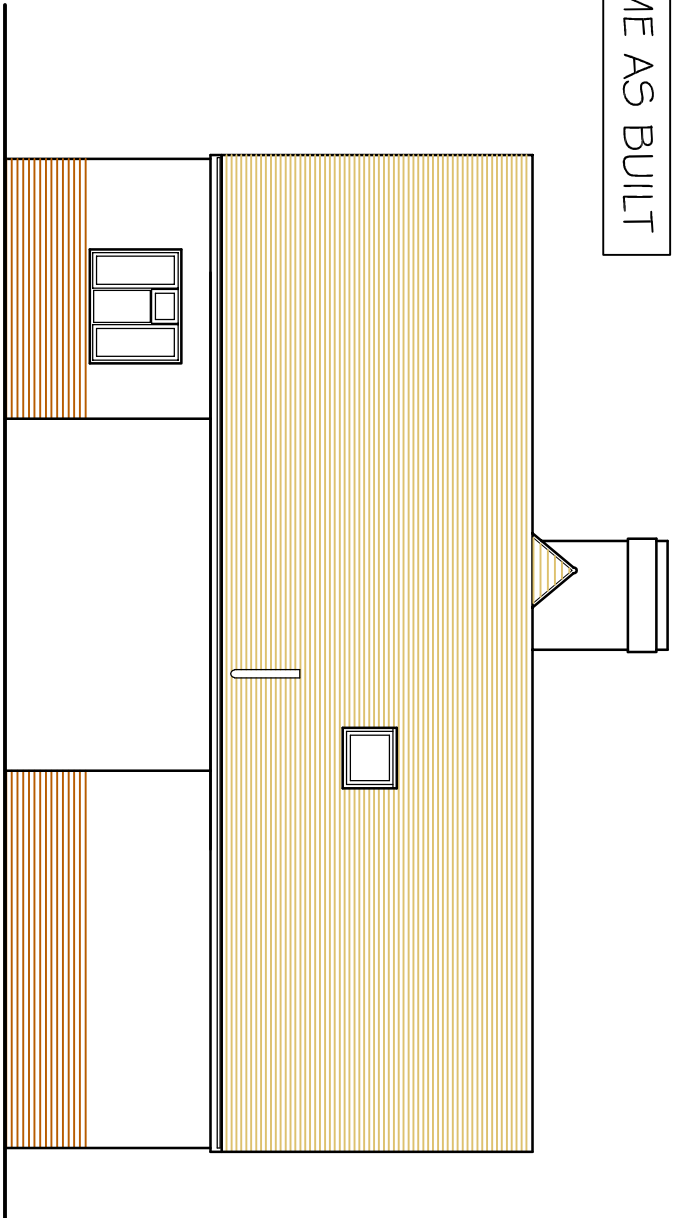

SIDE (EAST) ELEVATION

DRAWING SHOWS SCHEME AS BUILT

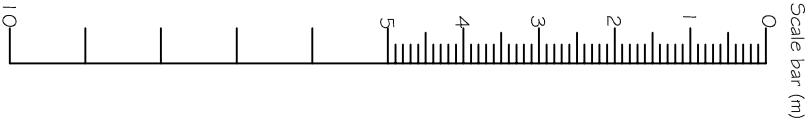

D	NOTE ADDED	03.07.18
C	VARIOUS AMENDMENTS	27.06.18
B	NORTH & WEST ELEVATIONS AMENDED	17.05.17
A	MINOR AMENDMENTS	22.03.17
REV	DESCRIPTION	DATE

CLIENT
MR E FITZMAURICE

PROJECT
3 BUSHBY AVENUE
RUSTINGTON
WEST SUSSEX

SCALE 1:100 @A3
DWG NO 660/08
REV. D

DRAWN BY PLB
DATE MAR 17
DRAWING TITLE
AS BUILT ELEVATIONS



Unit 3b Woodhorn Business Centre
Woodhorn Lane
Oving Chichester
West Sussex PO20 2BX
Tel 01243 774764
www.sloaneandbrown.co.uk