


SPECIFICATION

Green Area -
new fence



Red line signifies
section of wall to
be removed

Blue line signifies
redesign or
reposition
of fence

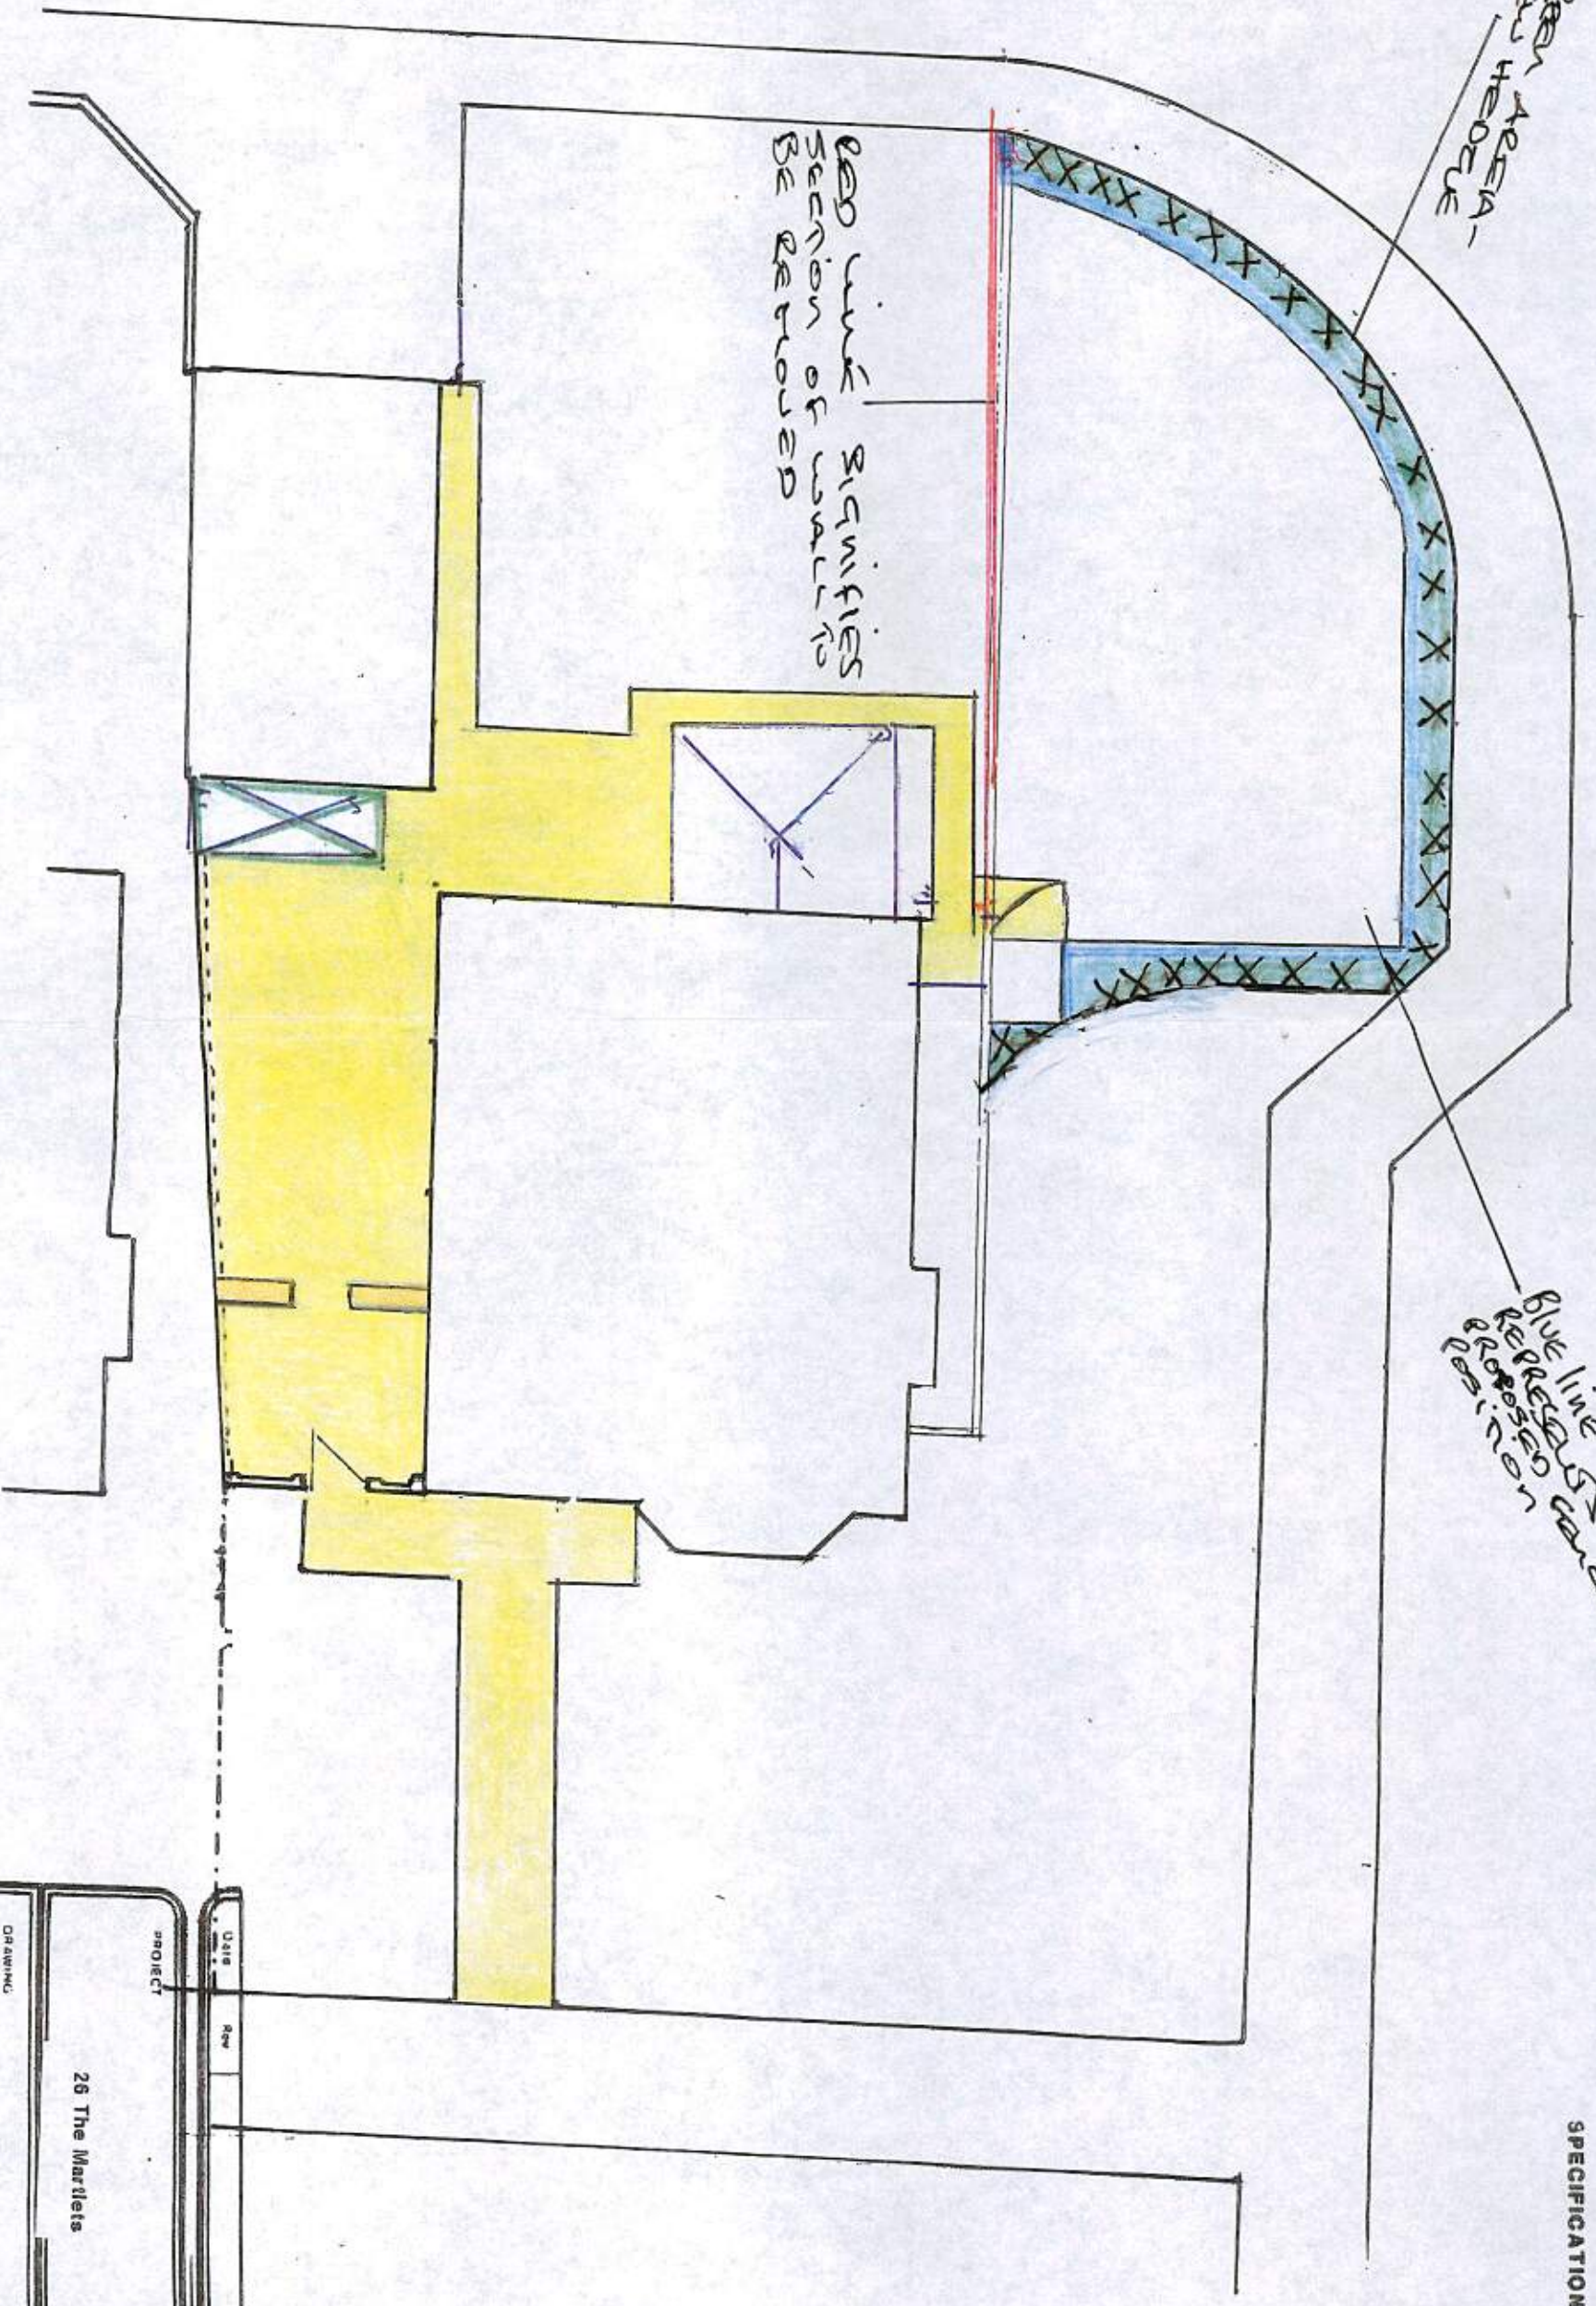

CHECK ALL DIMENSIONS DO NOT SCALE

PROJECT		26 The Martlets	
DRAWING		Site Plan	
Scale	1/100	Drawing No	
Date		Drawn by	PS/02