




EXISTING FRONT ELEVATION

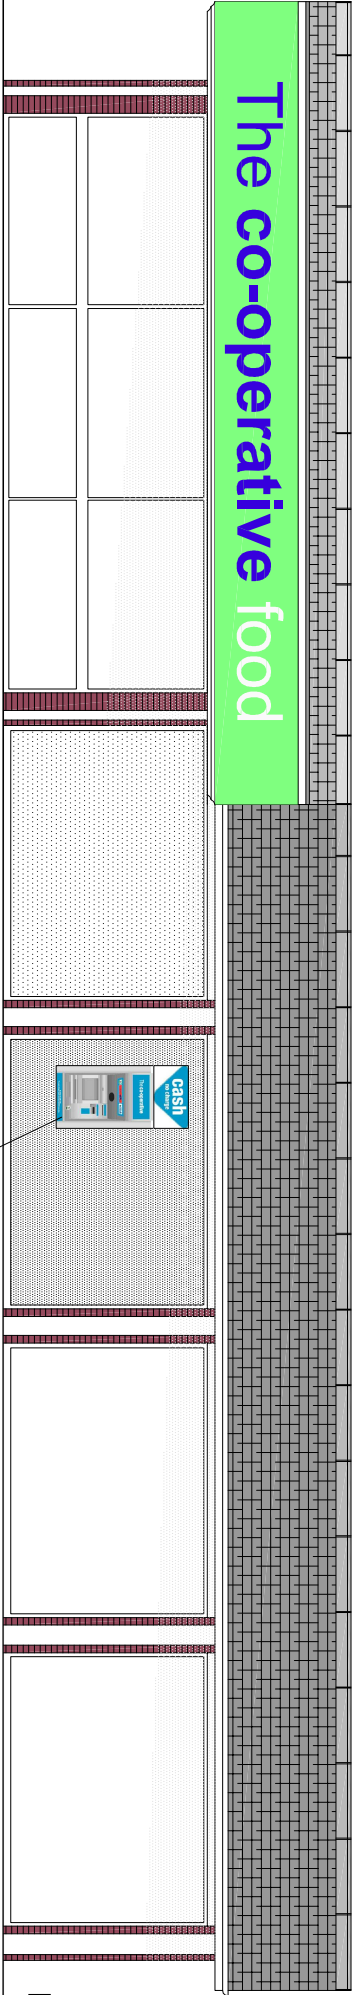

PROPOSED FRONT ELEVATION

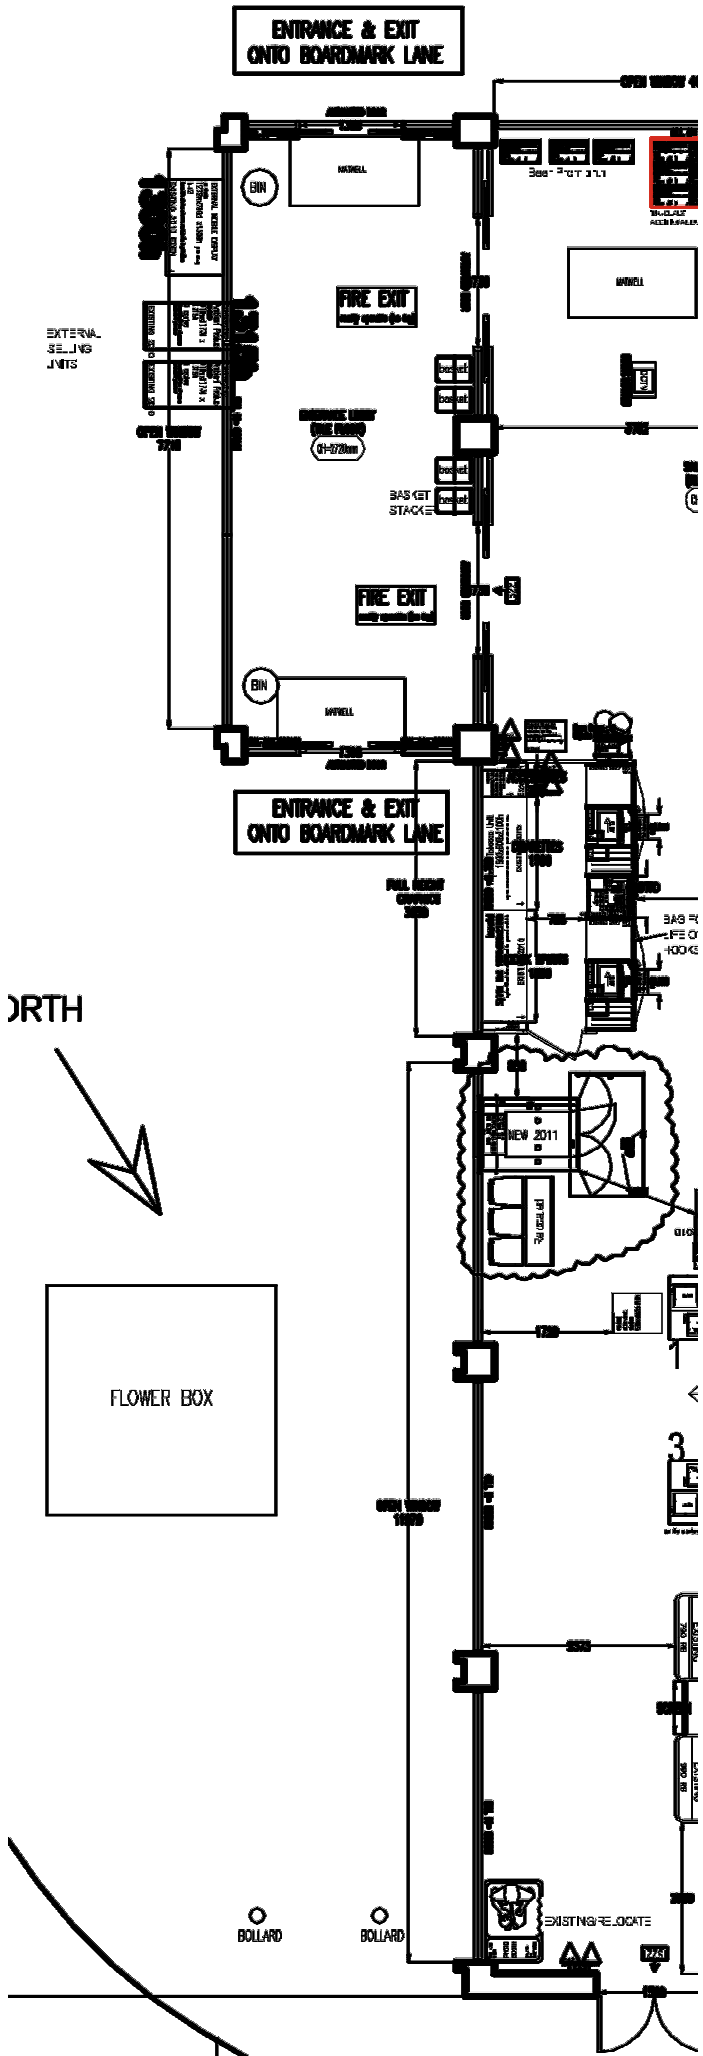

PROPOSED PART PLAN

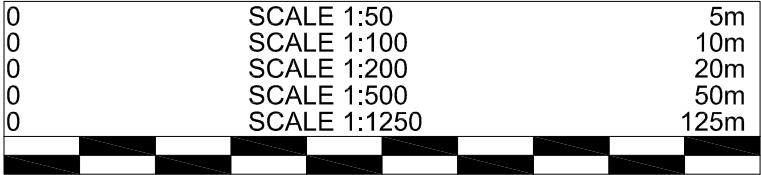

REV	NOTE	DR	CH	DATE
-----	------	----	----	------

© COPYRIGHT: ALL RIGHTS RESERVED.

THIS DRAWING MUST NOT BE REPRODUCED WITHOUT PERMISSION.
THIS DRAWING MUST BE READ IN CONJUNCTION WITH ALL RELEVANT
CONSULTANTS/PROFESSIONAL DRAWINGS/INFORMATION
THIS DRAWING MUST NOT BE USED FOR CONSTRUCTION UNLESS ISSUED
FOR CONSTRUCTION.
ALL DIMENSIONS ON THIS DRAWING ARE IN MILLIMETRES (UNLESS OTHERWISE STATED).
DO NOT SCALE FROM THIS DRAWING.



DRAWING STATUS

SKETCH	PRELIMINARY	APPROVAL	PLANNING	BUILDING REGS	TENDER	CONSTRUCTION	AS BUILT
--------	-------------	----------	----------	---------------	--------	--------------	----------

darnnton **egs**

BUILT ENVIRONMENT CONSULTANCY

LEEDS LONDON BRISTOL WARWICK

Leeds Office:
The Coach House, Monk Fyfe Street, Monk Fyfe, Leeds, LS26 5DU
T: 01977 681001 F: 01977 681006 www.darnntonegs.com

CLIENT
THE CO-OPERATIVE BANK

PROJECT
RUSTINGTON - 1 Broadmark Lane
Rustington, West Sussex BN16 2NE

DRAWING
**EXISTING & PROPOSED ELEVATION &
PLAN OF NEW ATM CASH MACHINE**

SCALE
1:100 @ A3

DATE
16.09.2011

DRAWN
AY

CHECKED

DRAWING NUMBER

7859 - 109832 [RUST] 01

REVISION