

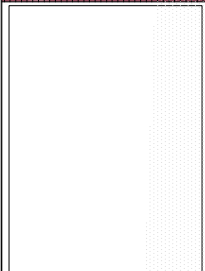
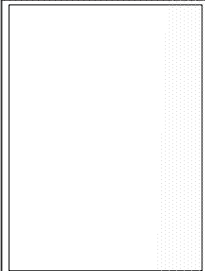
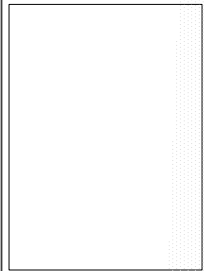
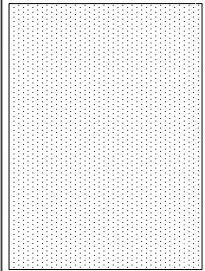
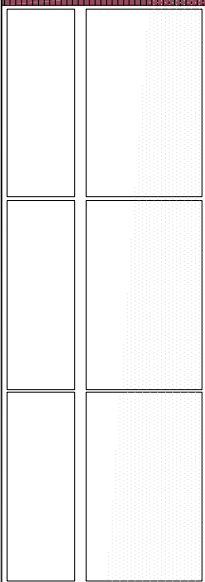
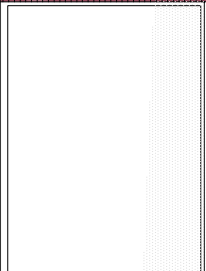
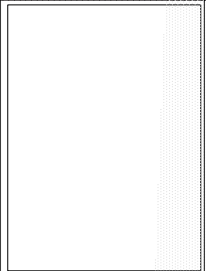
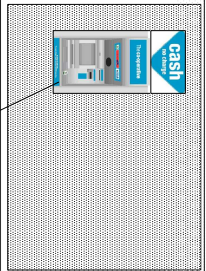


The co-operative food

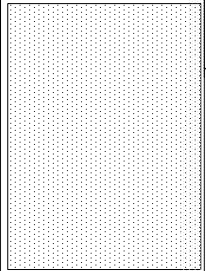


EXISTING FRONT ELEVATION



The co-operative food

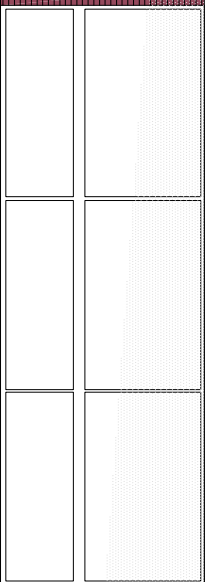

PROPOSED FRONT ELEVATION

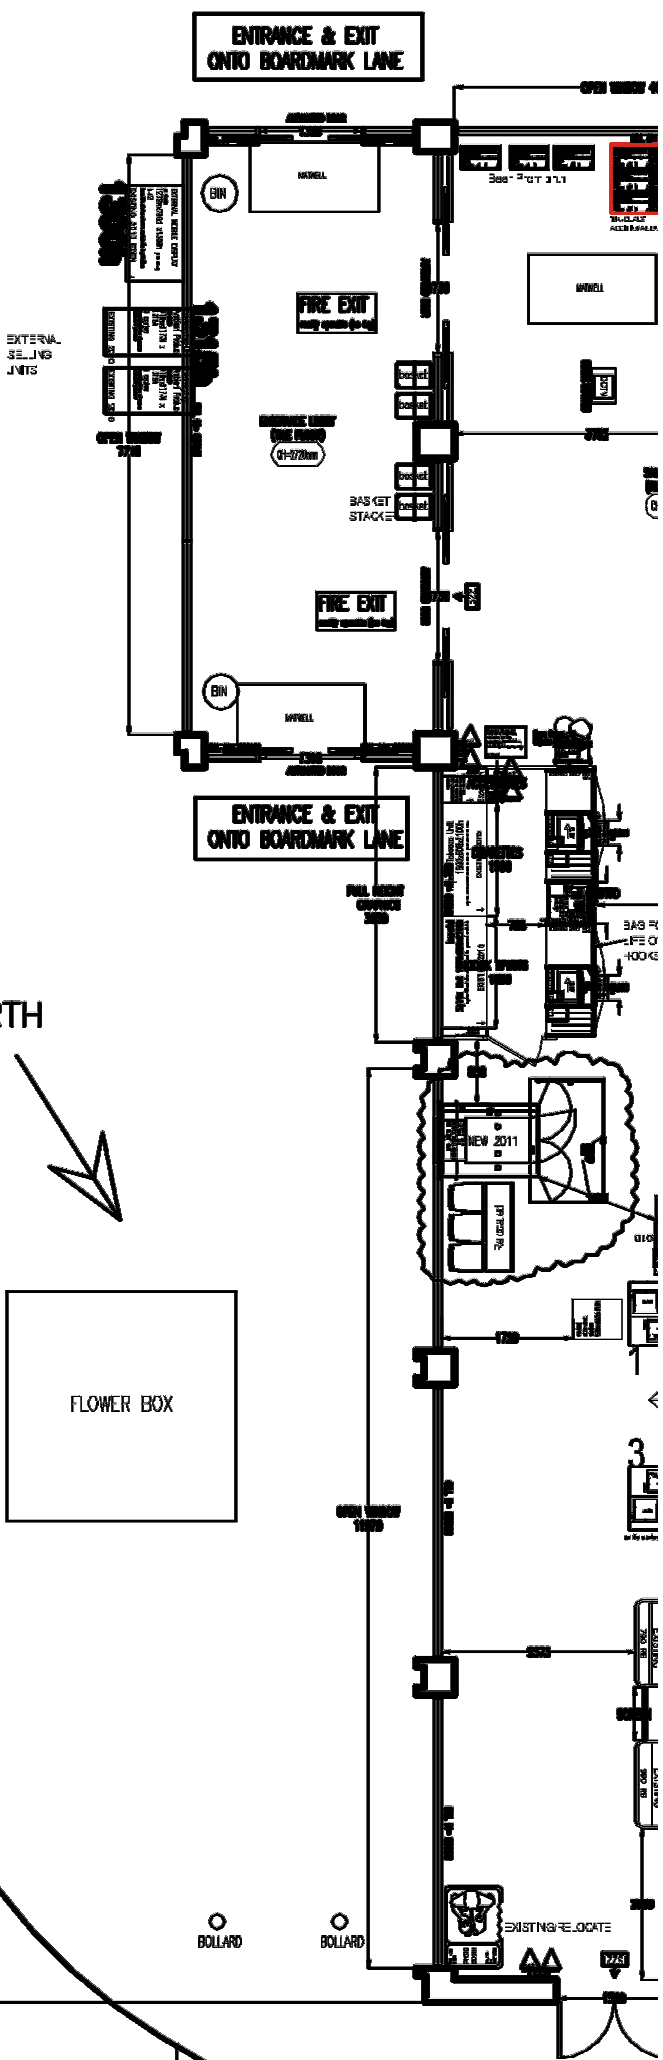

PROPOSED PART PLAN

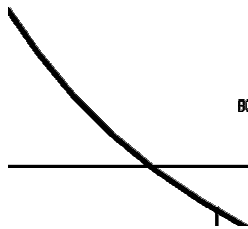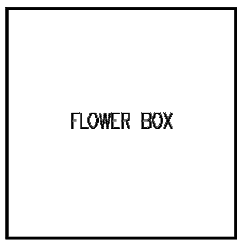

0	SCALE 1:50	5m
0	SCALE 1:100	10m
0	SCALE 1:200	20m
0	SCALE 1:500	50m
0	SCALE 1:1250	125m

REV	NOTE	DR	CH	DATE
-----	------	----	----	------

darn-ton *eigs*

BUILT ENVIRONMENT CONSULTANCY

LEEDS LONDON BRISTOL WARWICK

Leeds Office:
The Coach House, Monk Frysion Hall, Monk Frysion, Leeds, LS25 5DU
T: 01977 68 1001 • 01977 68 006 • www.darn-ton.co.uk

CLIENT
THE CO-OPERATIVE BANK

PROJECT
RUSTINGTON - 1 Broadmark Lane
Rustington, West Sussex BN16 2NE

**DRAWING
EXISTING & PROPOSED ELEVATION &
PLAN OF NEW ATM CASH MACHINE**

1:100 @ A3

DATE _____

16.09.2011

DRAWN

AY

CHECKED

DRAWING NUMBER

7859 - 109832 [RUST] 01

REVISION

© COPYRIGHT: ALL RIGHTS RESERVED.
THIS DRAWING MUST NOT BE REPRODUCED WITHOUT PERMISSION.
THIS DRAWING MUST BE READ IN CONJUNCTION WITH ALL RELEVANT
CONSULTANT/SPECIALIST DRAWINGS/INFORMATION.
THIS DRAWING MUST NOT BE USED FOR CONSTRUCTION UNLESS ISSUED
FOR CONSTRUCTION.
ALL DIMENSIONS ON THIS DRAWING ARE IN MILLIMETRES (UNLESS OTHERWISE STATED).
DO NOT SCALE FROM THIS DRAWING.



DRAWING STATUS

SKETCH

PRELIMINARY

APPROVAL

PLANNING

BUILDING REGS

TENDER

CONSTRUCTION

AS BUILT