



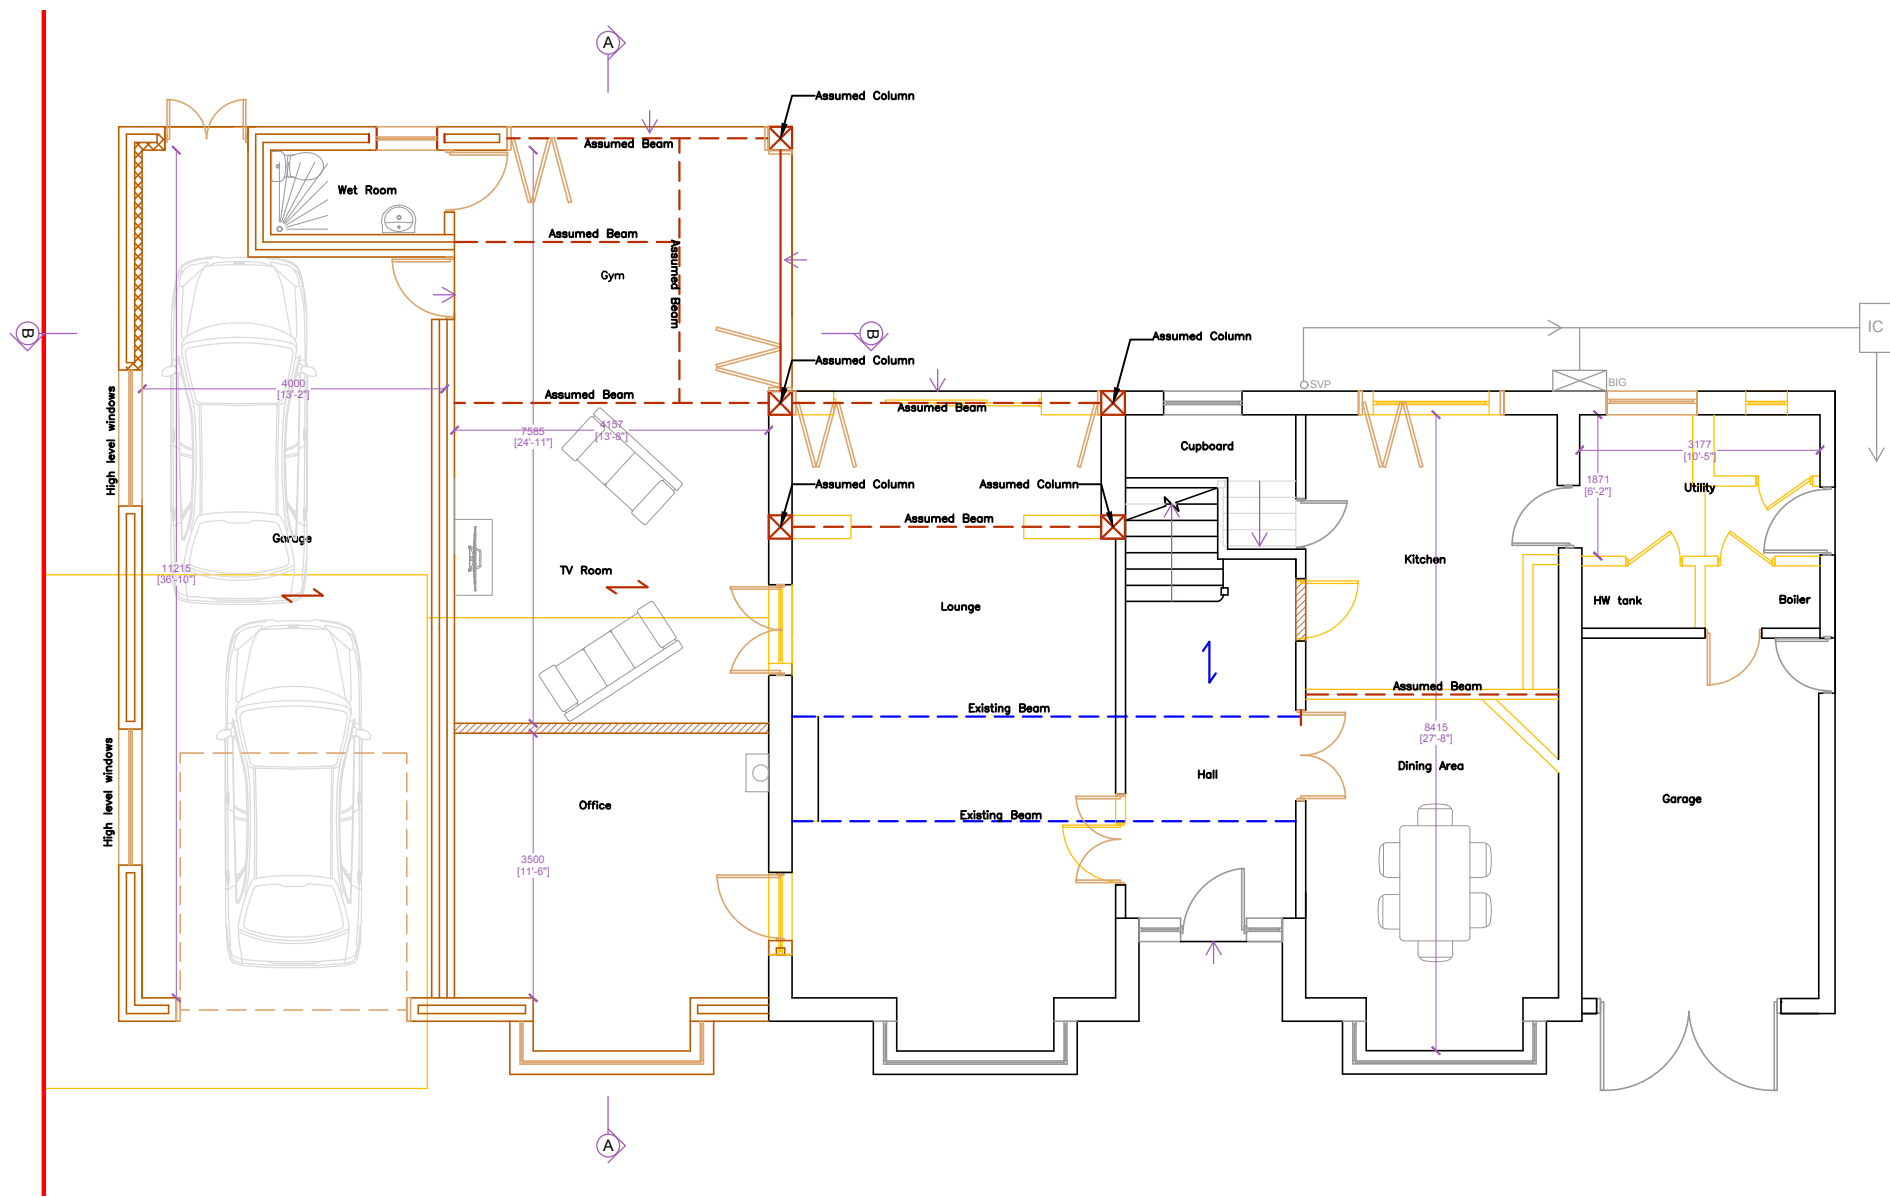

Ground Floor

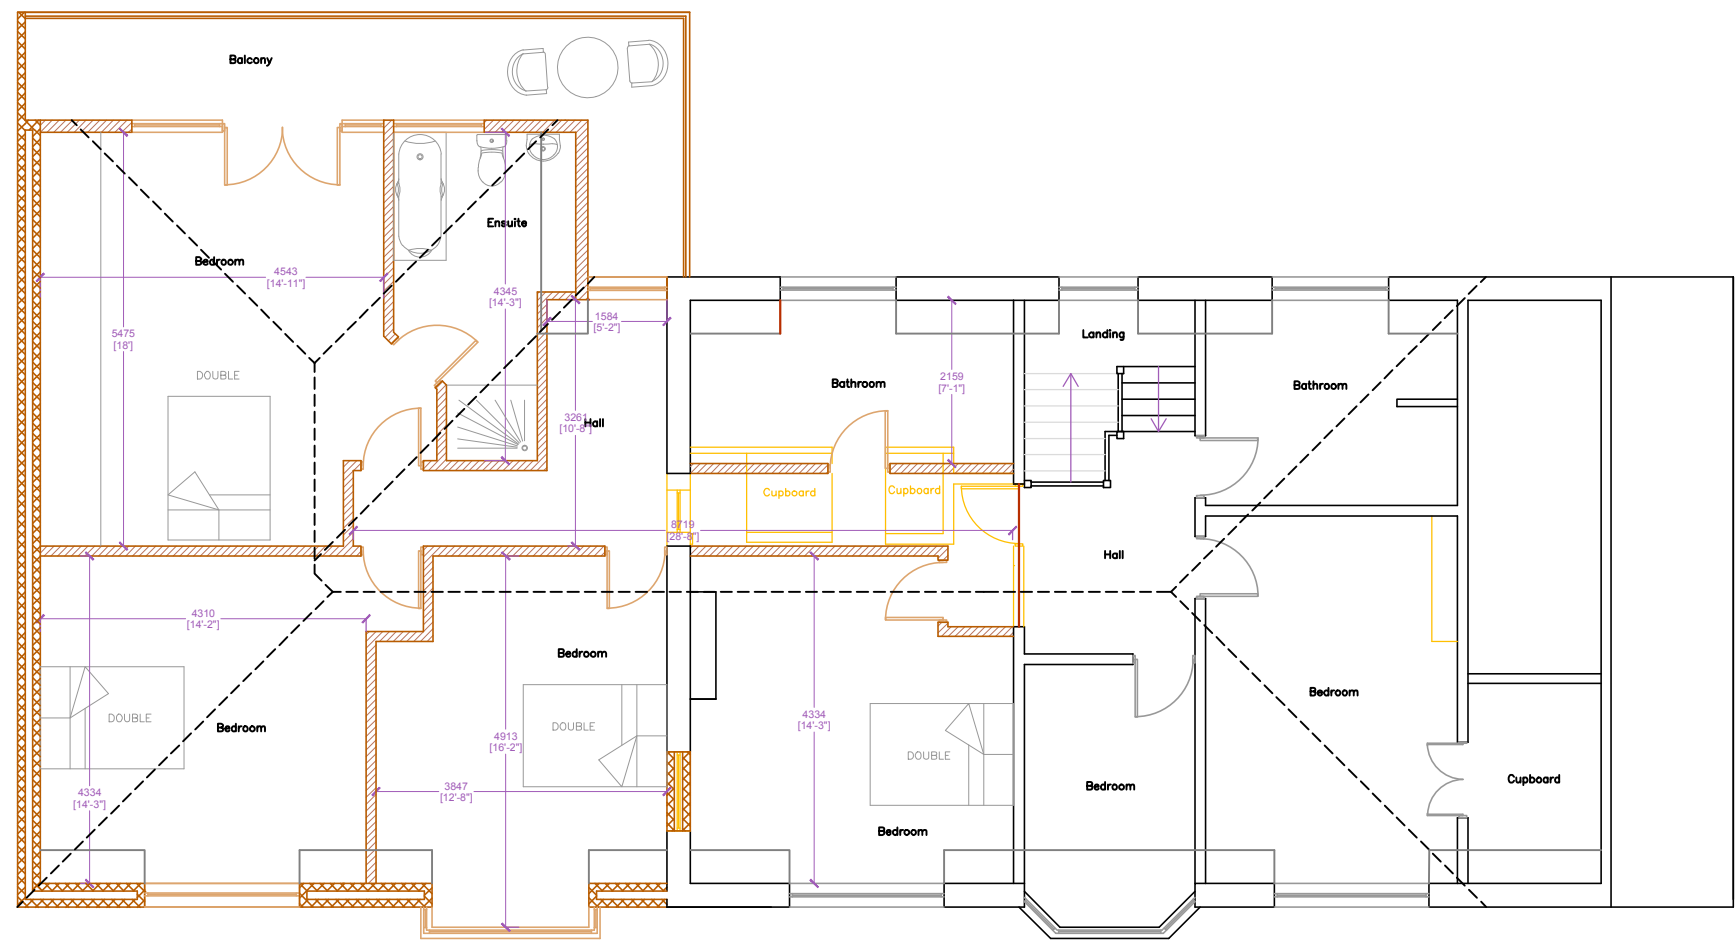


First Floor

Floor Plans  
Approved under  
R/275/18/HH  
1:100


Please Note  
There are no  
changes to the  
approved Floor  
Plans




Approved and  
Proposed Block Plan  
1:500

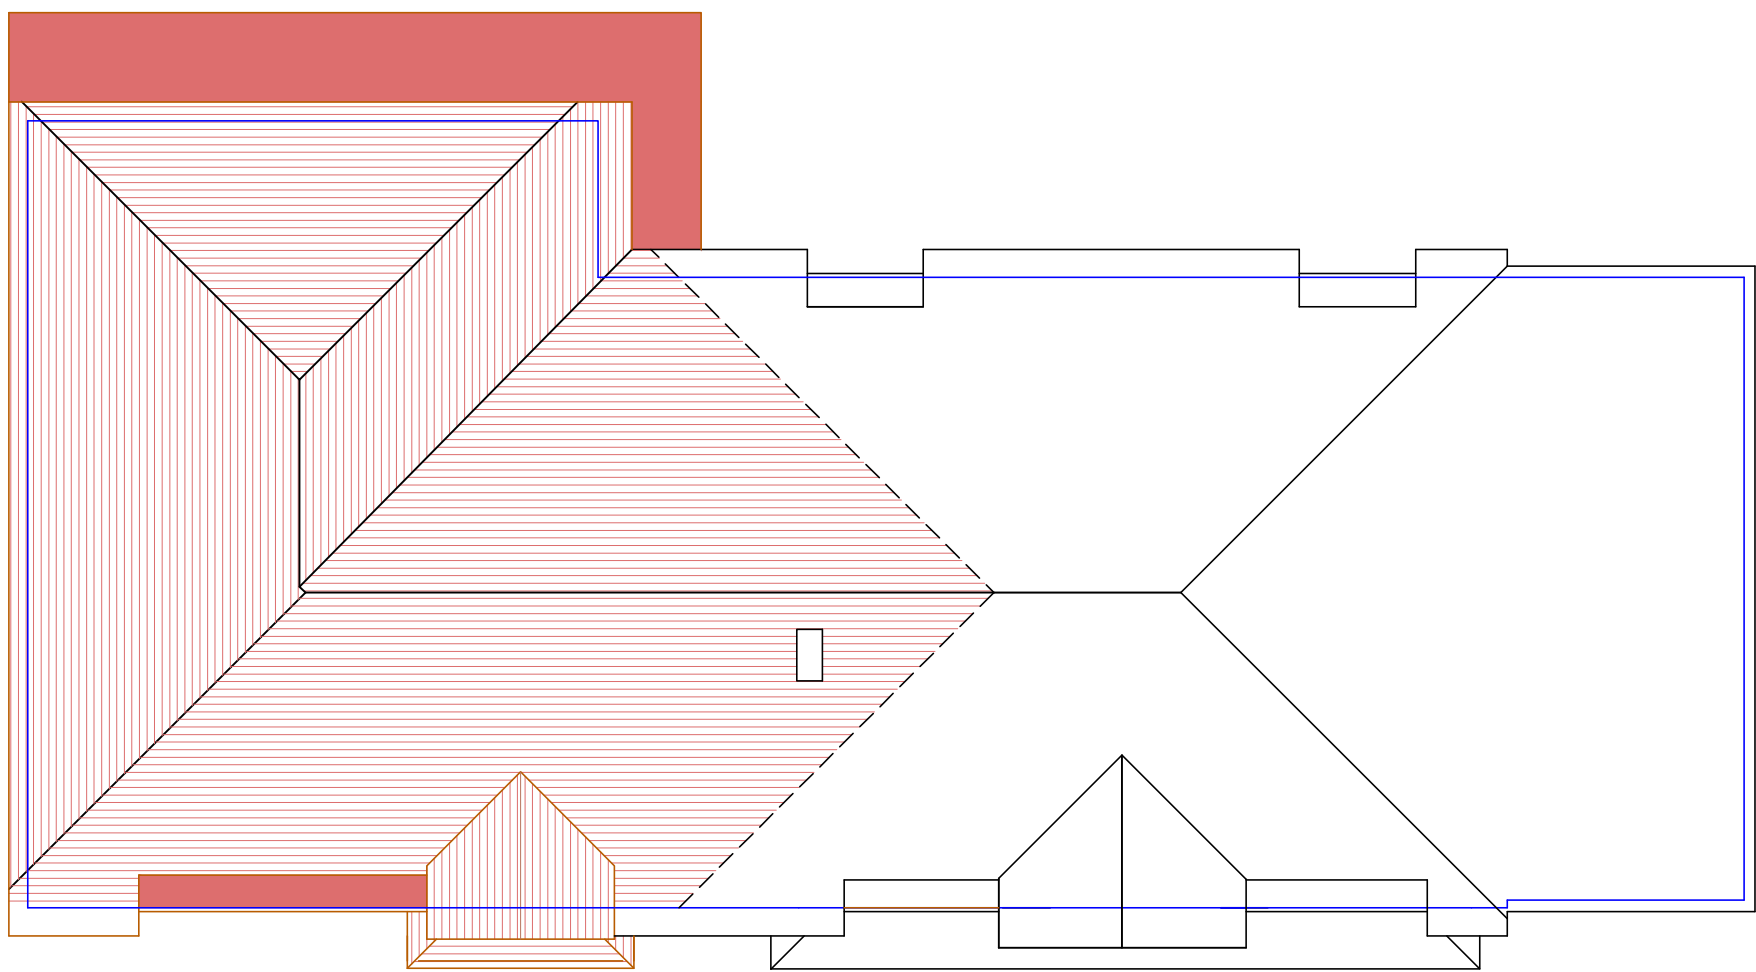


Roof Plan Approved  
under R/275/18/HH  
1:100

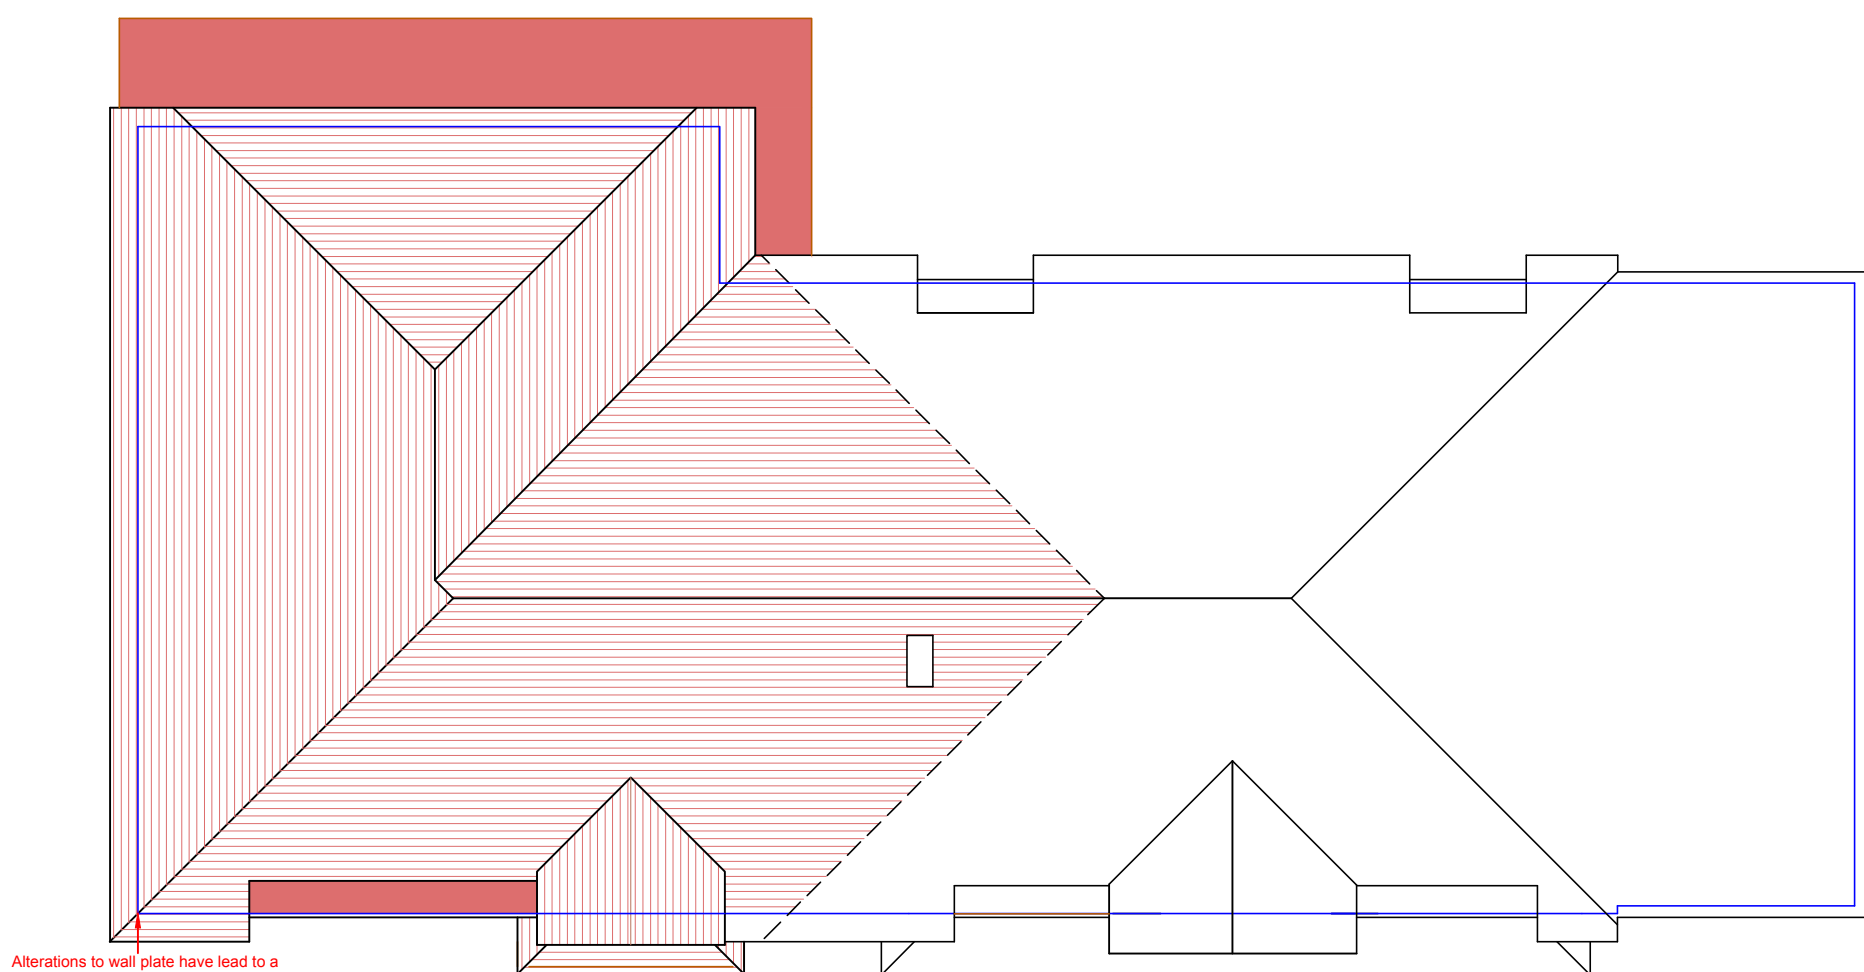

Proposed Roof Plan  
1:100

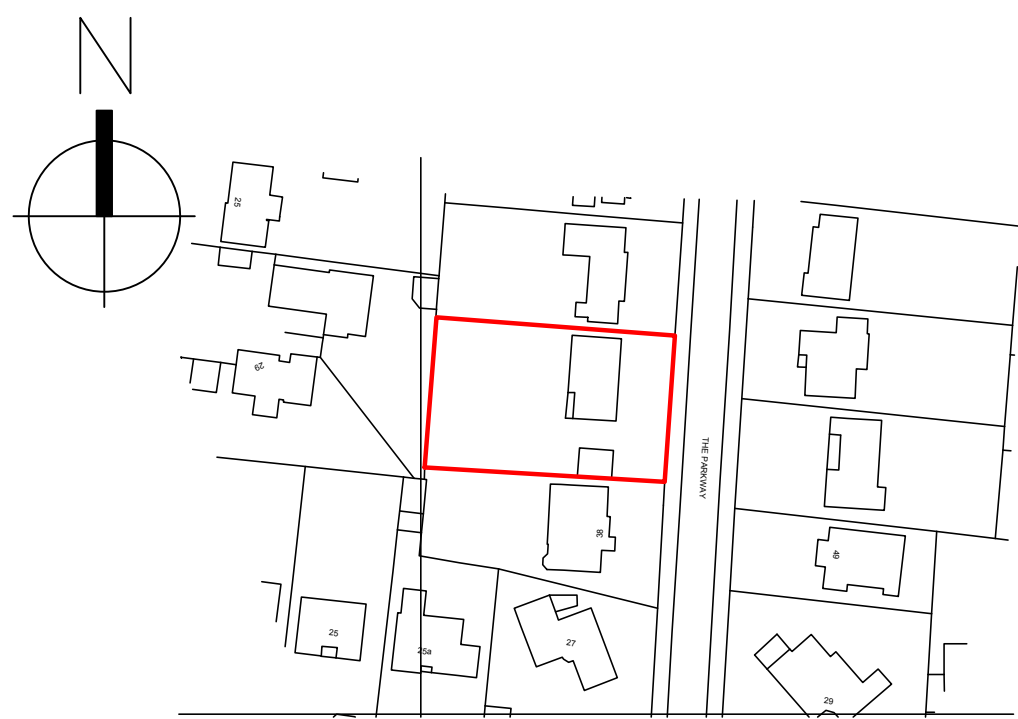

Location Plan  
1:1250

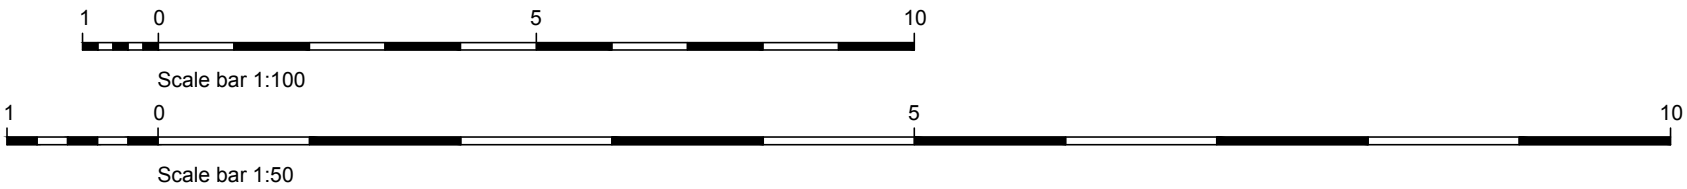

This drawing is the property of Fuller Associates and is not to be copied reproduced, retained or disclosed to any unauthorised person either wholly or in part without prior consent. Do not scale from this drawing except for Planning purposes. Use all figured dimensions only. All figured dimensions to be checked on site prior to construction. All discrepancies, errors and omissions to be reported to Fuller Associates prior to construction. Layout and dimensions existing building to be checked on site.

| Rev. | Details | Date |
|------|---------|------|
|      |         |      |

**FULLER ASSOCIATES**  
Chartered Surveyors • Architectural Design

10-11 The Parade  
Willowhayne Crescent  
East Preston  
West Sussex  
BN16 1NS

01903 774754  
www.fuller-associates.co.uk

| Issued for:          | Drawn | Checked |
|----------------------|-------|---------|
| Discussion           | KW    | DF      |
| Planning Application | KW    | EW      |
| Building Control     | X     | X       |
| Construction Issue   | X     | X       |
| As Built             | X     | X       |

Suggested Alteration to roof - Approved Plans and Approved and Proposed Roof Plan, Location Plan and Block Plan

Client: Mr and Mrs Selva  
Site Address: 36 The Parkway  
Rustington  
BN16 2BU

Printed: As Shown on A1  
Date: 27/02/2019  
Drawing Number: 163034/06