
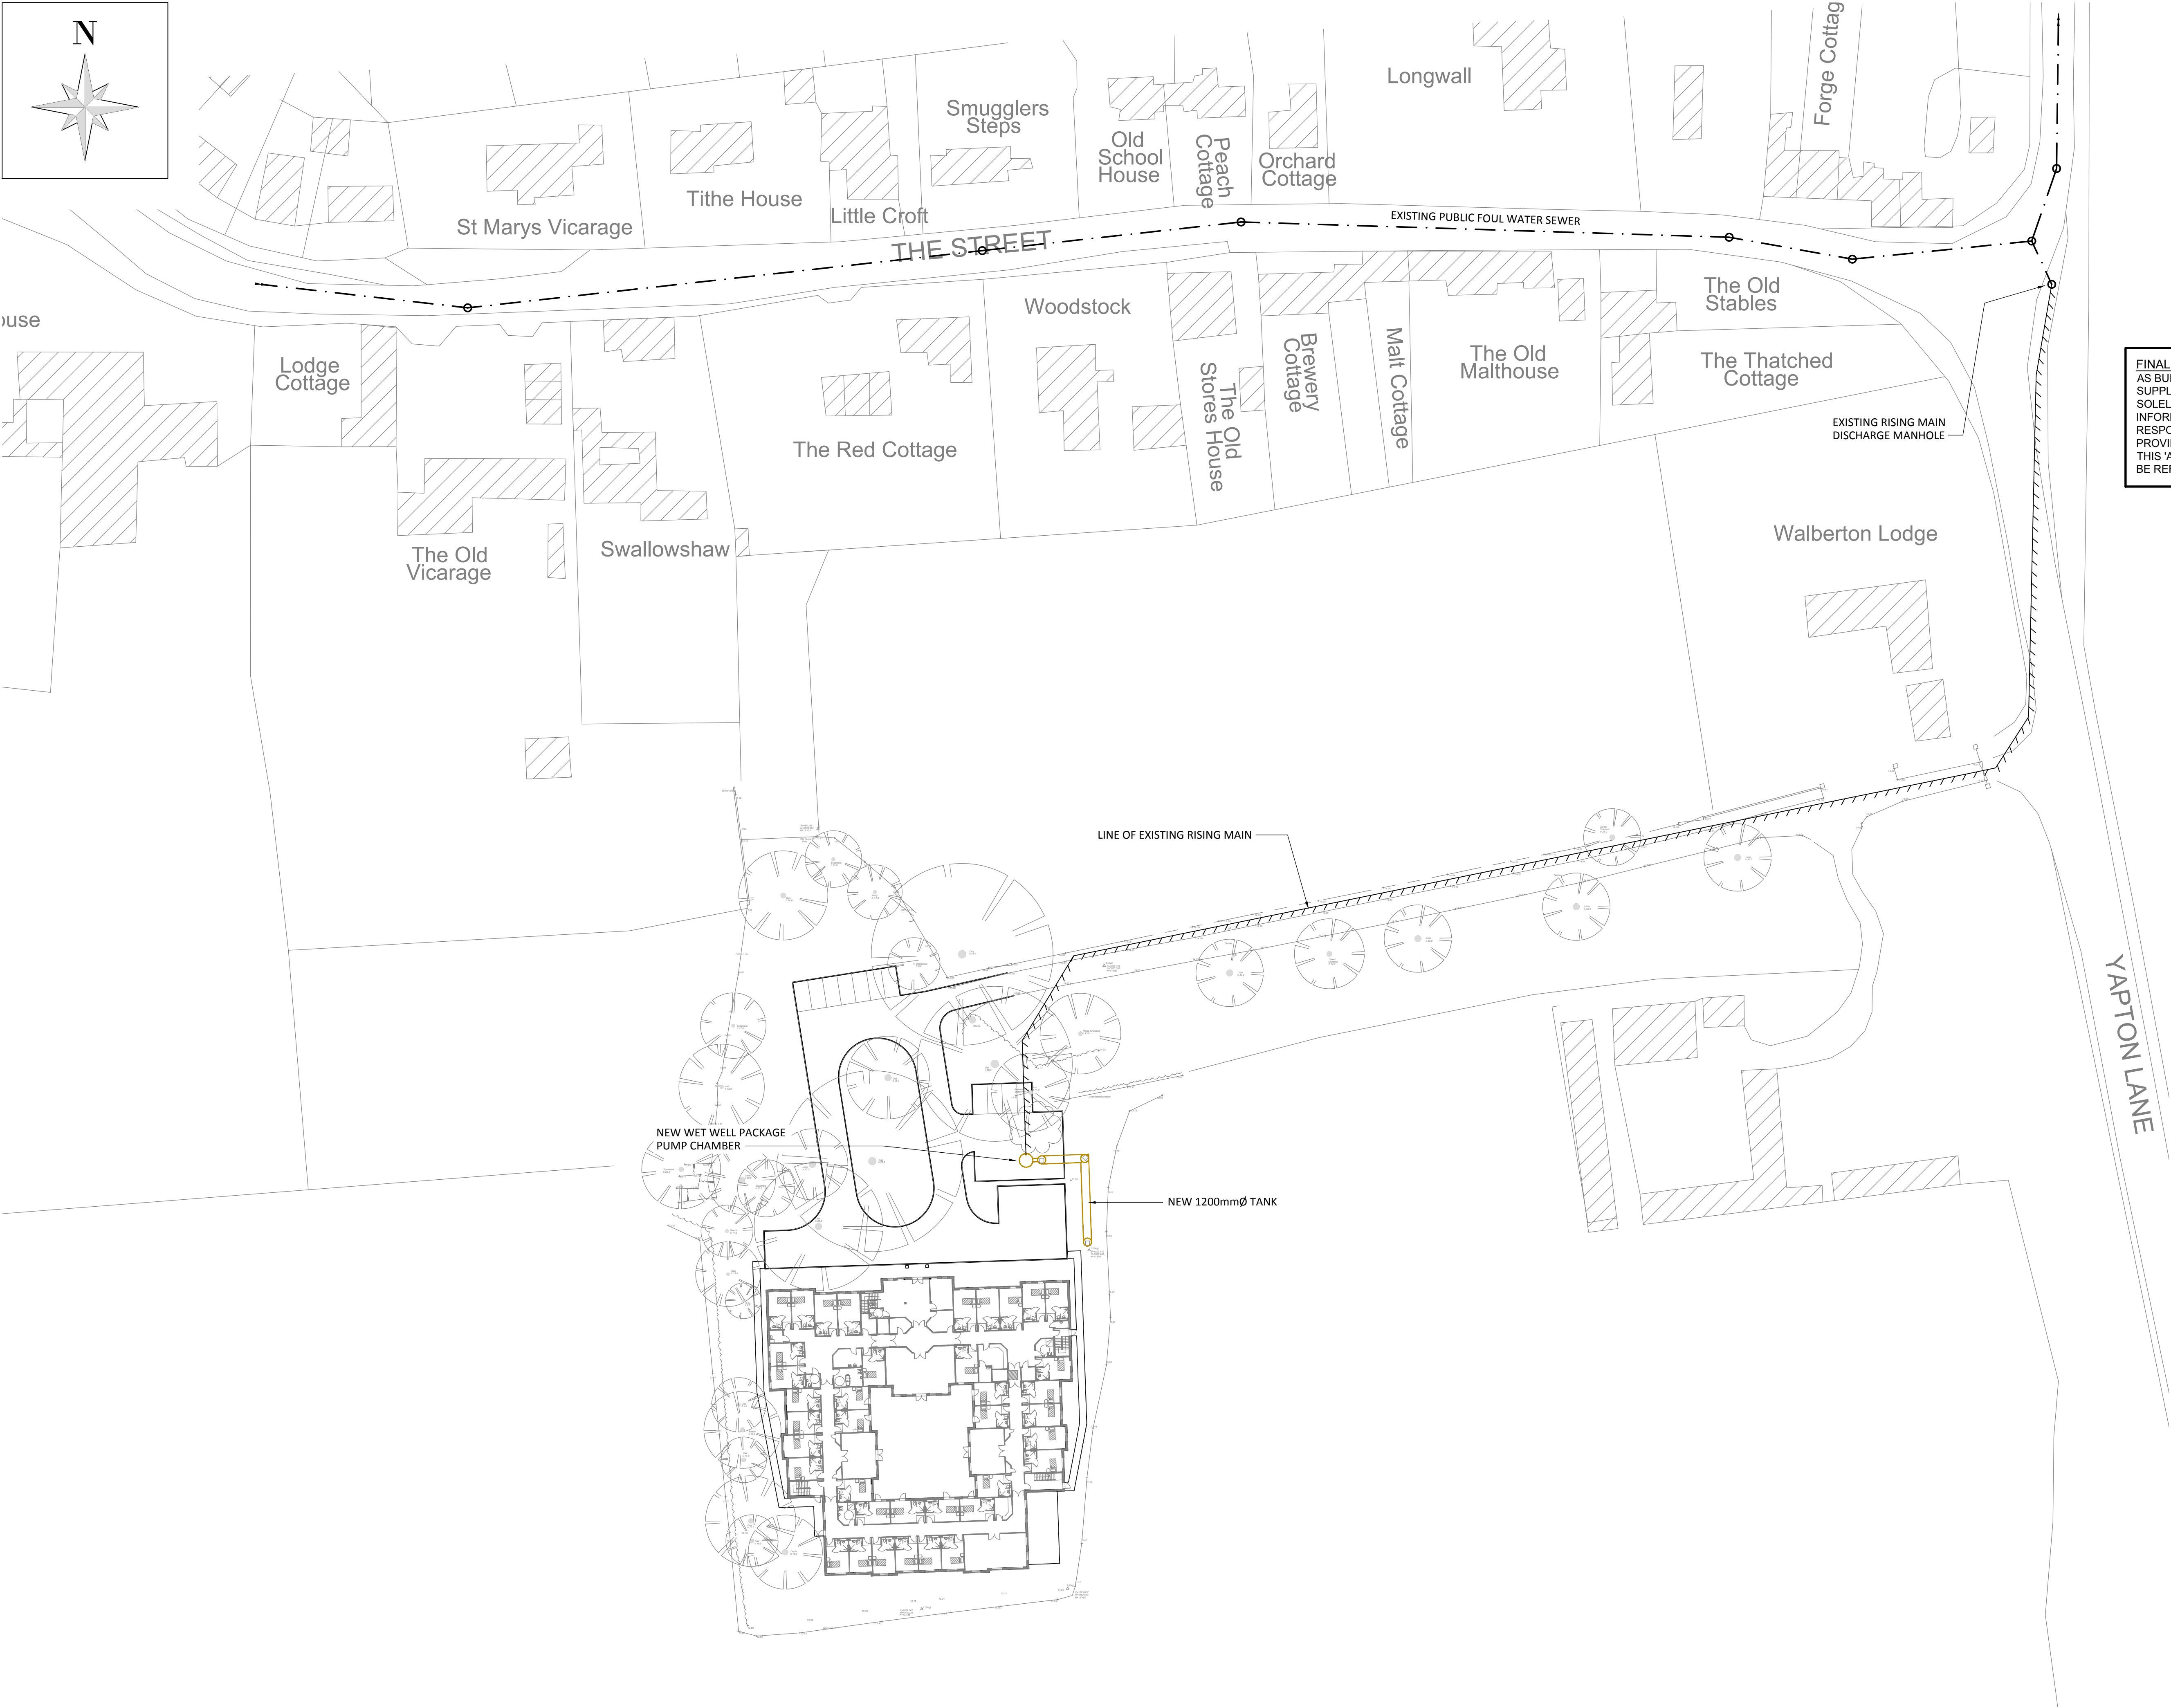


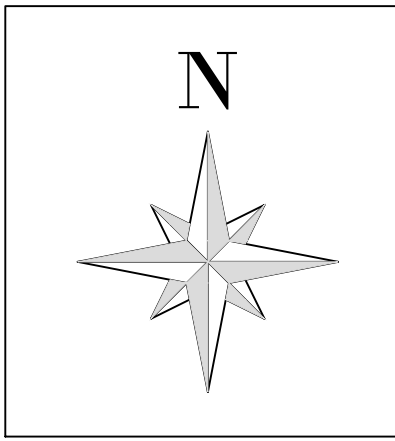

- © 2019 HOWARD WARD ASSOCIATES LTD
- GENERAL NOTES**
1. DRAWING TO BE READ IN CONJUNCTION WITH ALL OTHER RELEVANT ENGINEERING & ARCHITECTURAL DRAWINGS AND SPECIFICATIONS. ANY CONFLICTS BETWEEN THIS DRAWING AND INFORMATION ELSEWHERE TO BE REPORTED TO THE ENGINEER AS SOON AS POSSIBLE.
 2. DO NOT SCALE FROM THIS DRAWING. IF THIS DRAWING HAS BEEN RECEIVED ELECTRONICALLY IT IS THE RESPONSIBILITY OF THE RECIPIENT TO PRINT THE DRAWING TO THE CORRECT SCALE.
 3. ALL DIMENSIONS ARE IN MILLIMETRES UNLESS STATED OTHERWISE. CONTRACTOR TO CHECK ALL DIMENSIONS ON SITE PRIOR TO CONSTRUCTION.
 4. TEMPORARY WORKS INDICATED OR IMPLIED AS PART OF THE PROJECT SHALL BE THE RESPONSIBILITY OF THE CONTRACTOR, UNLESS NOTED OTHERWISE.

FINAL CONSTRUCTION ISSUE:
AS BUILT INFORMATION SHOWN ON THIS DRAWING HAS BEEN SUPPLIED BY THE CONTRACTOR. HWA CONSULTING RELY SOLELY ON THE CONTRACTOR FOR THE PROVISION OF THIS INFORMATION AND HWA CONSULTING ACCEPT NO RESPONSIBILITY FOR THE ACCURACY OF AS BUILT INFORMATION PROVIDED BY THE CONTRACTOR. ANY DISCREPANCY BETWEEN THIS 'AS BUILT' DRAWING AND THE COMPLETED WORKS SHOULD BE REFERRED TO THE CONTRACTOR FOR CLARIFICATION.

C1	TR	AB	FINAL CONSTRUCTION	30.01.19			
P1	AB	GW	ISSUED FOR INFORMATION	17.01.19			
Rev	Drawn	Checked	Description	Date			
Client							
P&R CONSTRUCTION LTD							
Project							
WALBERTON PLACE CARE HOME ARUNDEL							
Title							
INDICATIVE EXISTING OFFSITE DRAINAGE LAYOUT							
 Howard Ward Associates LLP Brewery House, Walkers Yard Nottingham NG12 2FF Tel: 0115 933 2838							
Scale	1:500	Size	A1	Drawn	AB	Checked	GW
Drawing status							
FINAL CONSTRUCTION							
Project no.		Drawing no.			Rev		
P16-063		411			C1		