



See also drg. no. 1679/9 showing photo montage

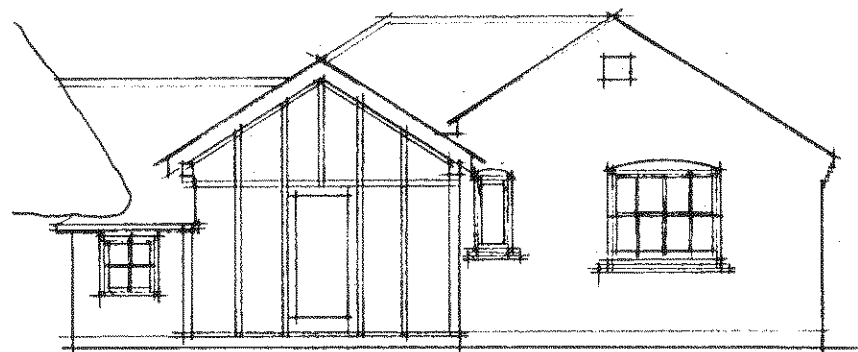


N.

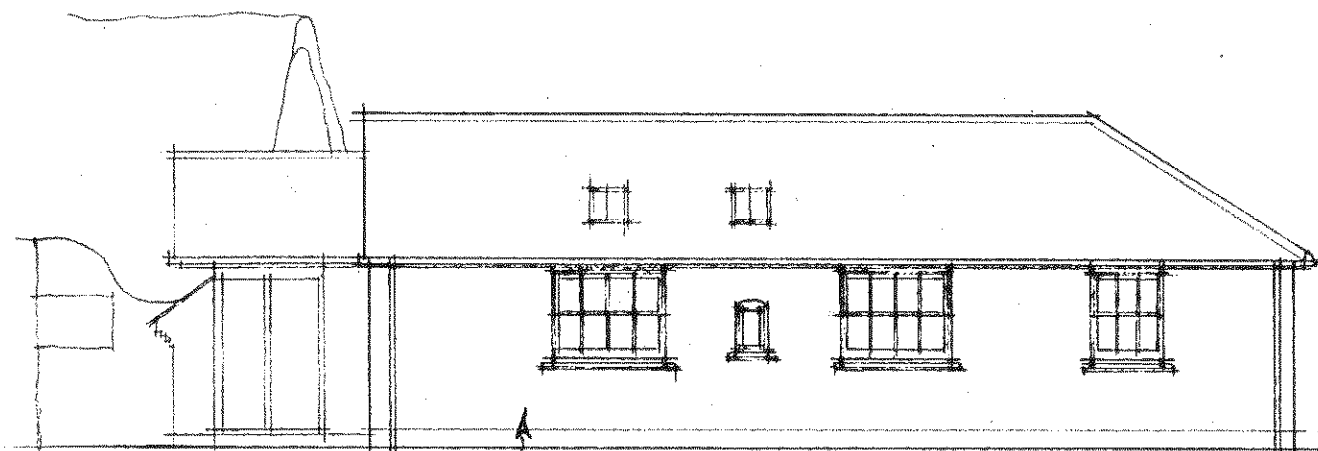


W.

Field Flint walling
with brick dressings
in white mortar

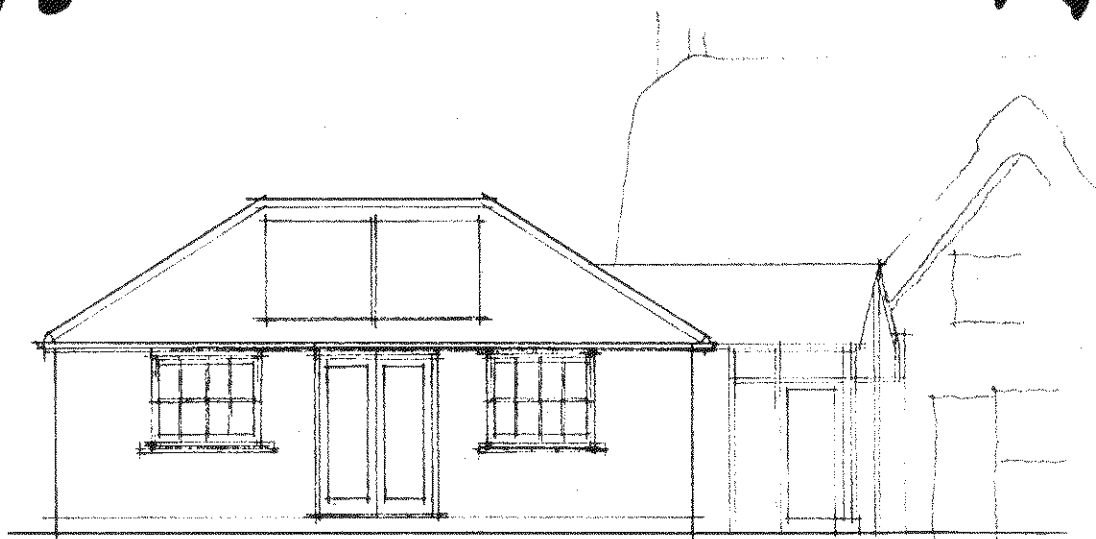

S.

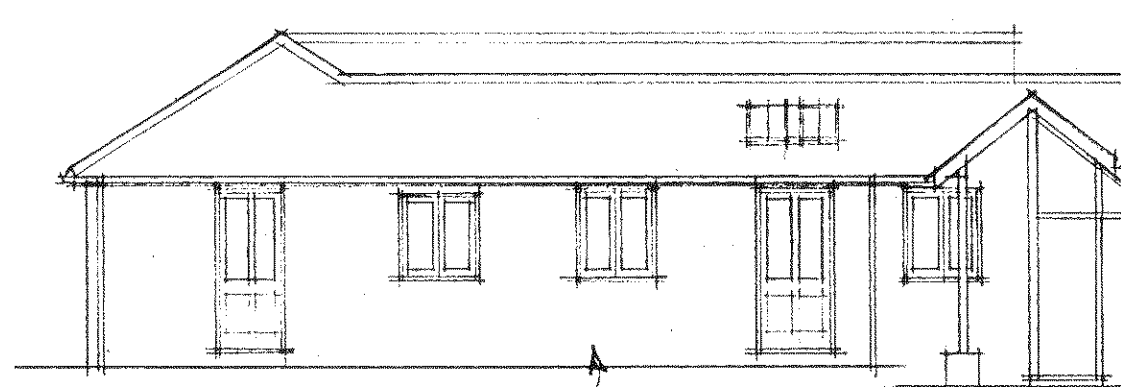

E.

Existing
Coursed rubble walling
with brick dressings

Elevations as Built
Alterations to Annex & Constrn.
of New Glazed Link
Little Box Cottage, The Green,
Walberton BN18 0AT

R. E. OSBORNE - Building Consultant

The Retreat, Southover Way, Hove, Brighton BN1 9NY

Phone/fax 01243 380088 E-mail: reo@phonecoop.coop

Date: Scale(s) @ A3 size: Drg. no.

Jan. 2013 1:100 1679/B

