

Vistry South East Ltd

Avisford Grange, Walberton, West Sussex

March 2023

barter hill



Private parking – 16th July 2025 - complete and functioning

Vistry South East Ltd

Avisford Grange, Walberton, West Sussex

March 2023

barter hill




Private parking and Stedman Avenue – 16th July 2025 - complete and functioning

Vistry South East Ltd

Avisford Grange, Walberton, West Sussex

March 2023

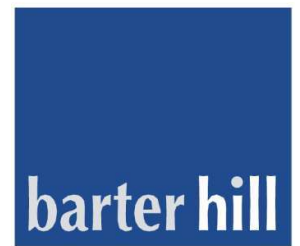

Swale A (East) - 16th July 2025 - complete and functioning

Vistry South East Ltd

Avisford Grange, Walberton, West Sussex

March 2023

barter hill



Swale A/B – 16th July 2025 - complete and functioning

Vistry South East Ltd

Avisford Grange, Walberton, West Sussex

March 2023

barter hill



Swale B (Spur) – 16th July 2025 - complete and functioning

Vistry South East Ltd

Avisford Grange, Walberton, West Sussex

March 2023

barter hill



Swale U – 16th July 2025 - complete and functioning

Vistry South East Ltd

Avisford Grange, Walberton, West Sussex

March 2023

barter hill



Swale V – 16th July 2025 - complete and functioning

Vistry South East Ltd

Avisford Grange, Walberton, West Sussex

March 2023

barter hill



Swale W – 16th July 2025 - complete and functioning

Vistry South East Ltd

Avisford Grange, Walberton, West Sussex

March 2023

barter hill



Swale X – 16th July 2025 - complete and functioning

Vistry South East Ltd

Avisford Grange, Walberton, West Sussex

March 2023

barter hill



Swale Y – 16th July 2025 - complete and functioning

Vistry South East Ltd

Avisford Grange, Walberton, West Sussex

March 2023

barter hill



Swale Z – 16th July 2025 - complete and functioning

Vistry South East Ltd

Avisford Grange, Walberton, West Sussex

March 2023

barter hill



Western Basin – 16th July 2025 - complete and functioning

Vistry South East Ltd


Avisford Grange, Walberton, West Sussex






March 2023



Appendix D

As Constructed Survey

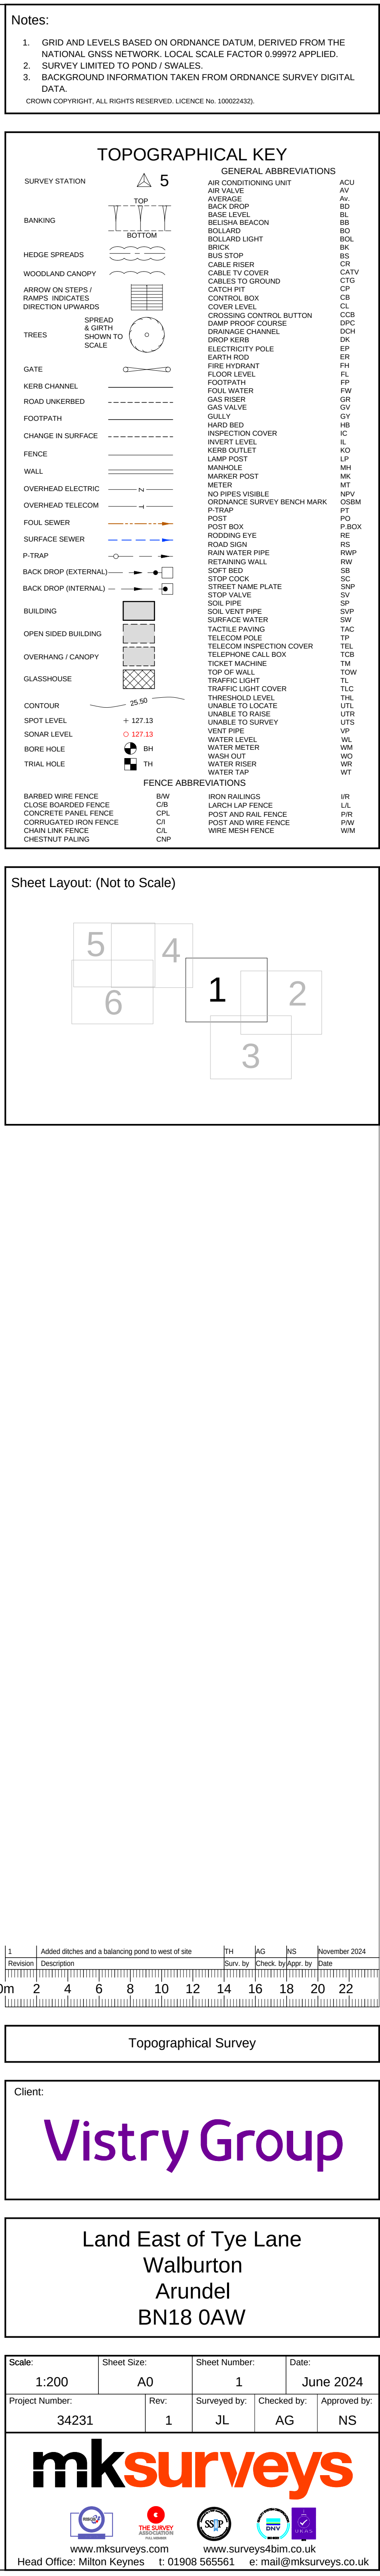

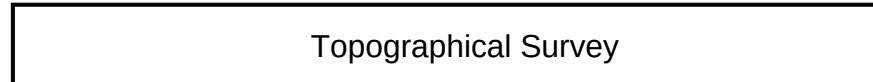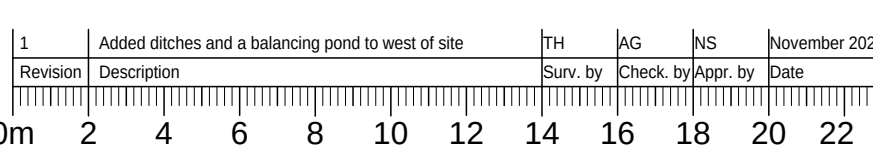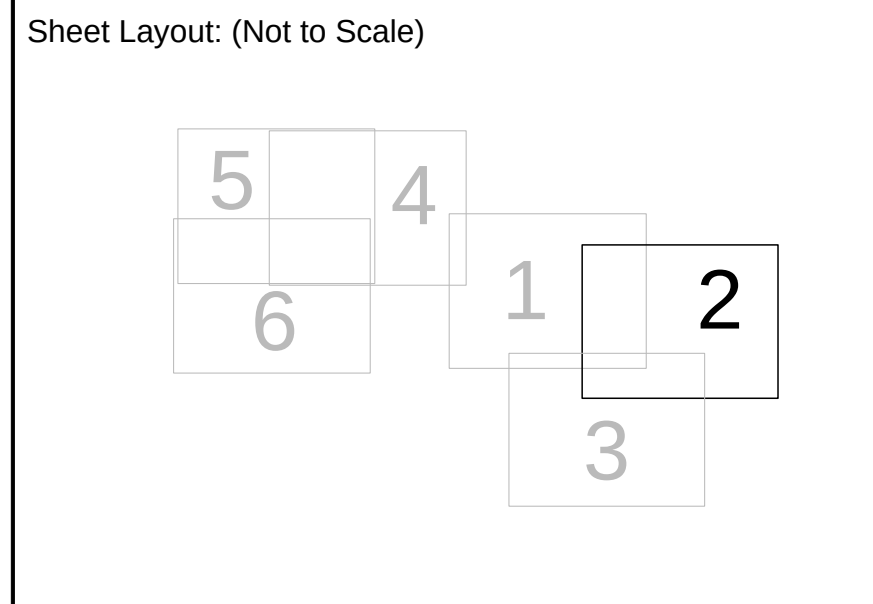
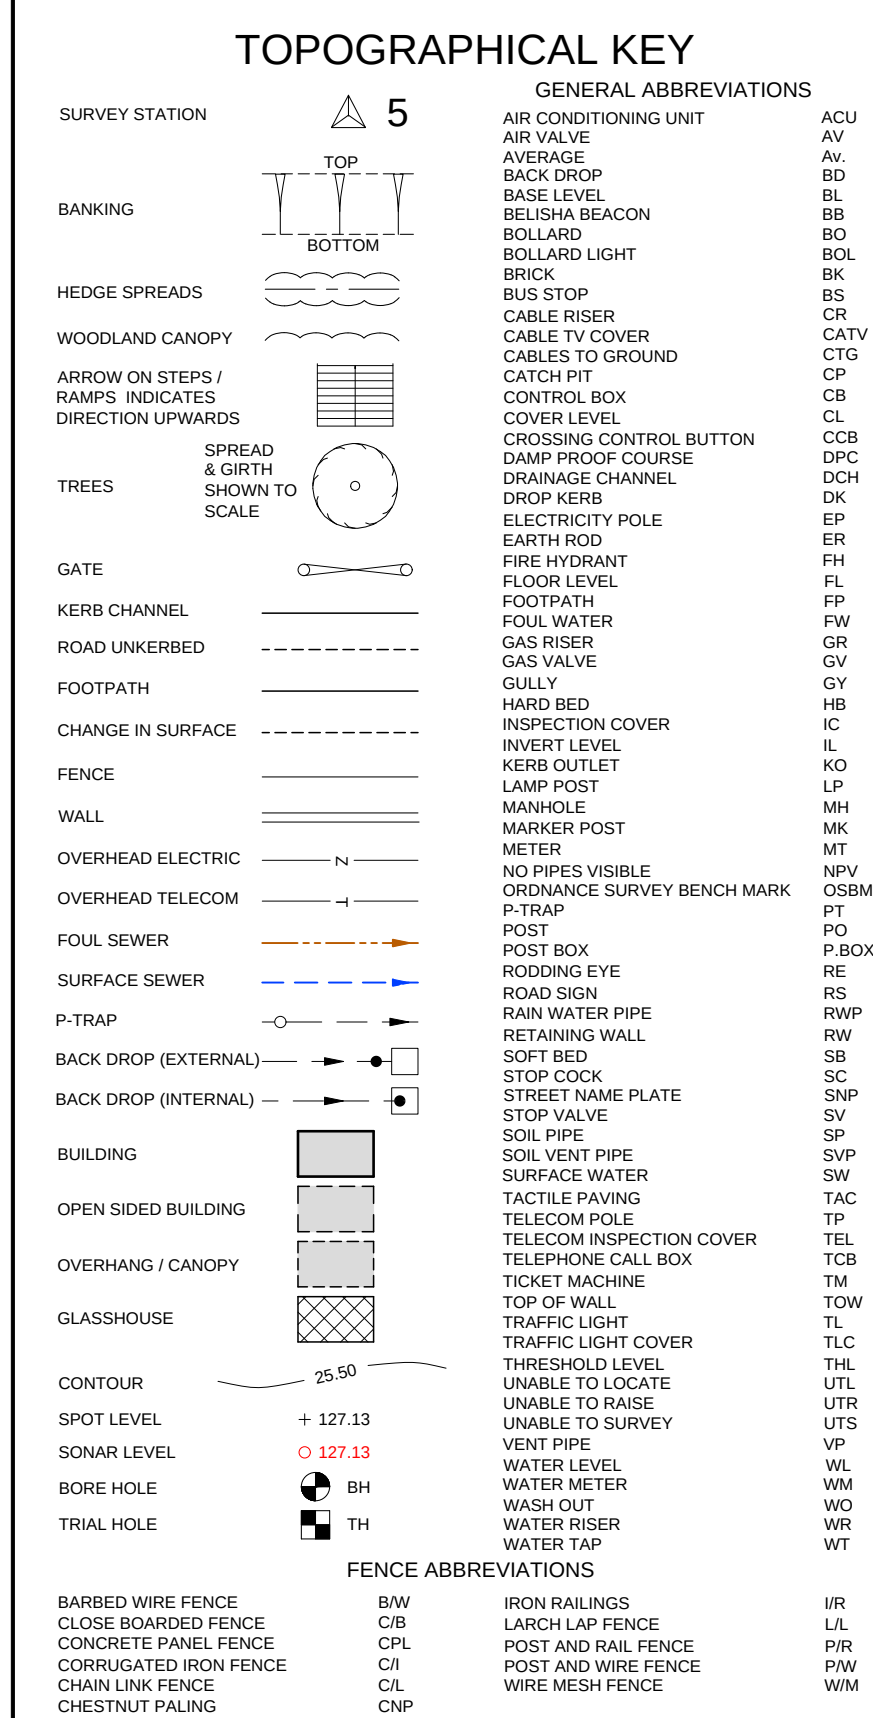
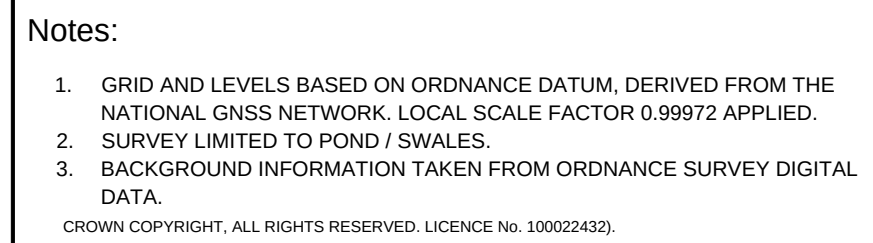


Client:

Vistry Group

Land East of Tye Lane
Walburton
Arundel
BN18 0AW

Scale: 1:200	Sheet Size: A0	Sheet Number: 2	Date: June 2024
Project Number: 34231	Rev: 1	Surveyed by: JL	Checked by: AG
		Approved NS	

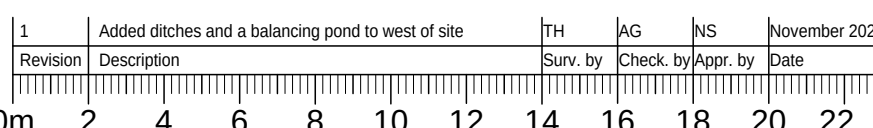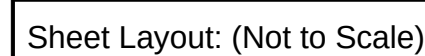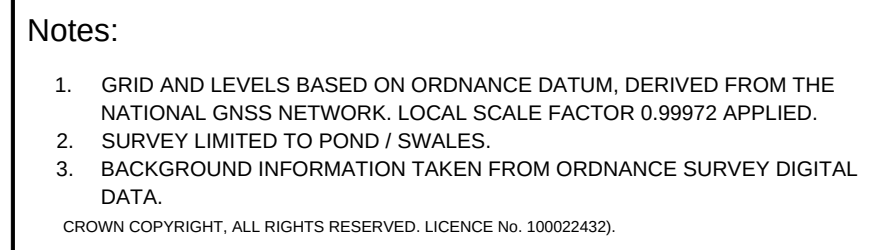

Topographical Survey

Client:

Vistry Group

Land East of Tye Lane
Walburton
Arundel
BN18 0AW

Scale: 1:200	Sheet Size: A0	Sheet Number: 3	Date: June 2024
Project Number: 34231	Rev: 1	Surveyed by: JL	Checked by: AG
		Approved NS	

mk surveys









www.mk-surveys.com
www.surveys4bim.co.uk

Head Office: Milton Keynes t: 01908 565561 e: mail@mk-surveys.co.uk

1. GRID AND LEVELS BASED ON ORDNANCE DATUM, DERIVED FROM THE NATIONAL GNSS NETWORK. LOCAL SCALE FACTOR 0.99972 APPLIED.
2. SURVEY LIMITED TO PONDY SWALES.
3. BACKGROUND INFORMATION TAKEN FROM ORDNANCE SURVEY DIGITAL DATA.

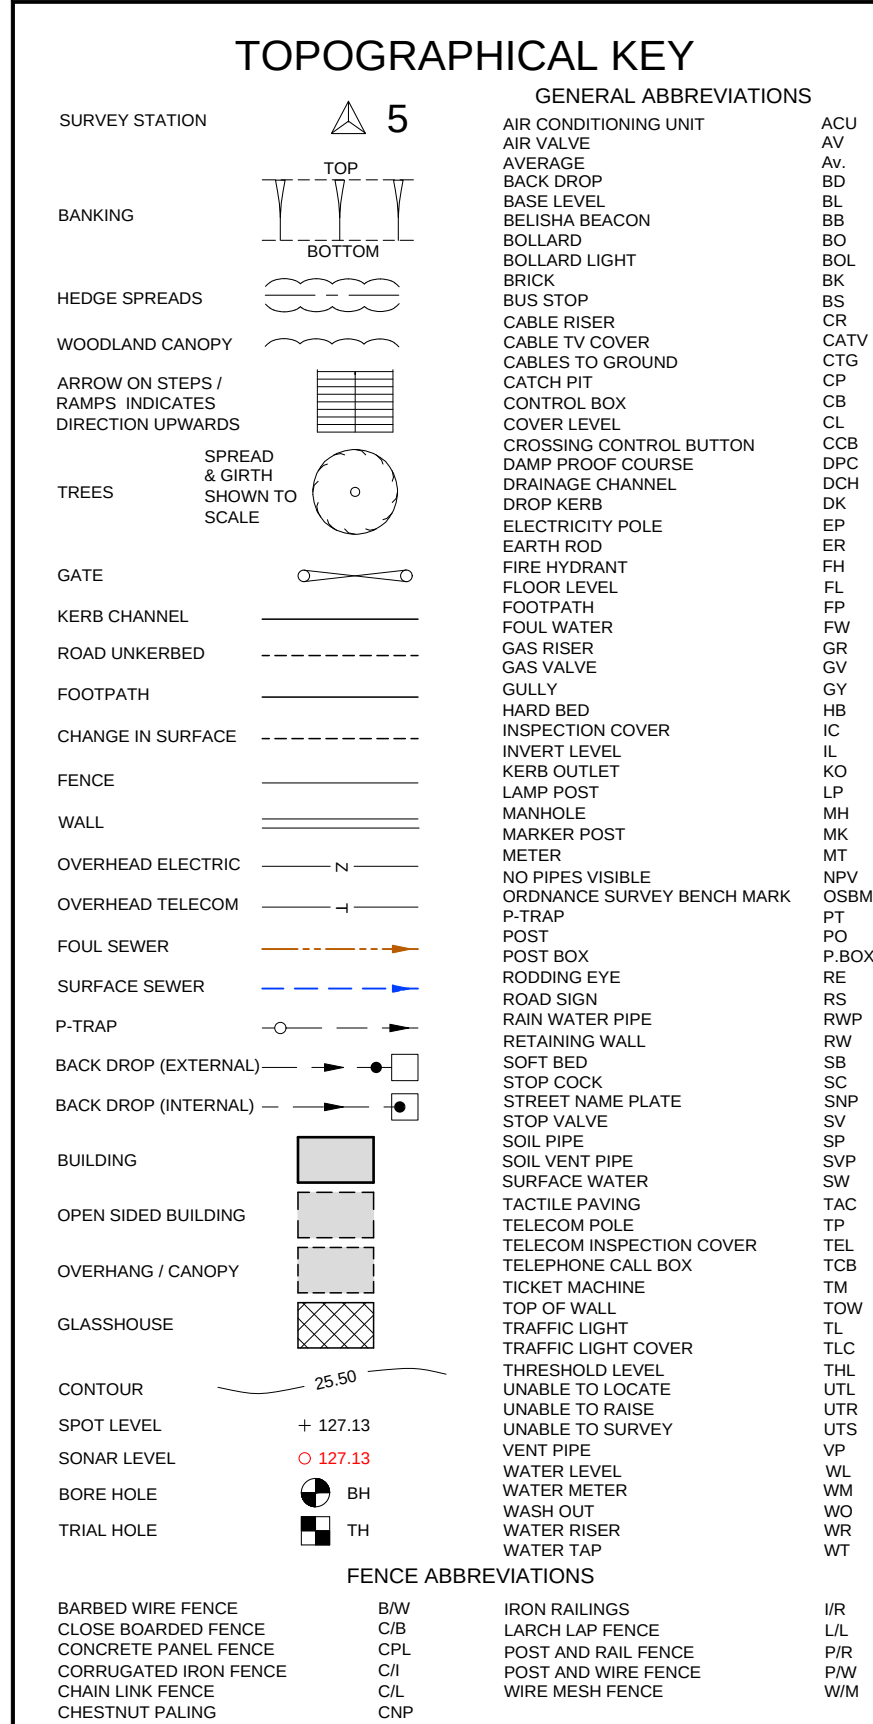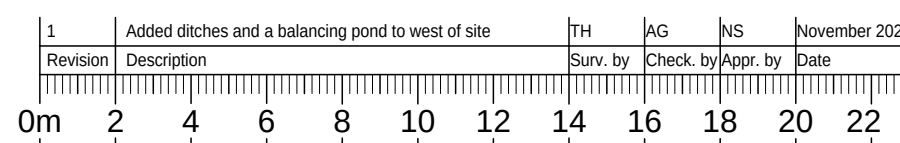[illegible]106250 N

Client:




Land East of Tye Lane
Walburton
Arundel
BN18 0AW

Scale: 1:200	Sheet Size: A0	Sheet Number: 5	Date: June 2024
Project Number: 34231	Rev: 1	Surveyed by: JL	Checked by: AG NS

mksurveys

www.mksurveys.com www.surveys4bim.co.uk
Head Office: Milton Keynes t: 01908 565551 e: mail@mksurveys.co.uk

[illegible]

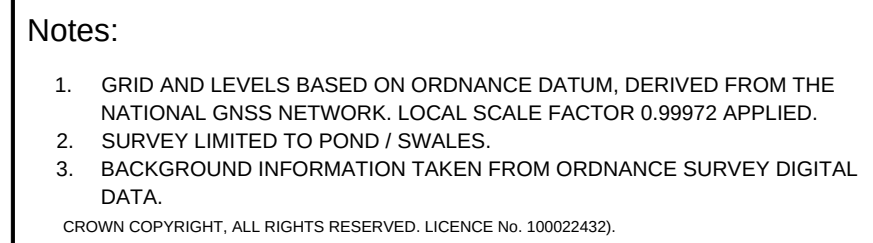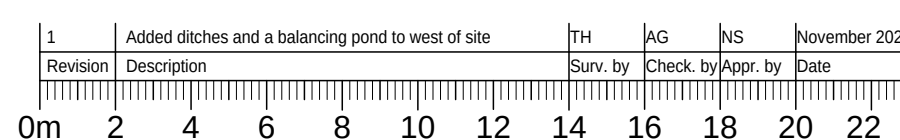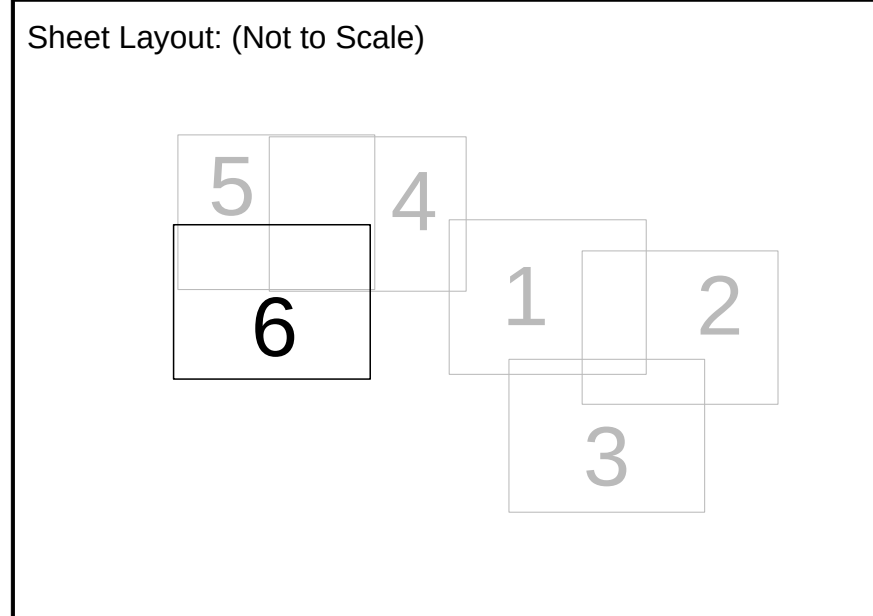Topographical Survey

Client:

Vistry Group

Land East of Tye Lane
Walburton
Arundel
BN18 0AW

Scale: 1:200	Sheet Size: A0	Sheet Number: 6	Date: June 2024
Project Number: 34231	Rev: 1	Surveyed by: JL	Checked by: AG
		Approved NS	

mk surveys








www.mk-surveys.com
www.surveys4bim.co.uk

Head Office: Milton Keynes t: 01908 565561 e: mail@mk-surveys.co.uk

Vistry South East Ltd

Avisford Grange, Walberton, West Sussex

March 2023

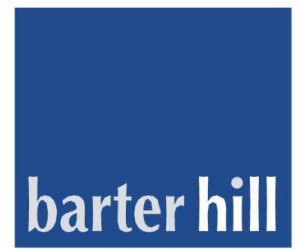

Appendix E

Professional Indemnity Insurance