



Scale
1:1250

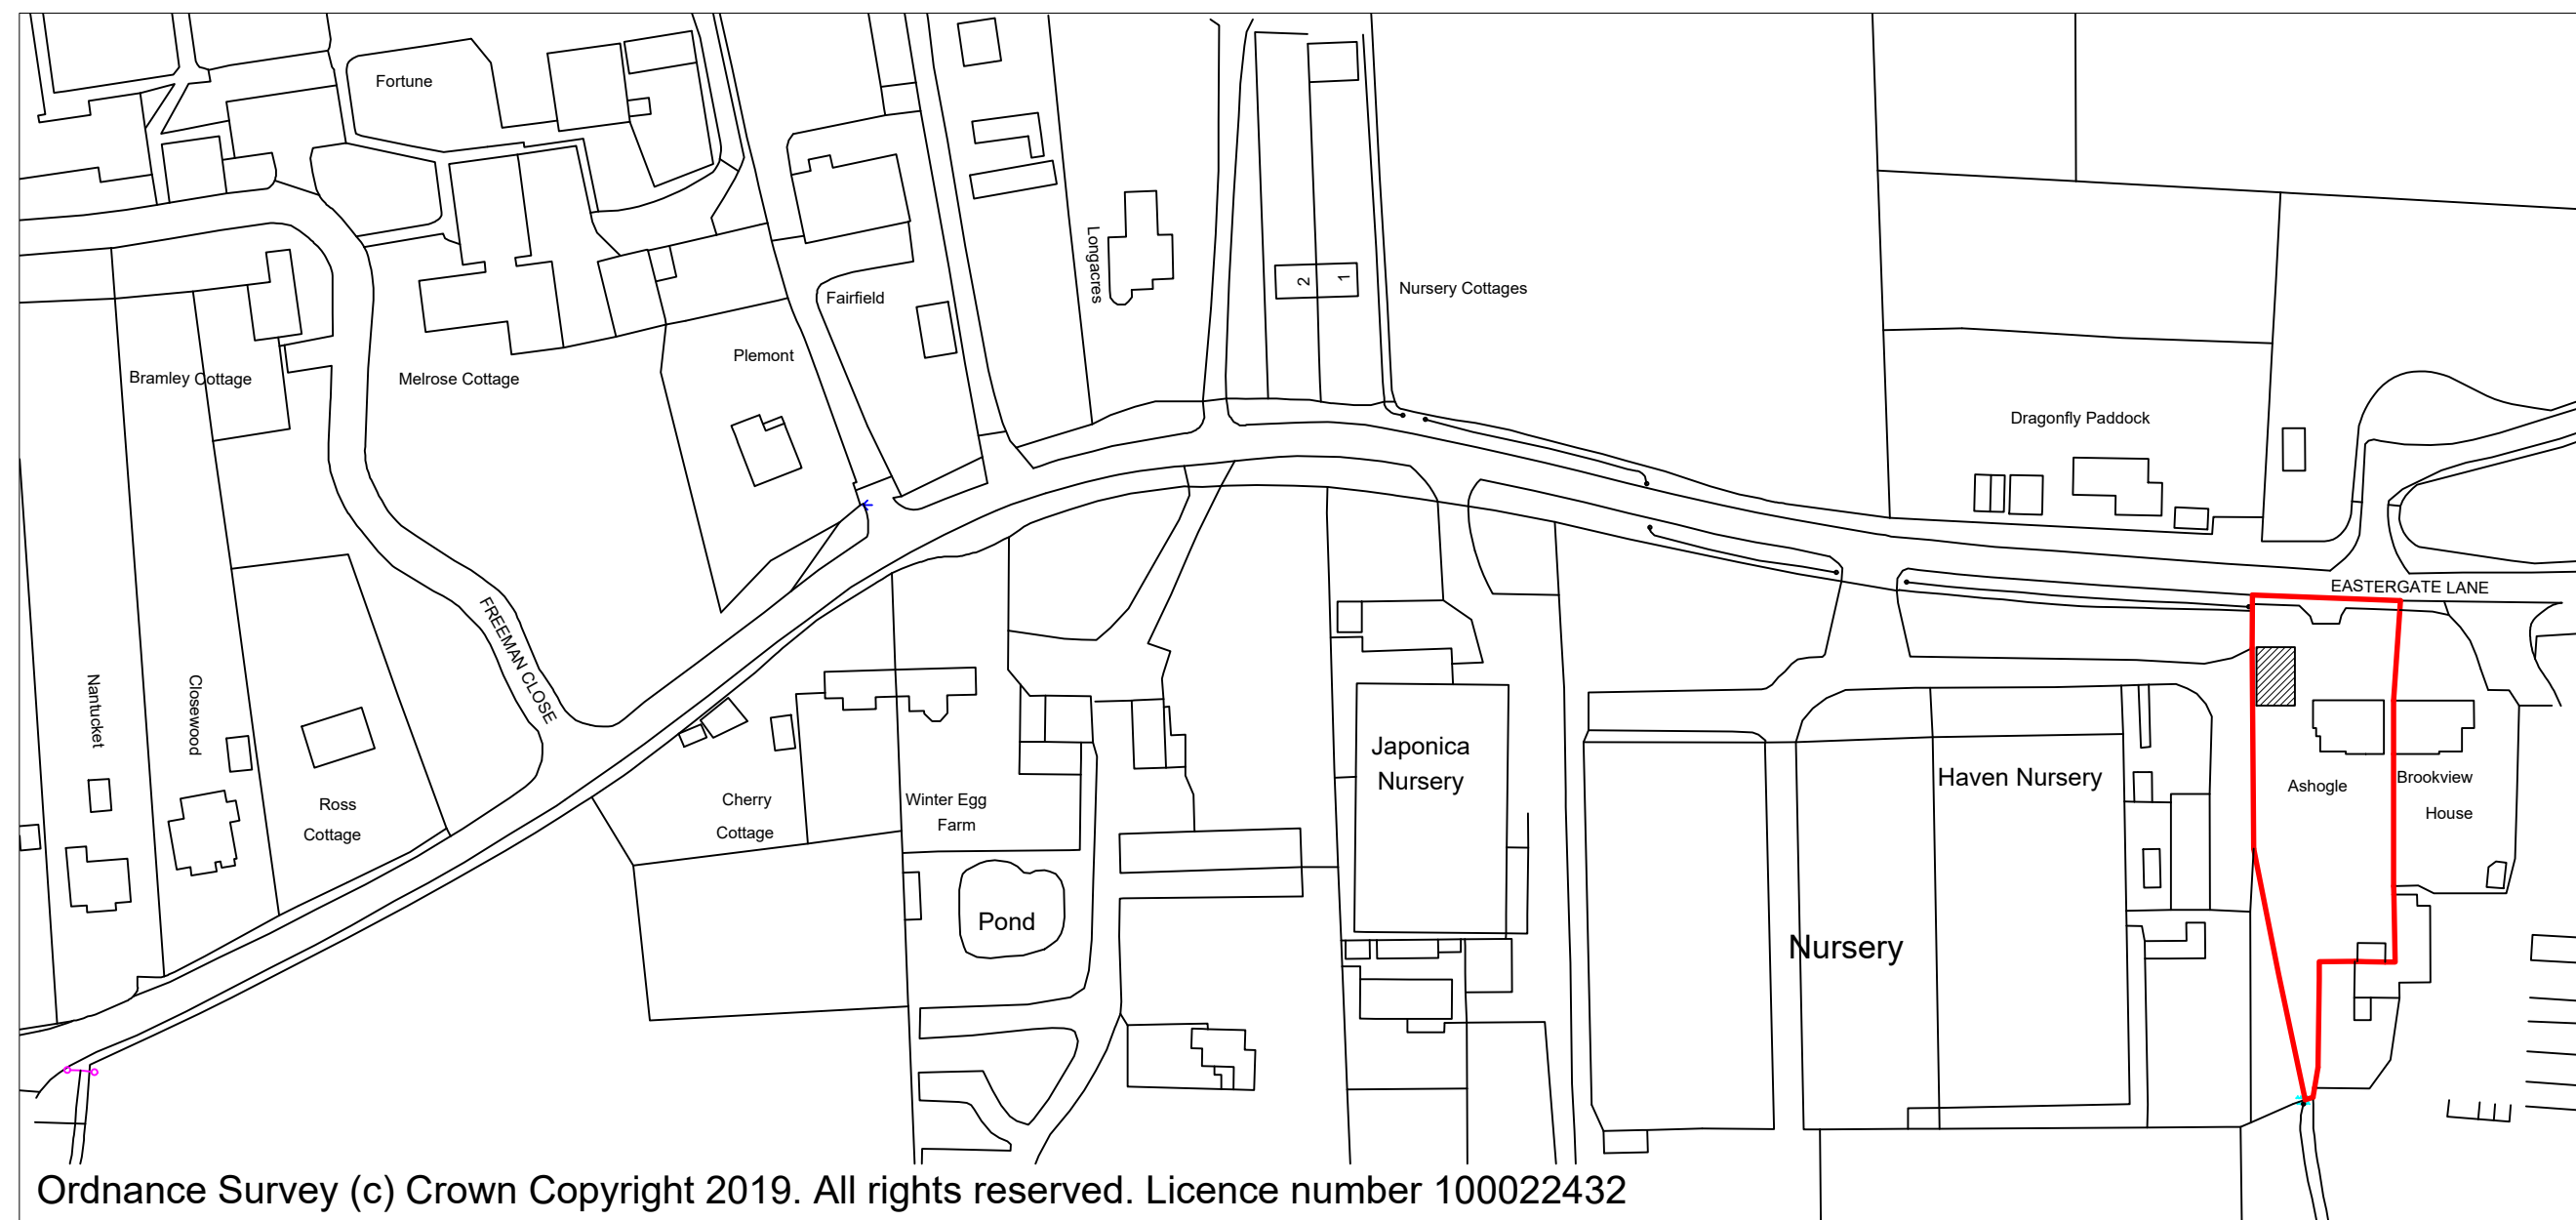


Ordnance Survey (c) Crown Copyright 2019. All rights reserved. Licence number 100022432


Location Plan
Scale 1:1250

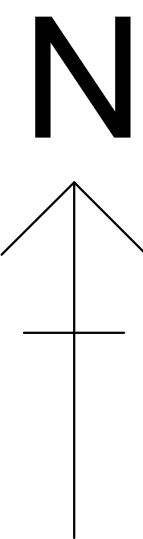


Scale
1:100

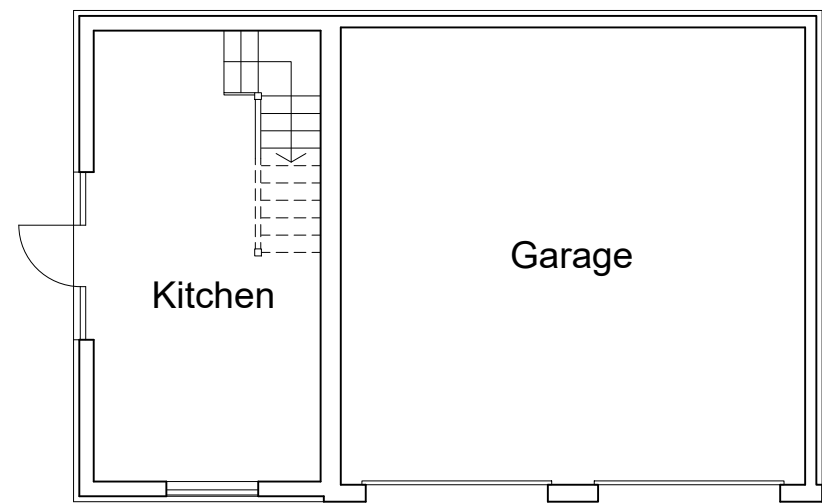


Ground Floor Plan
Scale 1:100

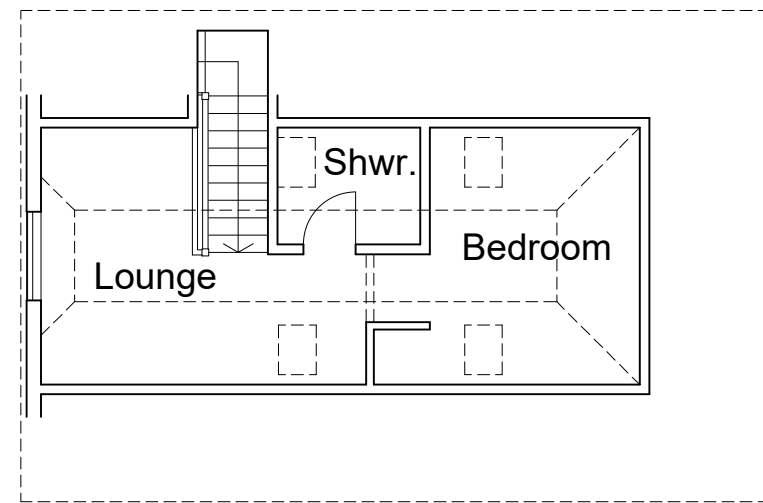

First Floor Plan
Scale 1:100

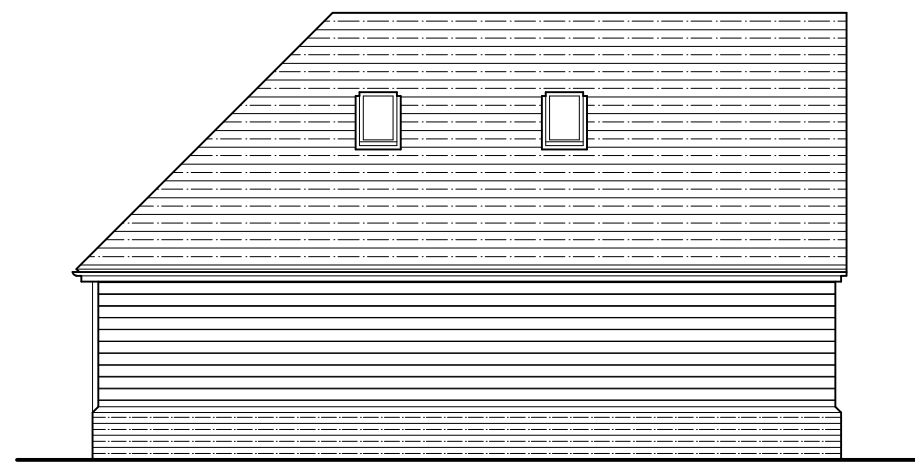

Rear (west) Elevation
Scale 1:100

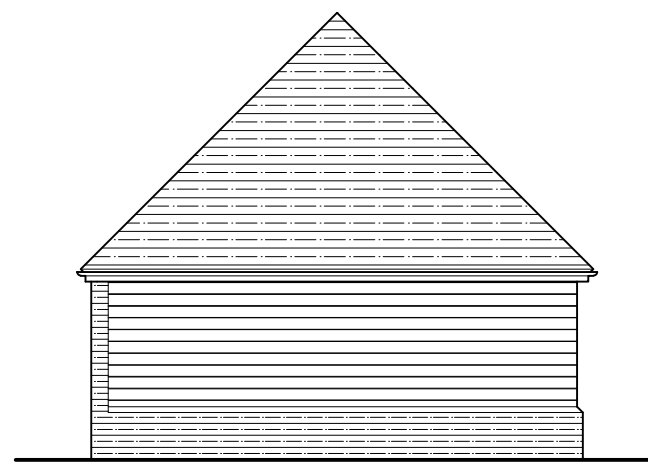

Side (north) Elevation
Scale 1:100




Front (east) Elevation
Scale 1:100



Side (south) Elevation
Scale 1:100

Scale
1:200

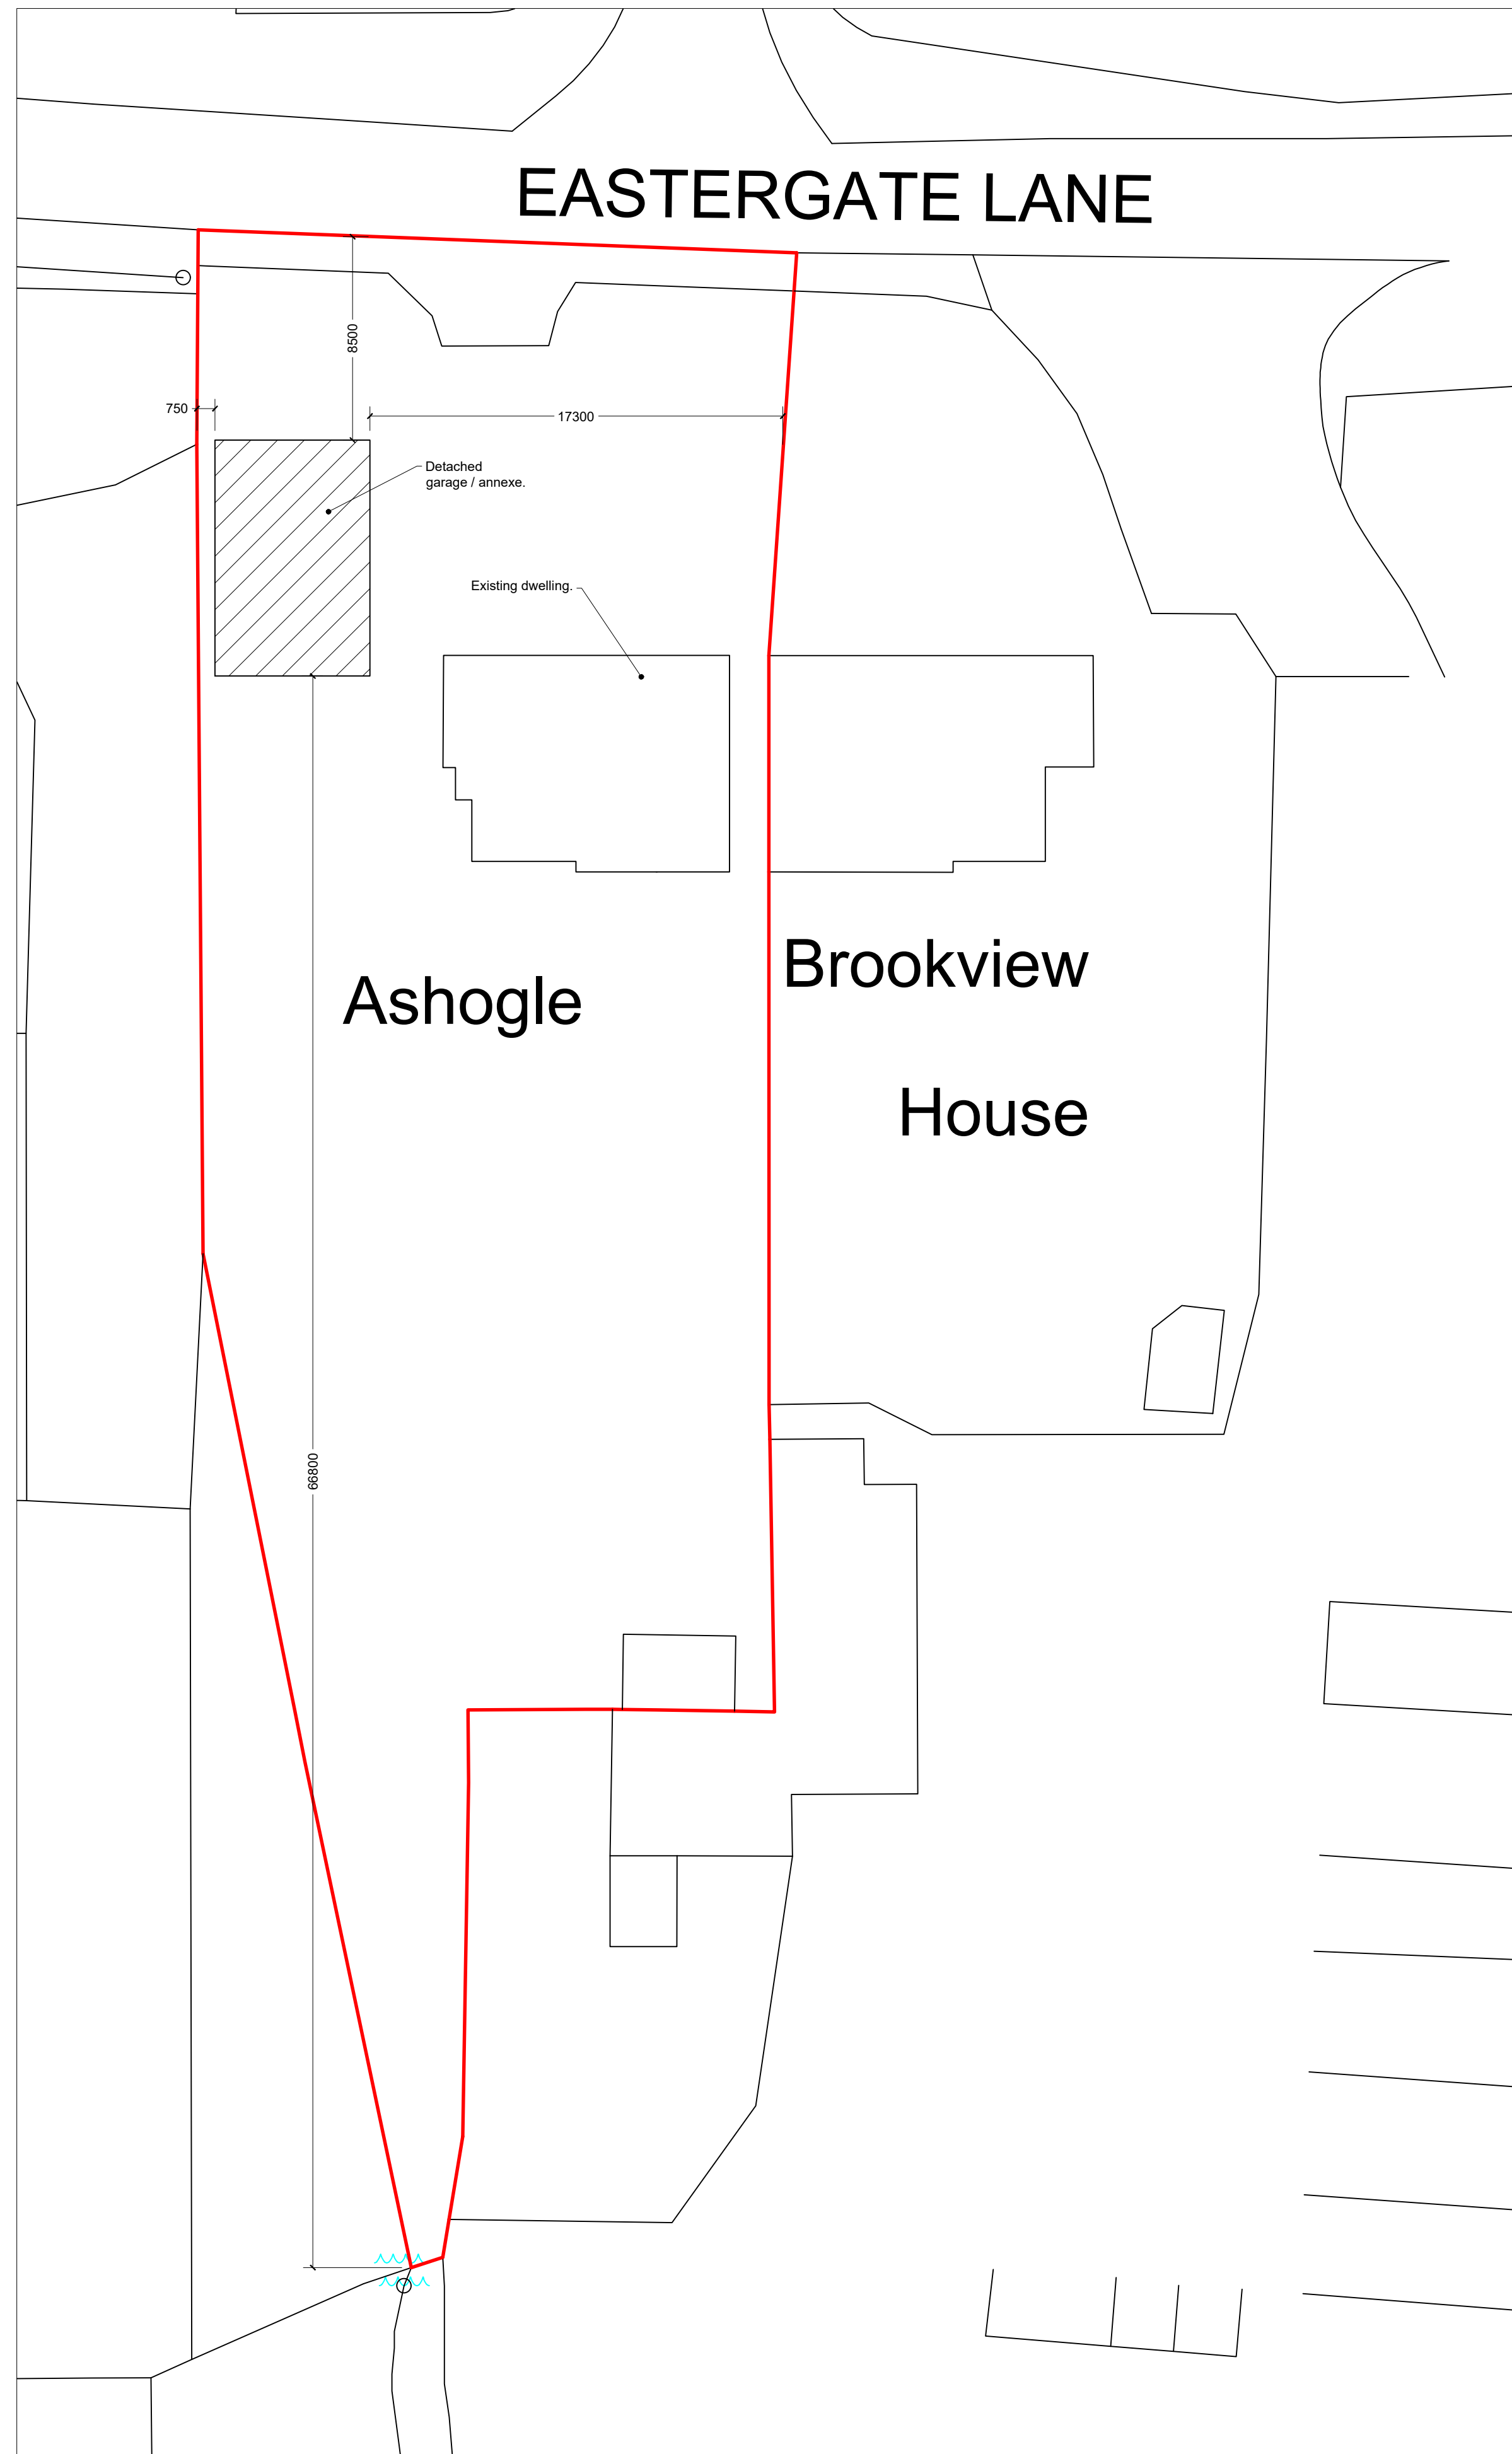

Block Plan
Scale 1:200

B Further dimensions added. 06.02.19
A Dimensions added to block plan. 05.02.19

Rev: Description: Date:

HORIZON DESIGN
ARCHITECTURAL TECHNOLOGY
Horizon Design Limited
15 Uplands Avenue
Worthing BN11 1UR
01903 205868
info@horizon-design.co.uk www.horizon-design.co.uk

Client:
Mr Sowden

Project:
Detached Annexe to:
Ashogle
Eastergate Lane
Walberton
West Sussex, BN18 0BA

Drawing title:
Floor Plans & Elevations - As-Built,
Location & Block Plans.

Scale:
1:100 / 1:1250 / 1:200 @ A1

Date:
16.01.19

Drawn:
KWF

Drawing number:
2943-01

Revision:
B