


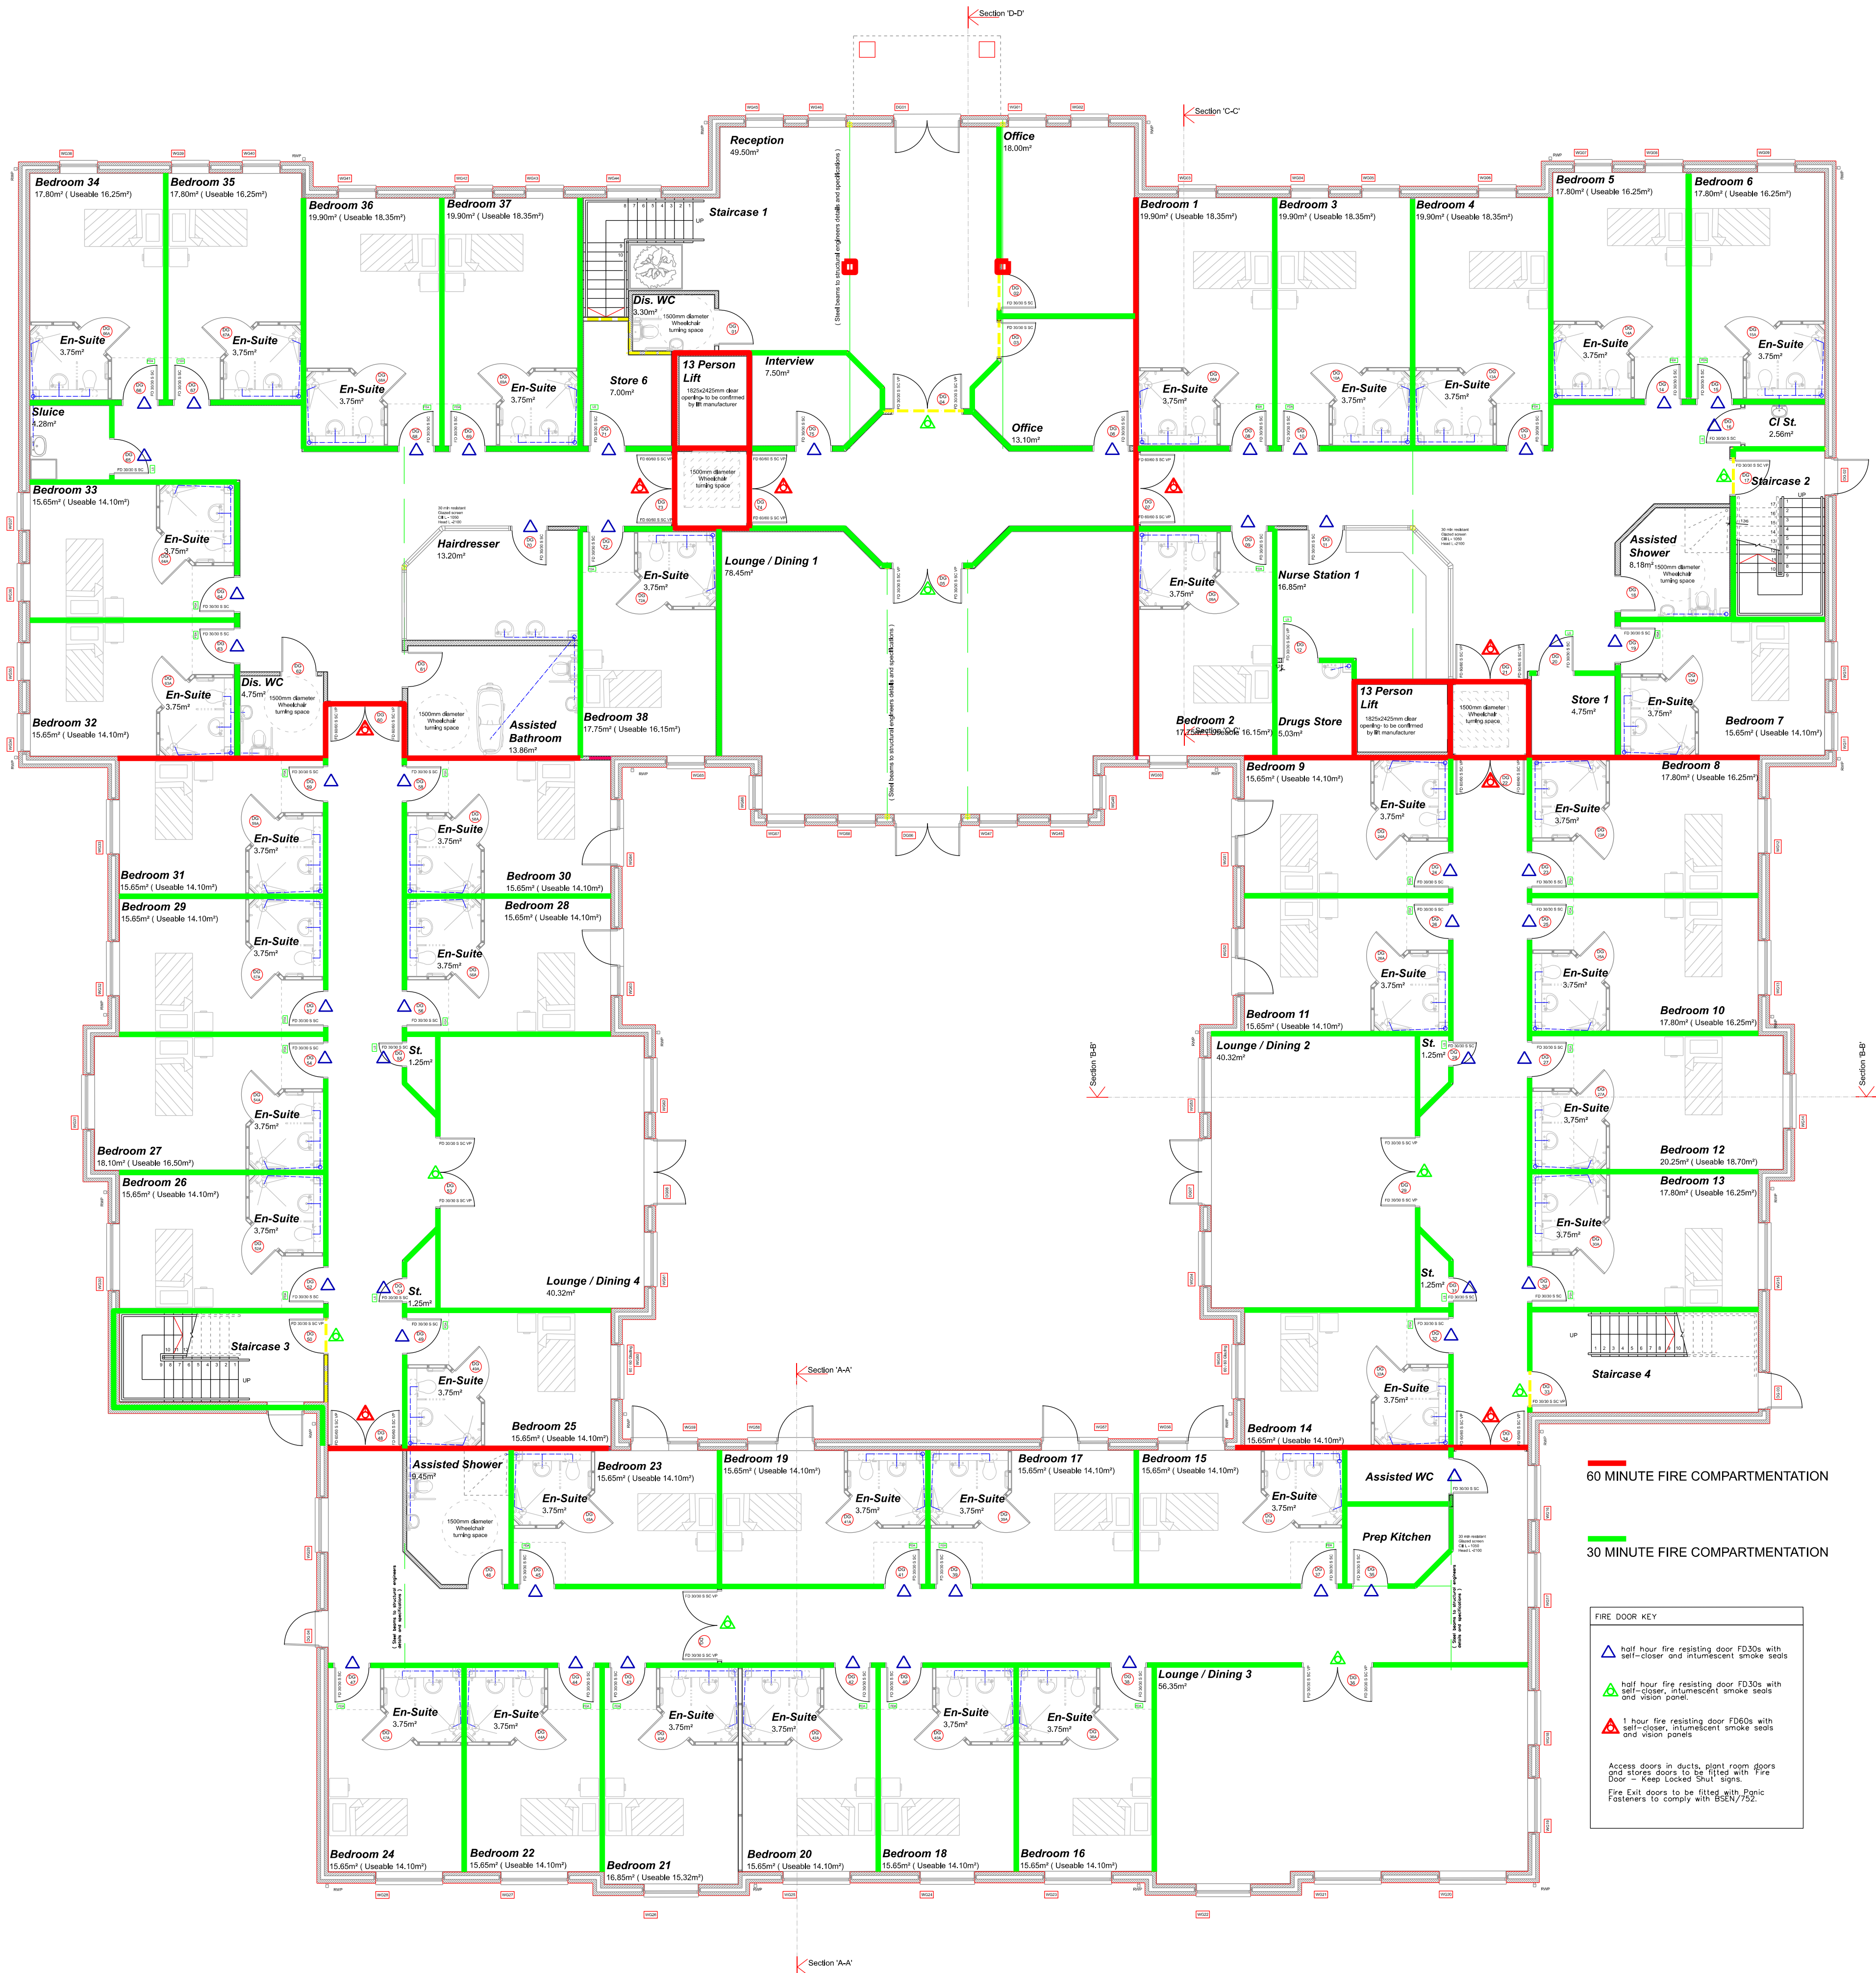

AS BUILT GROUND FLOOR FIRE STRATEGY PLAN

REVISION	NORTH

STAGE:	AS BUILT
PROJECT	WALBERTON PLACE CARE HOME YAPTON LANE WALBERTON ARUNDEL WEST SUSSEX BN15 0AS

DRAWING	GROUND FLOOR FIRE STRATEGY PLAN
---------	---------------------------------

PROJECT NO.	DRAWING NO.	REVISION
3112	L-07	
DATE	SCALES	DRAWN BY
APR '19	1:100@A1	

MARIO MINCHELLA ARCHITECTS

UNIT 4, WITNEY WAY, HI-TECH VILLAGE, BOLDON BUSINESS PARK TYNE AND WEAR NE35 9PE T: 0191 3802227 W: www.mma.net E: info@mma.net	
--	--

THIS DRAWING IS COPYRIGHT OF DMM LIMITED	NOT TO BE SCALED ALL DIMENSIONS TO BE CHECKED ON SITE
--	---