


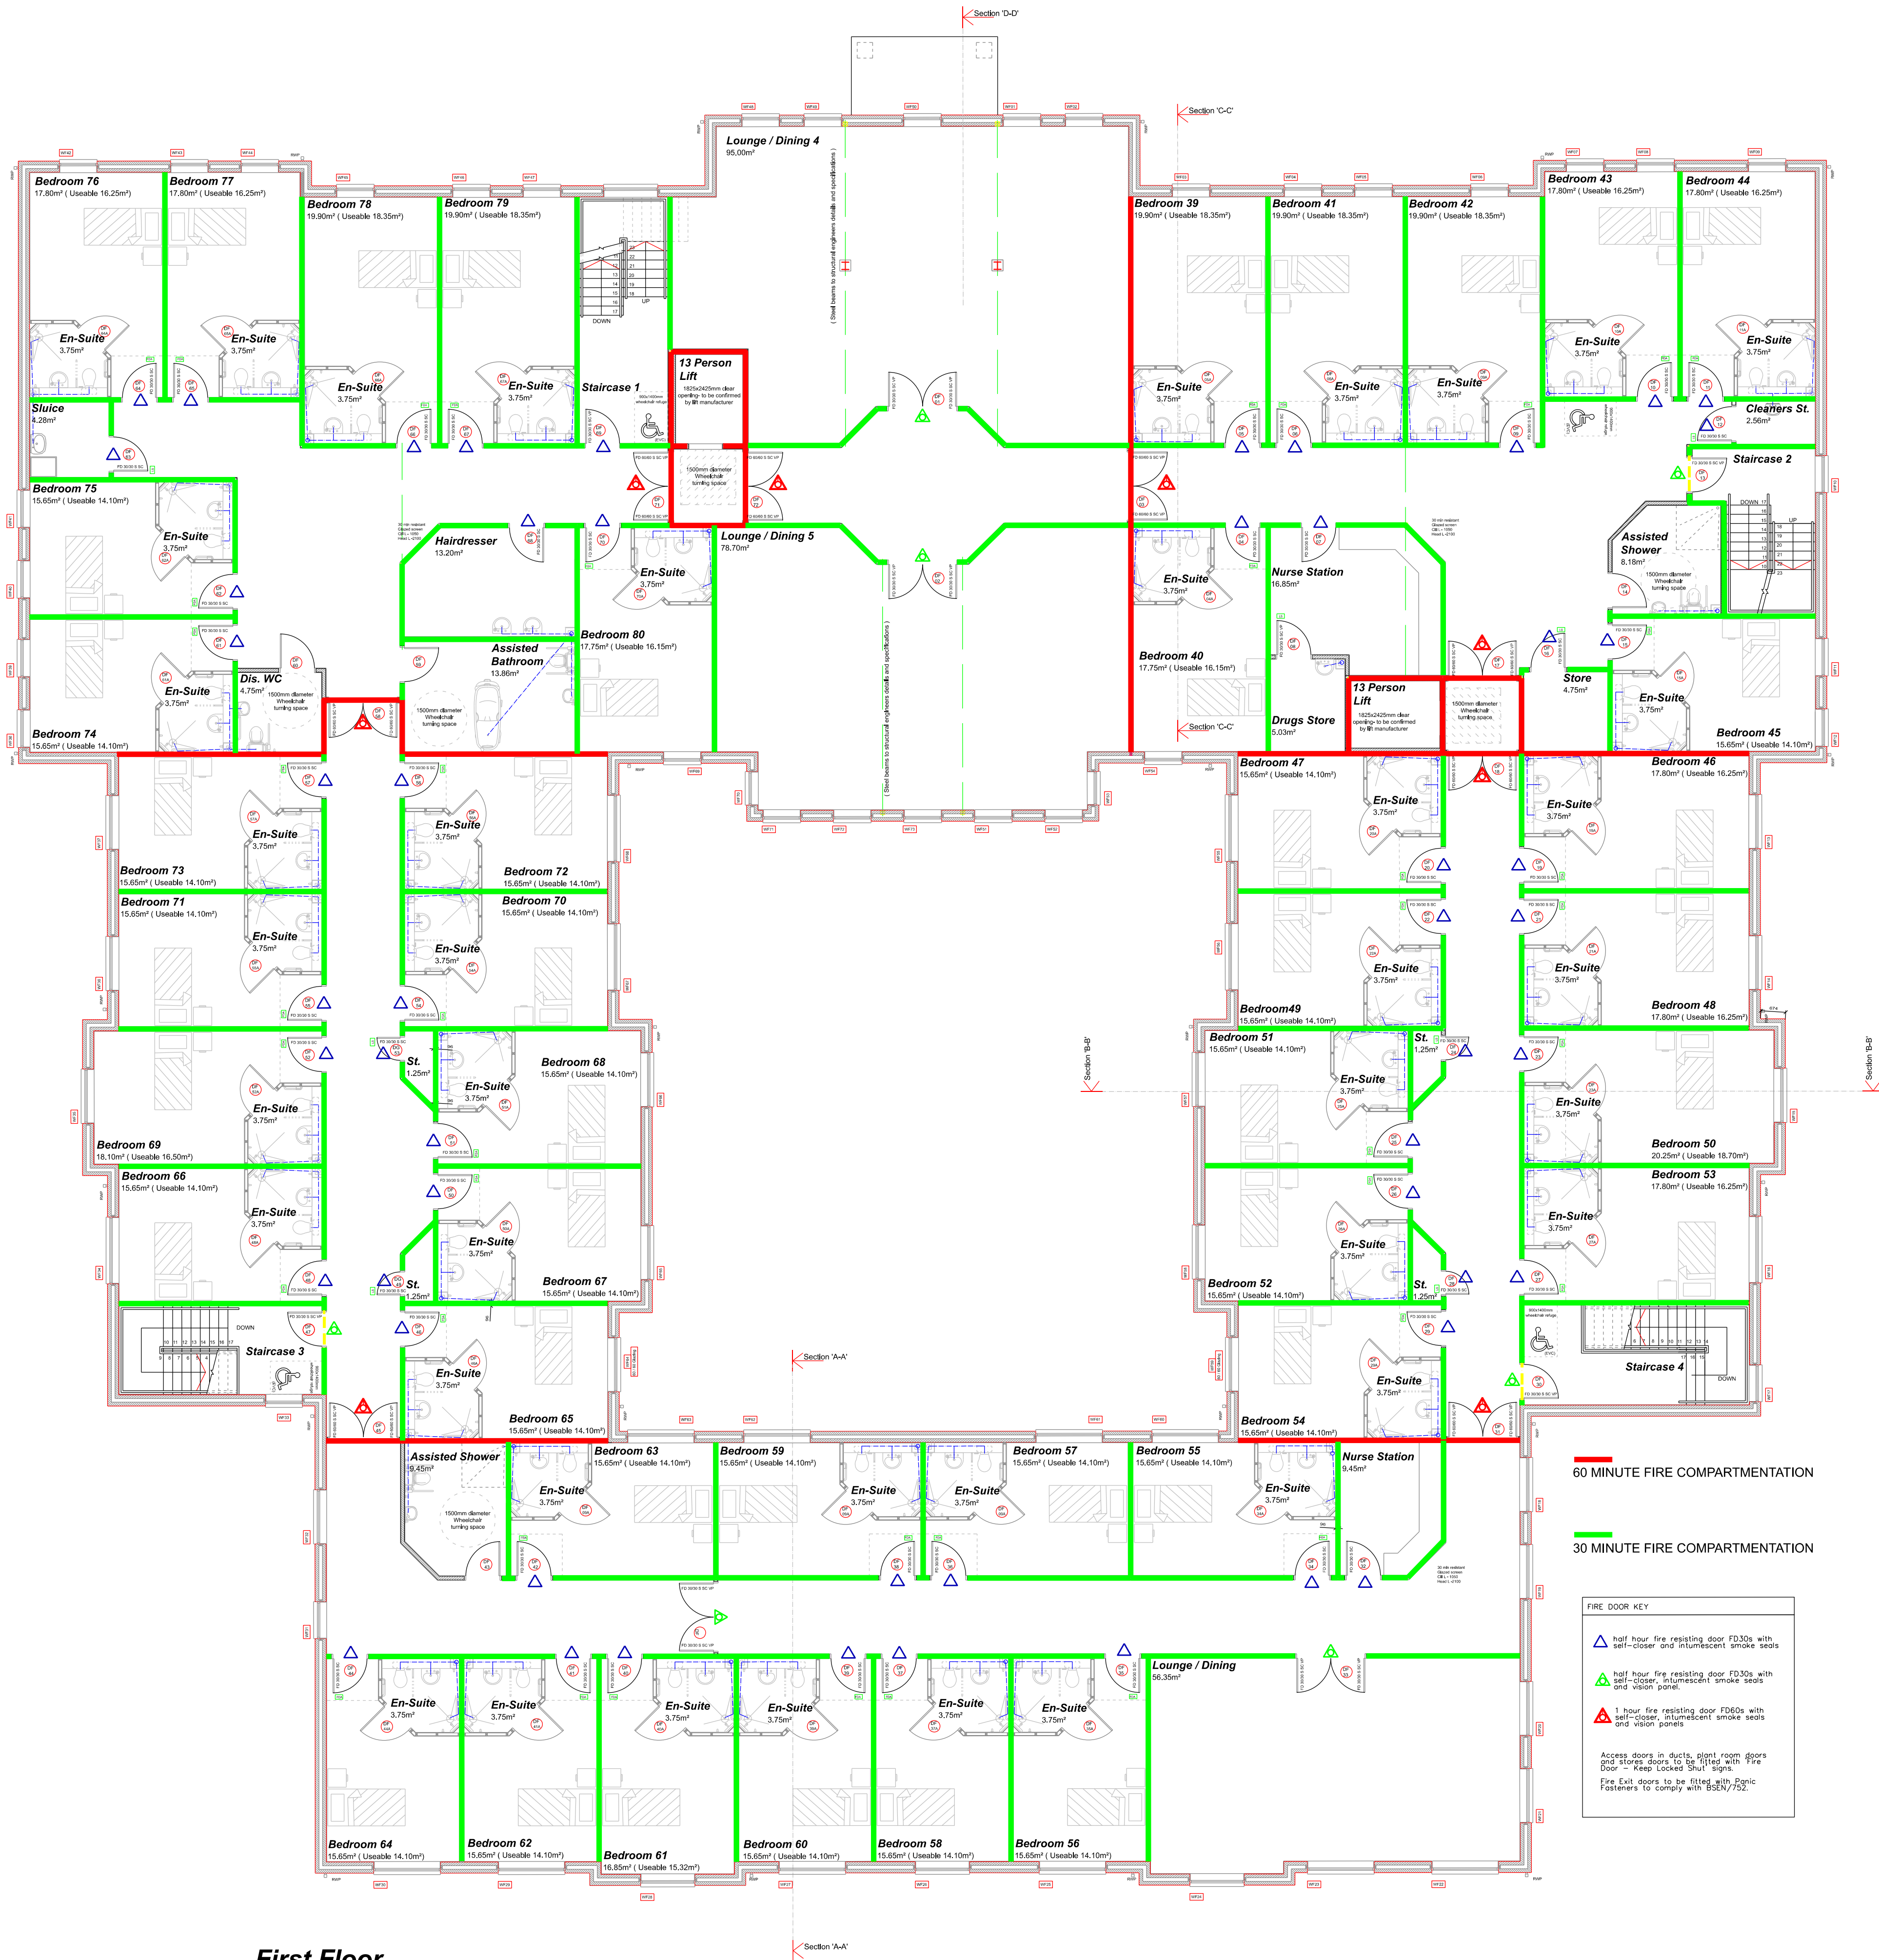

First Floor

AS BUILT FIRST FLOOR FIRE STRATEGY PLAN

REVISION	NORTH

STAGE: AS BUILT

PROJECT
WALBERTON PLACE CARE HOME
YAPTON LANE
WALBERTON
ARUNDEL
WEST SUSSEX
BN15 0AS

DRAWING
FIRST FLOOR FIRE
STRATEGY PLAN

PROJECT NO. 3112	DRAWING NO. L-08	REVISION
DATE APR '19	SCALES 1:100@A1	DRAWN BY

MARIO MINCHELLA ARCHITECTS

UNIT 4, WITNEY WAY, HI-TECH VILLAGE, BOLDON BUSINESS PARK TYNE AND WEAR NE35 9PE T: 0191 3802227 W: www.mma.net E: info@mma.net	
--	--

THIS DRAWING IS COPYRIGHT OF DMM LIMITED	NOT TO BE SCALED ALL DIMENSIONS TO BE CHECKED ON SITE
--	---