


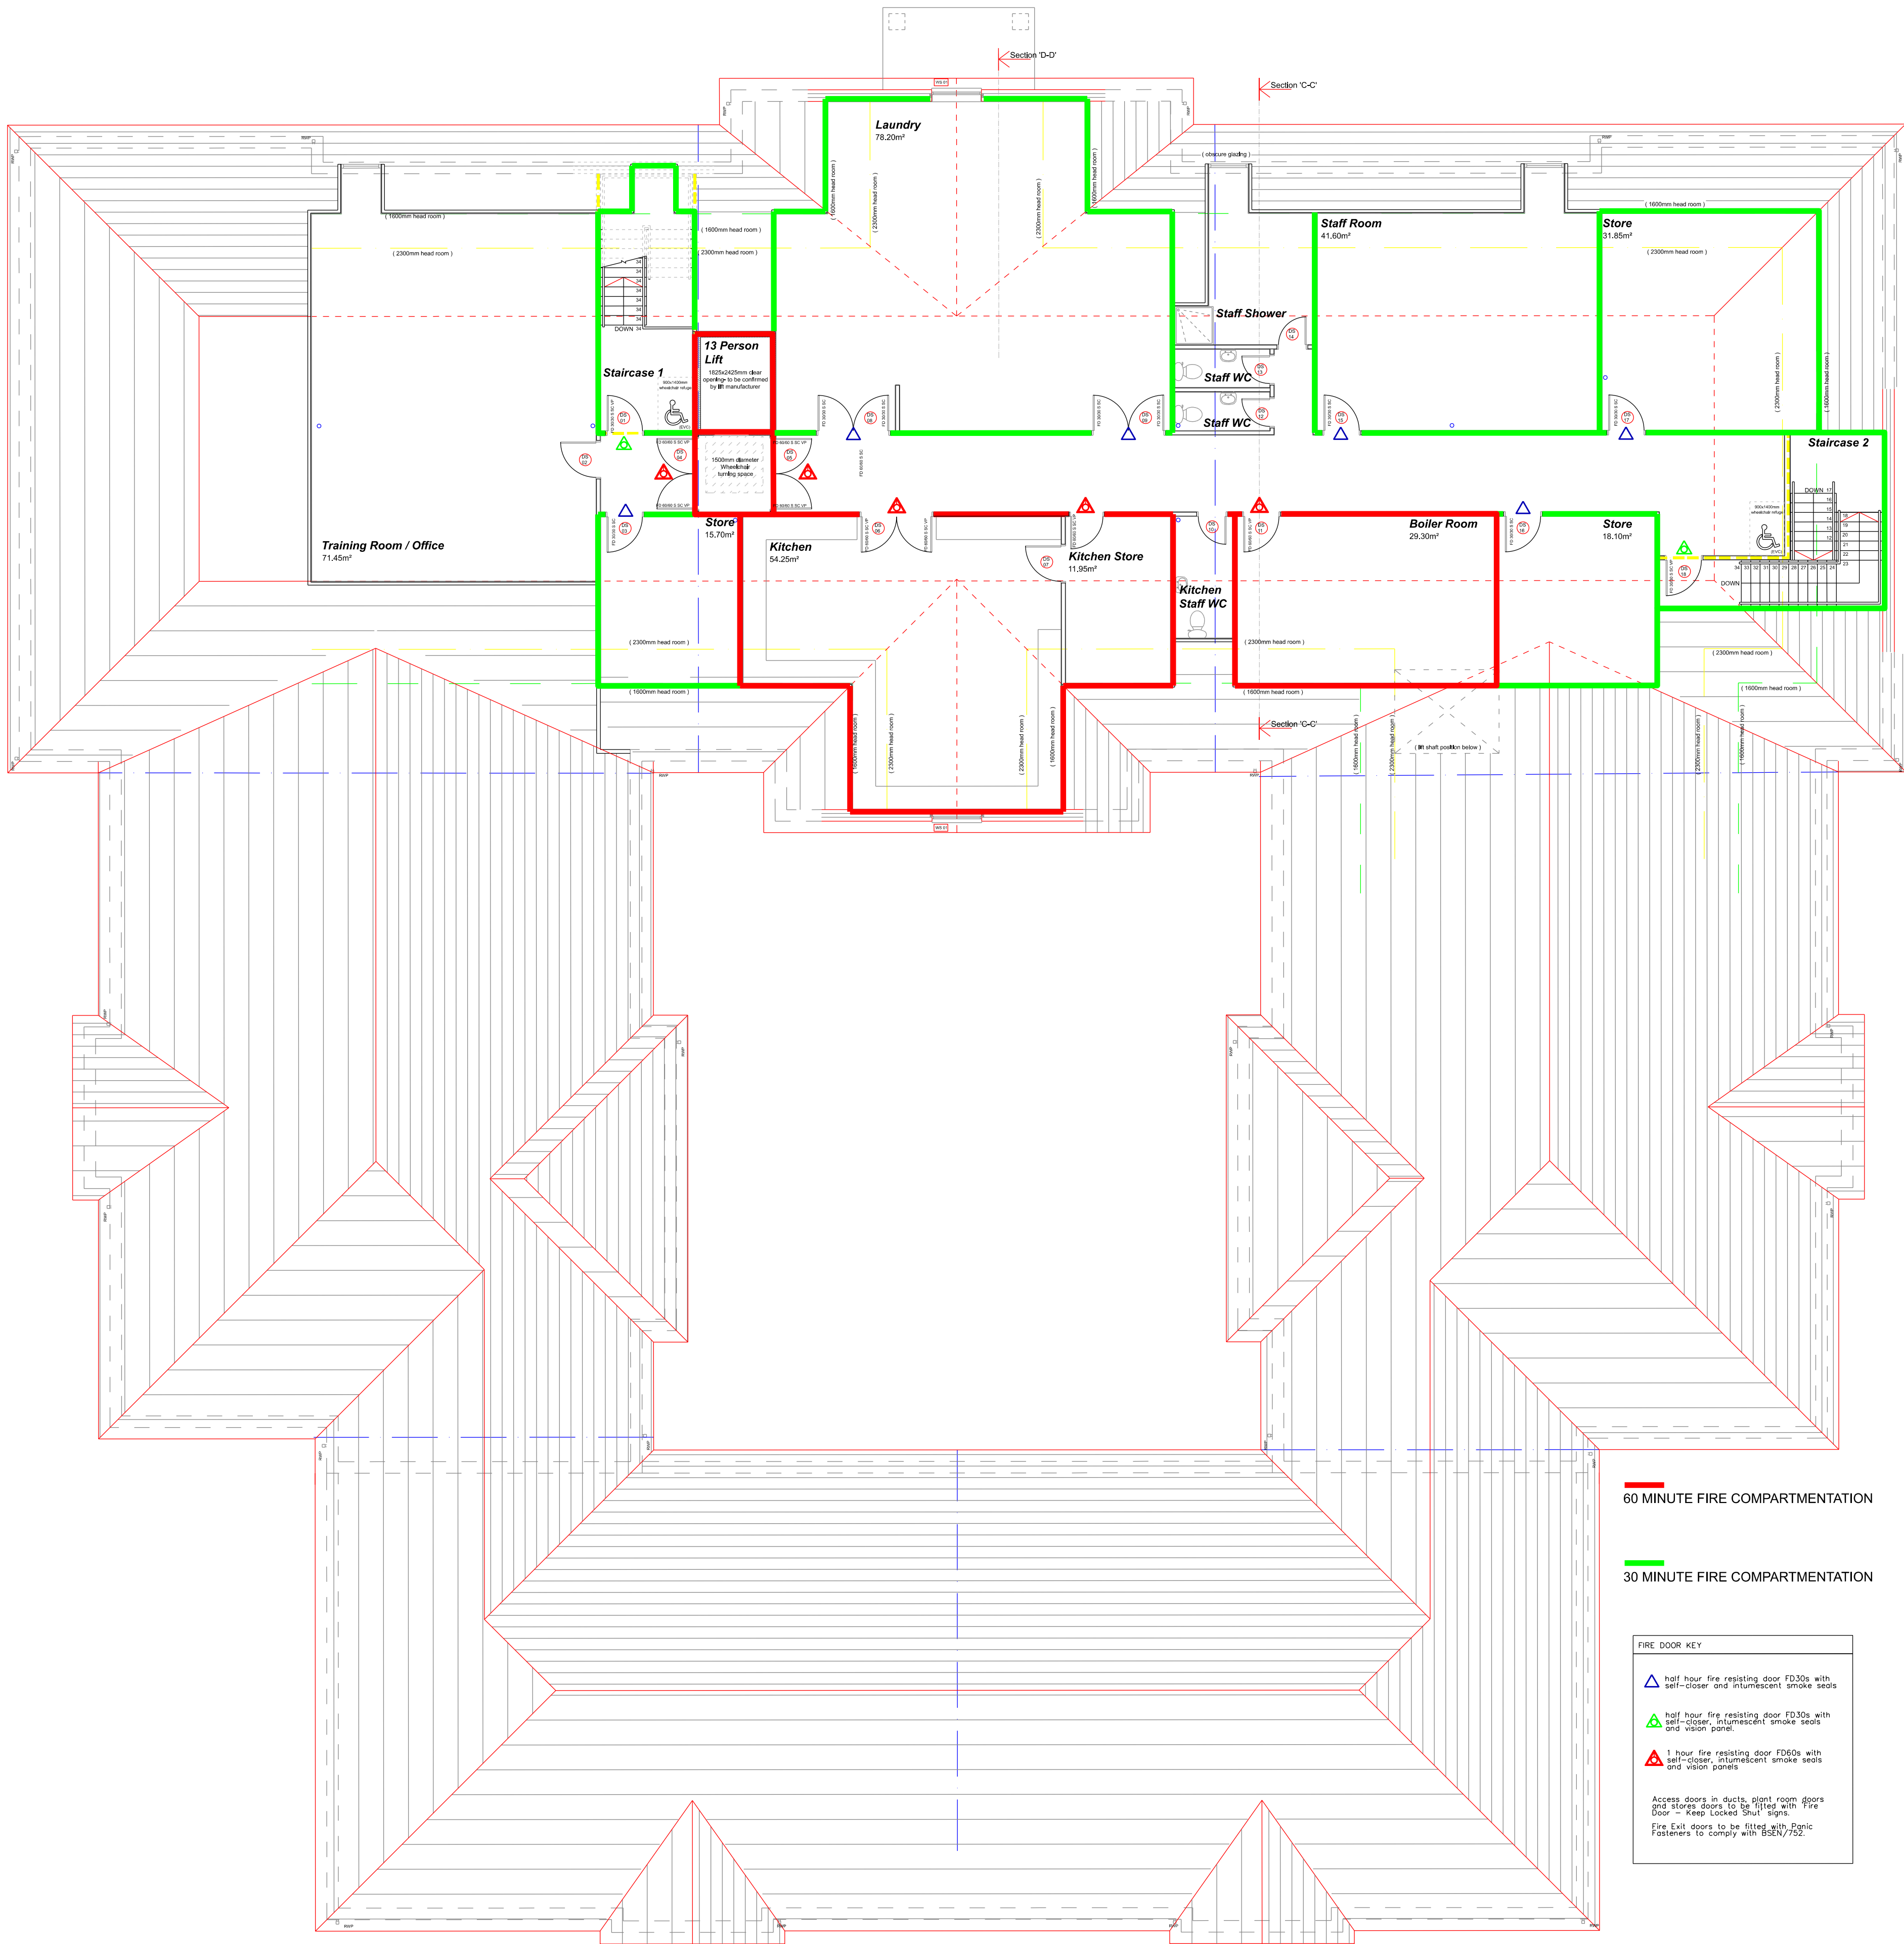

Second Floor

AS BUILT SECOND FLOOR FIRE STRATEGY PLAN

REVISION	NORTH

STAGE: AS BUILT

PROJECT
WALBERTON PLACE CARE HOME
YAPTON LANE
WALBERTON
ARUNDEL
WEST SUSSEX
BN15 0AS

DRAWING
SECOND FLOOR FIRE
STRATEGY PLAN

PROJECT NO.	DRAWING NO.	REVISION
3112	L-09	
DATE	SCALES	DRAWN BY
APR '19	1:100@A1	

MARIO MINCHELLA ARCHITECTS

UNIT 4, WITNEY WAY, HI-TECH VILLAGE, BOLDON BUSINESS PARK TYNE AND WEAR NE35 9PE T: 0191 3802227 E: info@m-m-a.net W: www.m-m-a.net	
--	--

THIS DRAWING IS COPYRIGHT OF DAJAM LIMITED	NOT TO BE SCALED ALL DIMENSIONS TO BE CHECKED ON SITE
--	---