

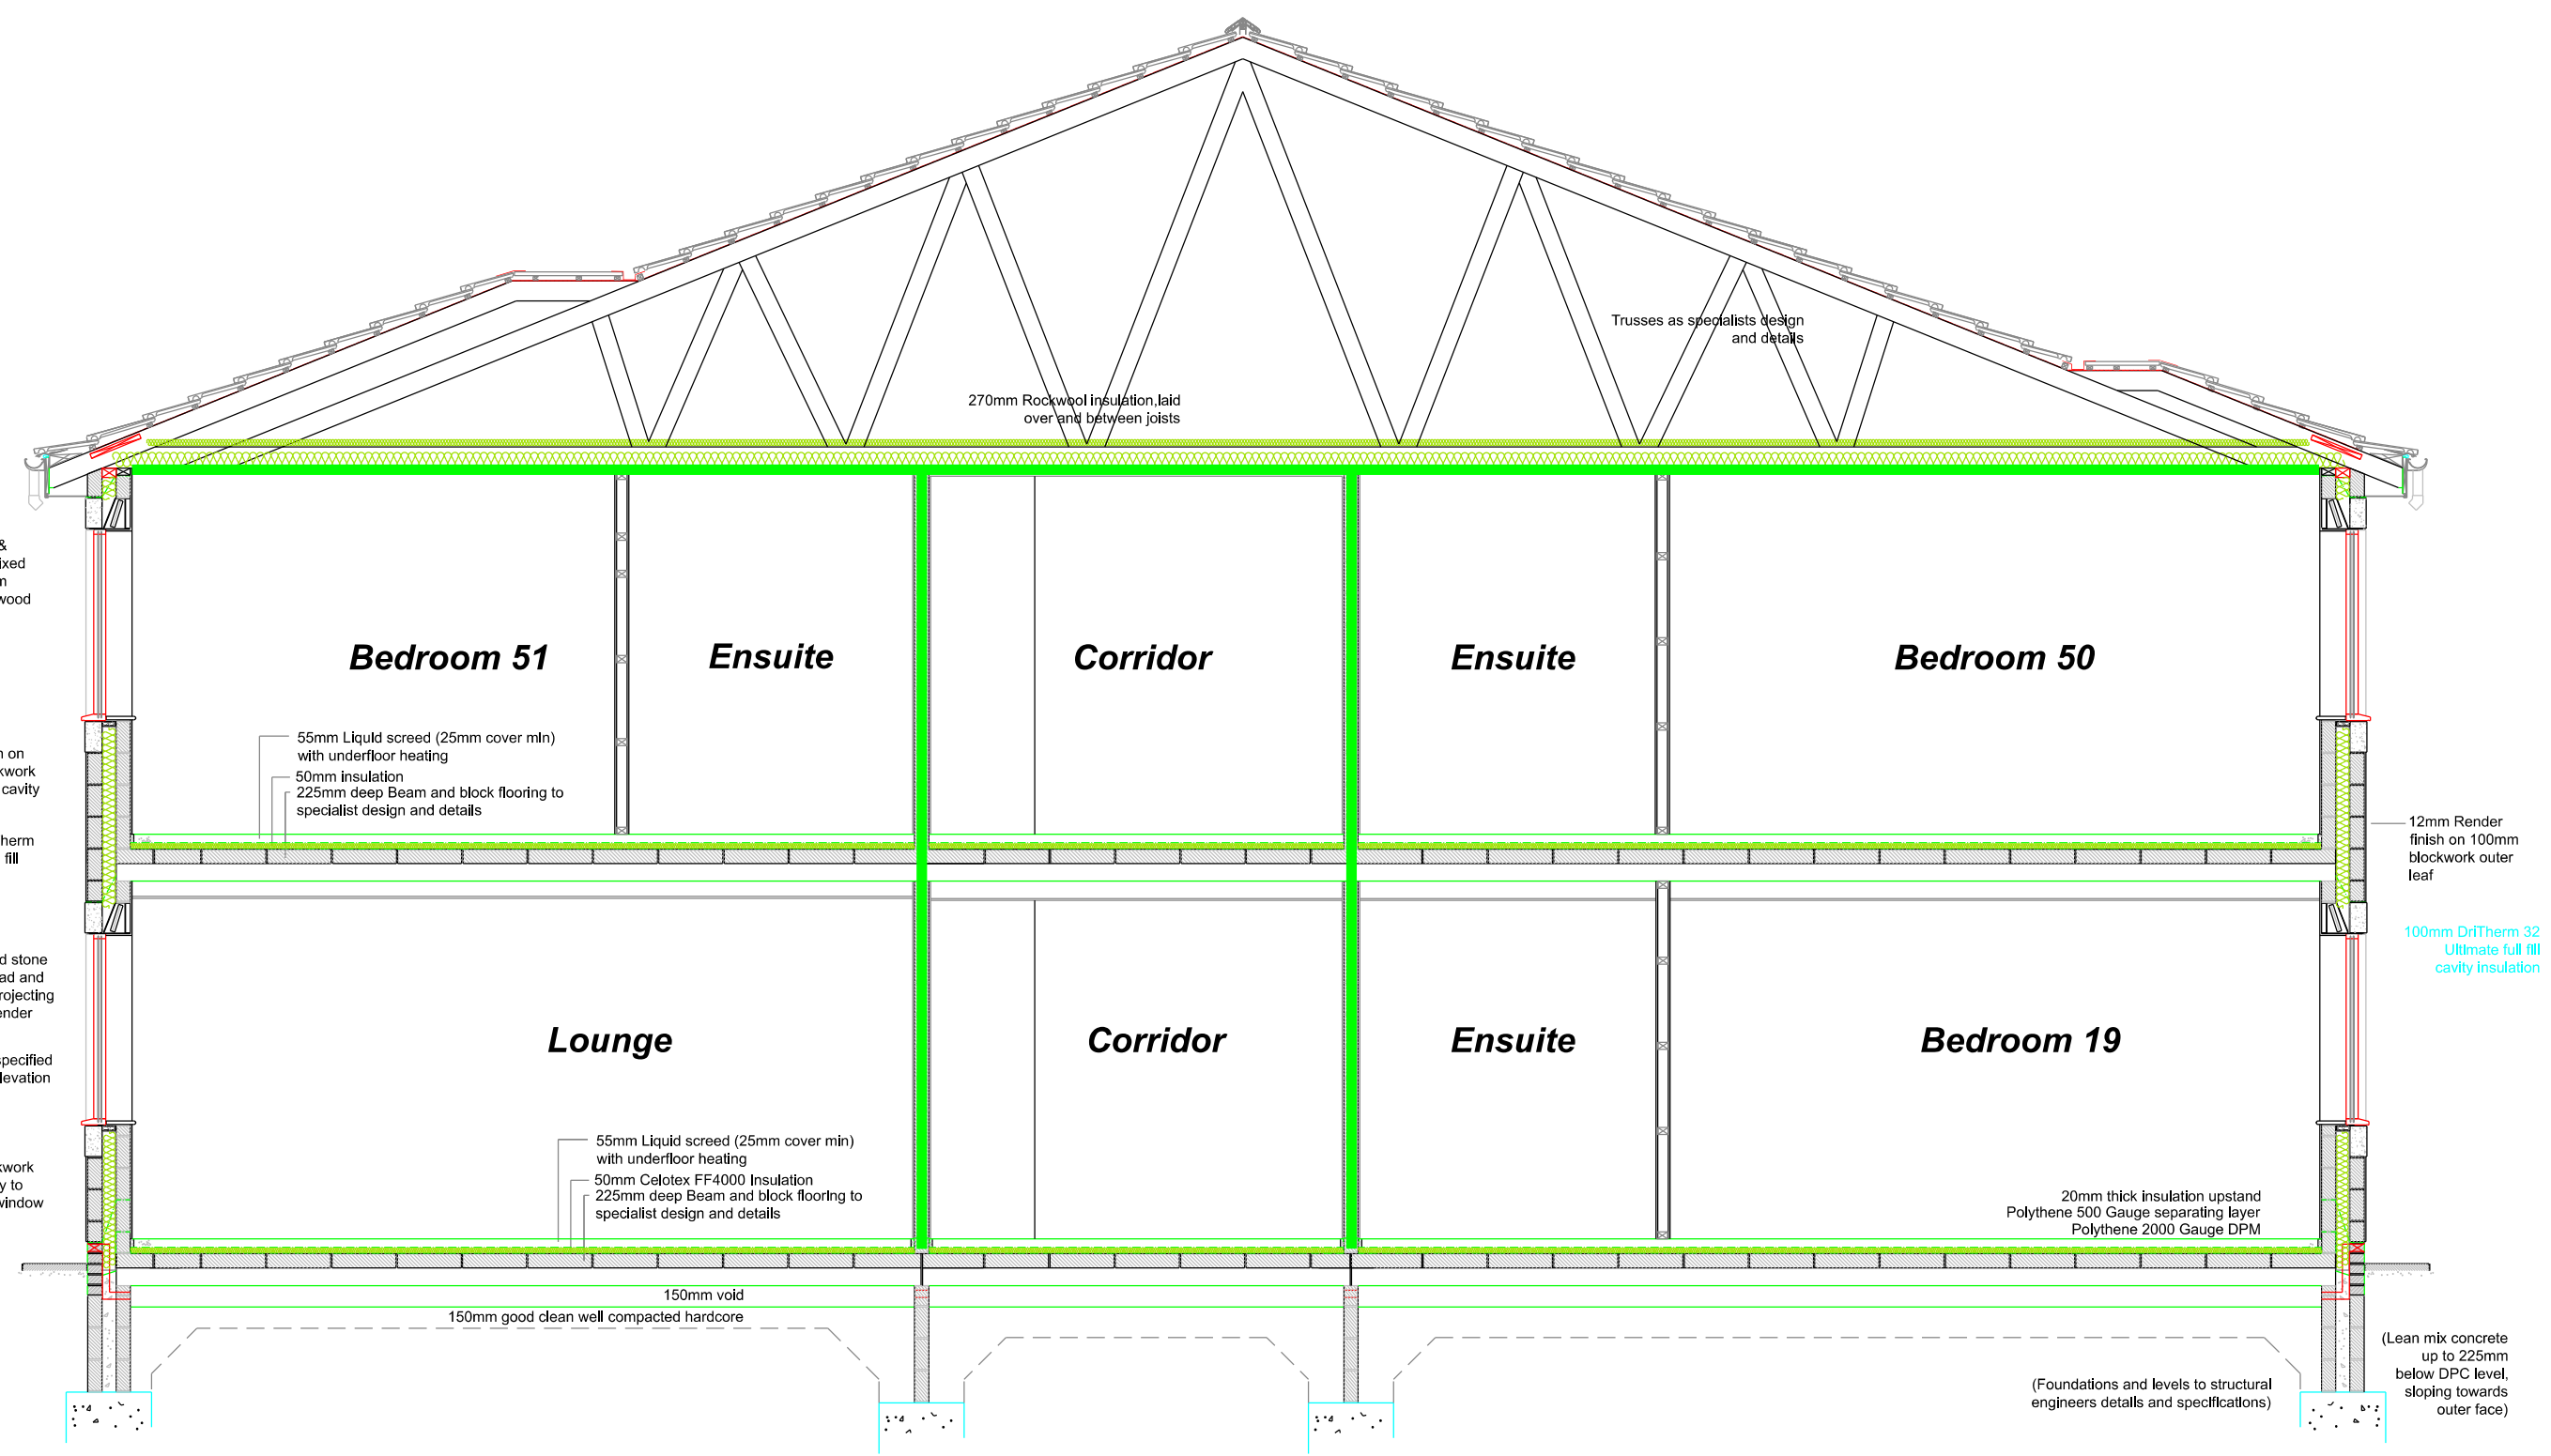


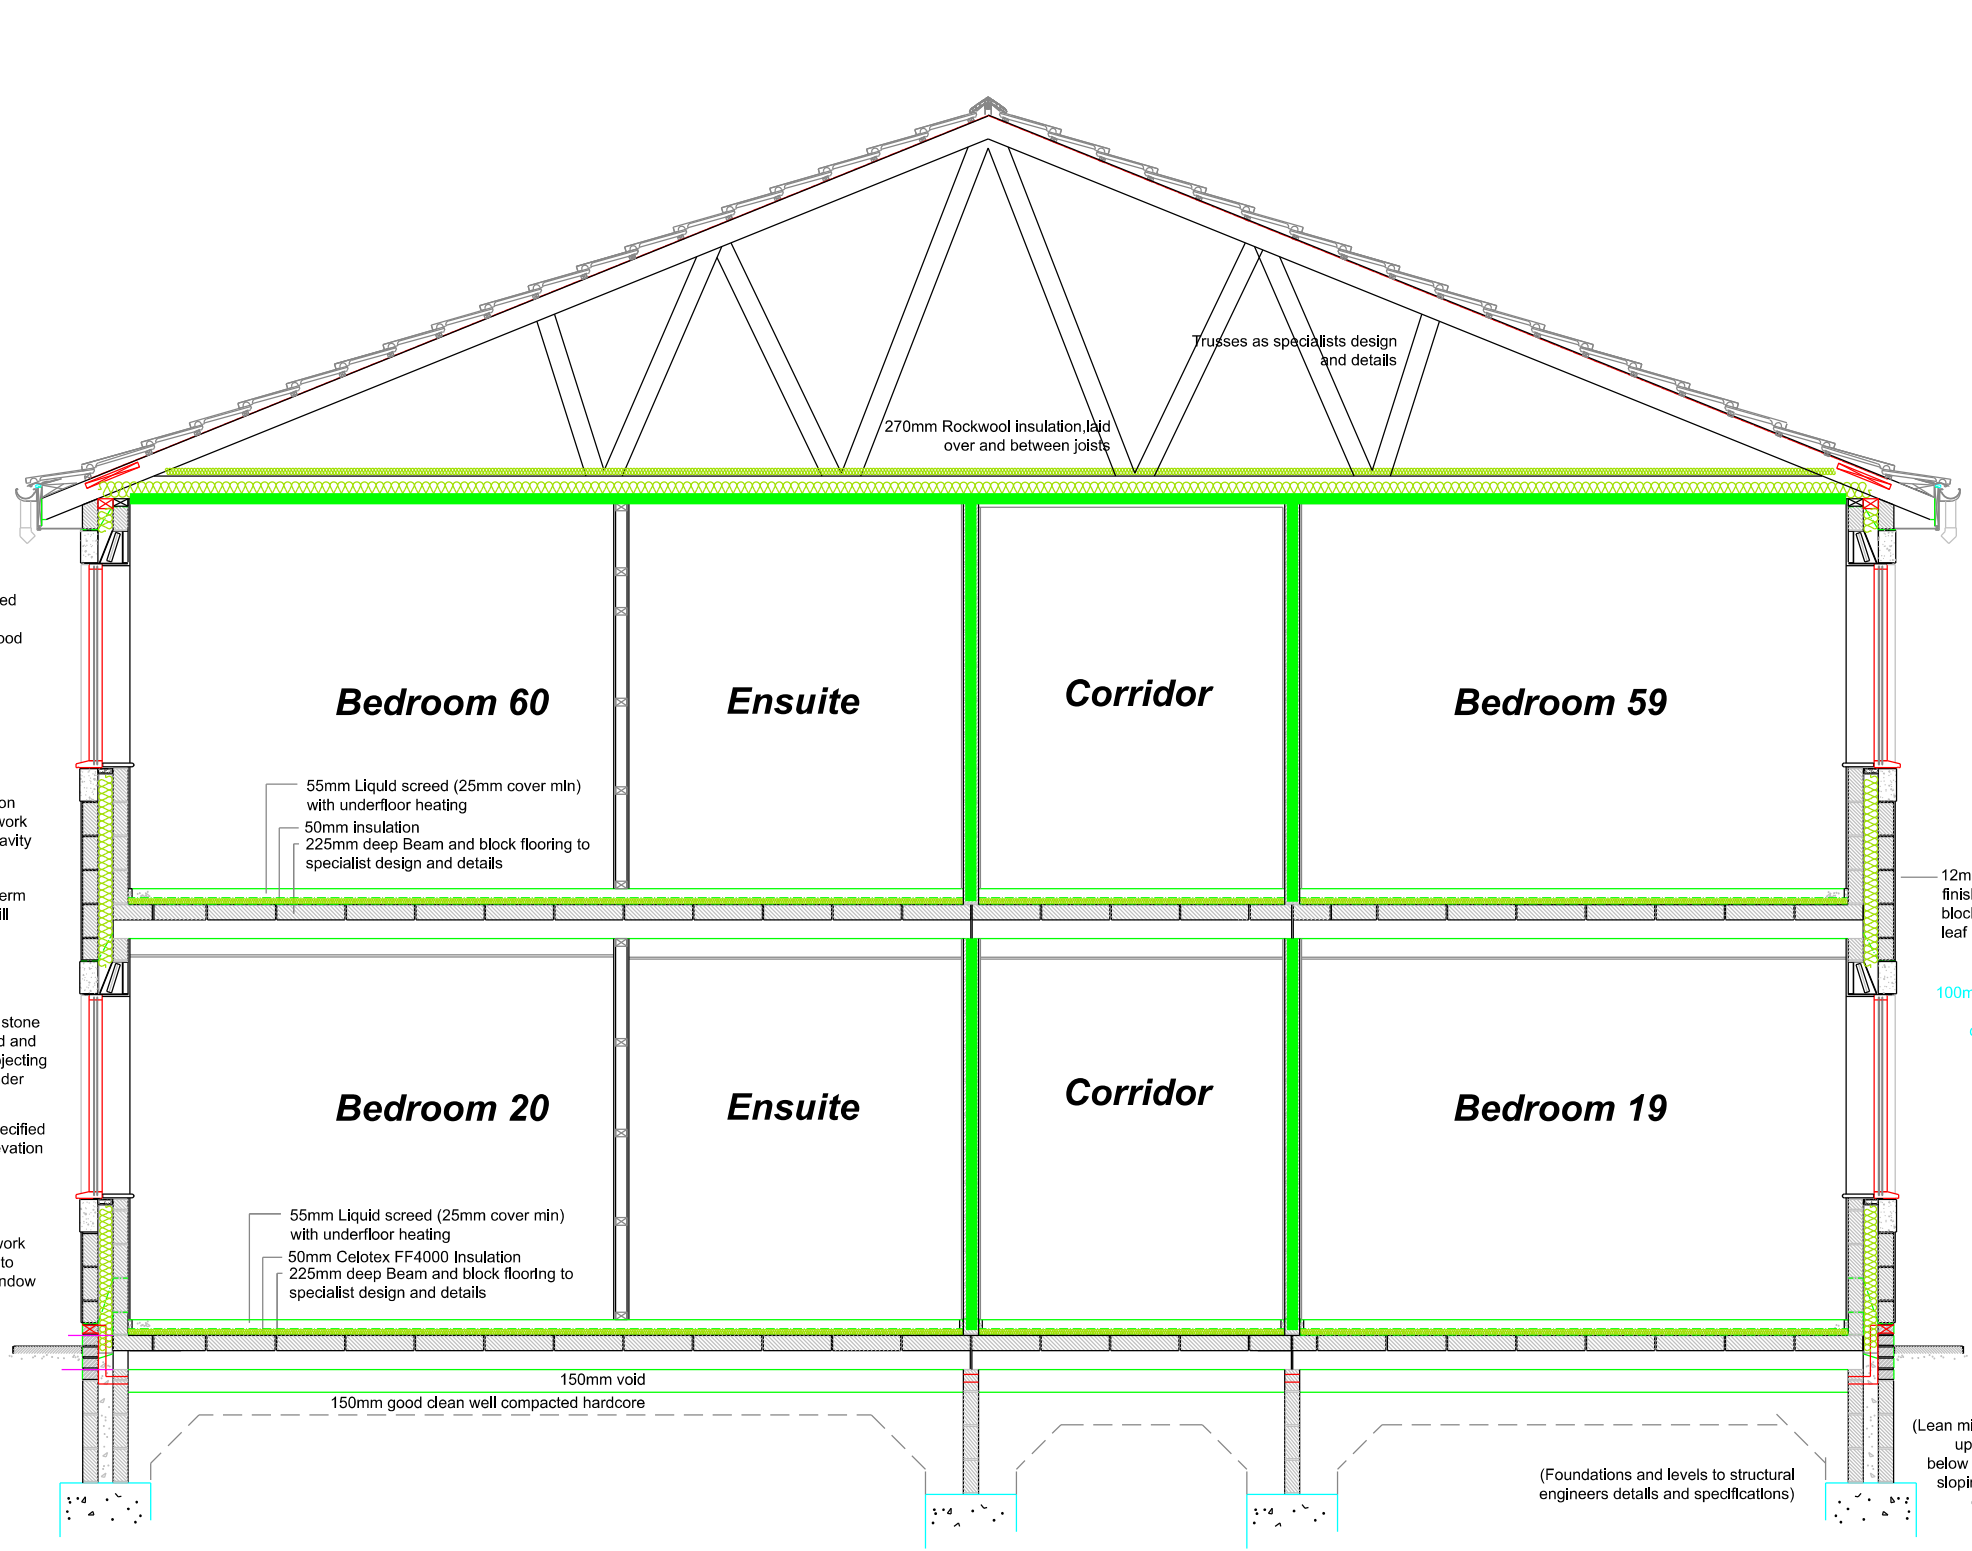


Section 'B-B'

Section 'A-A'

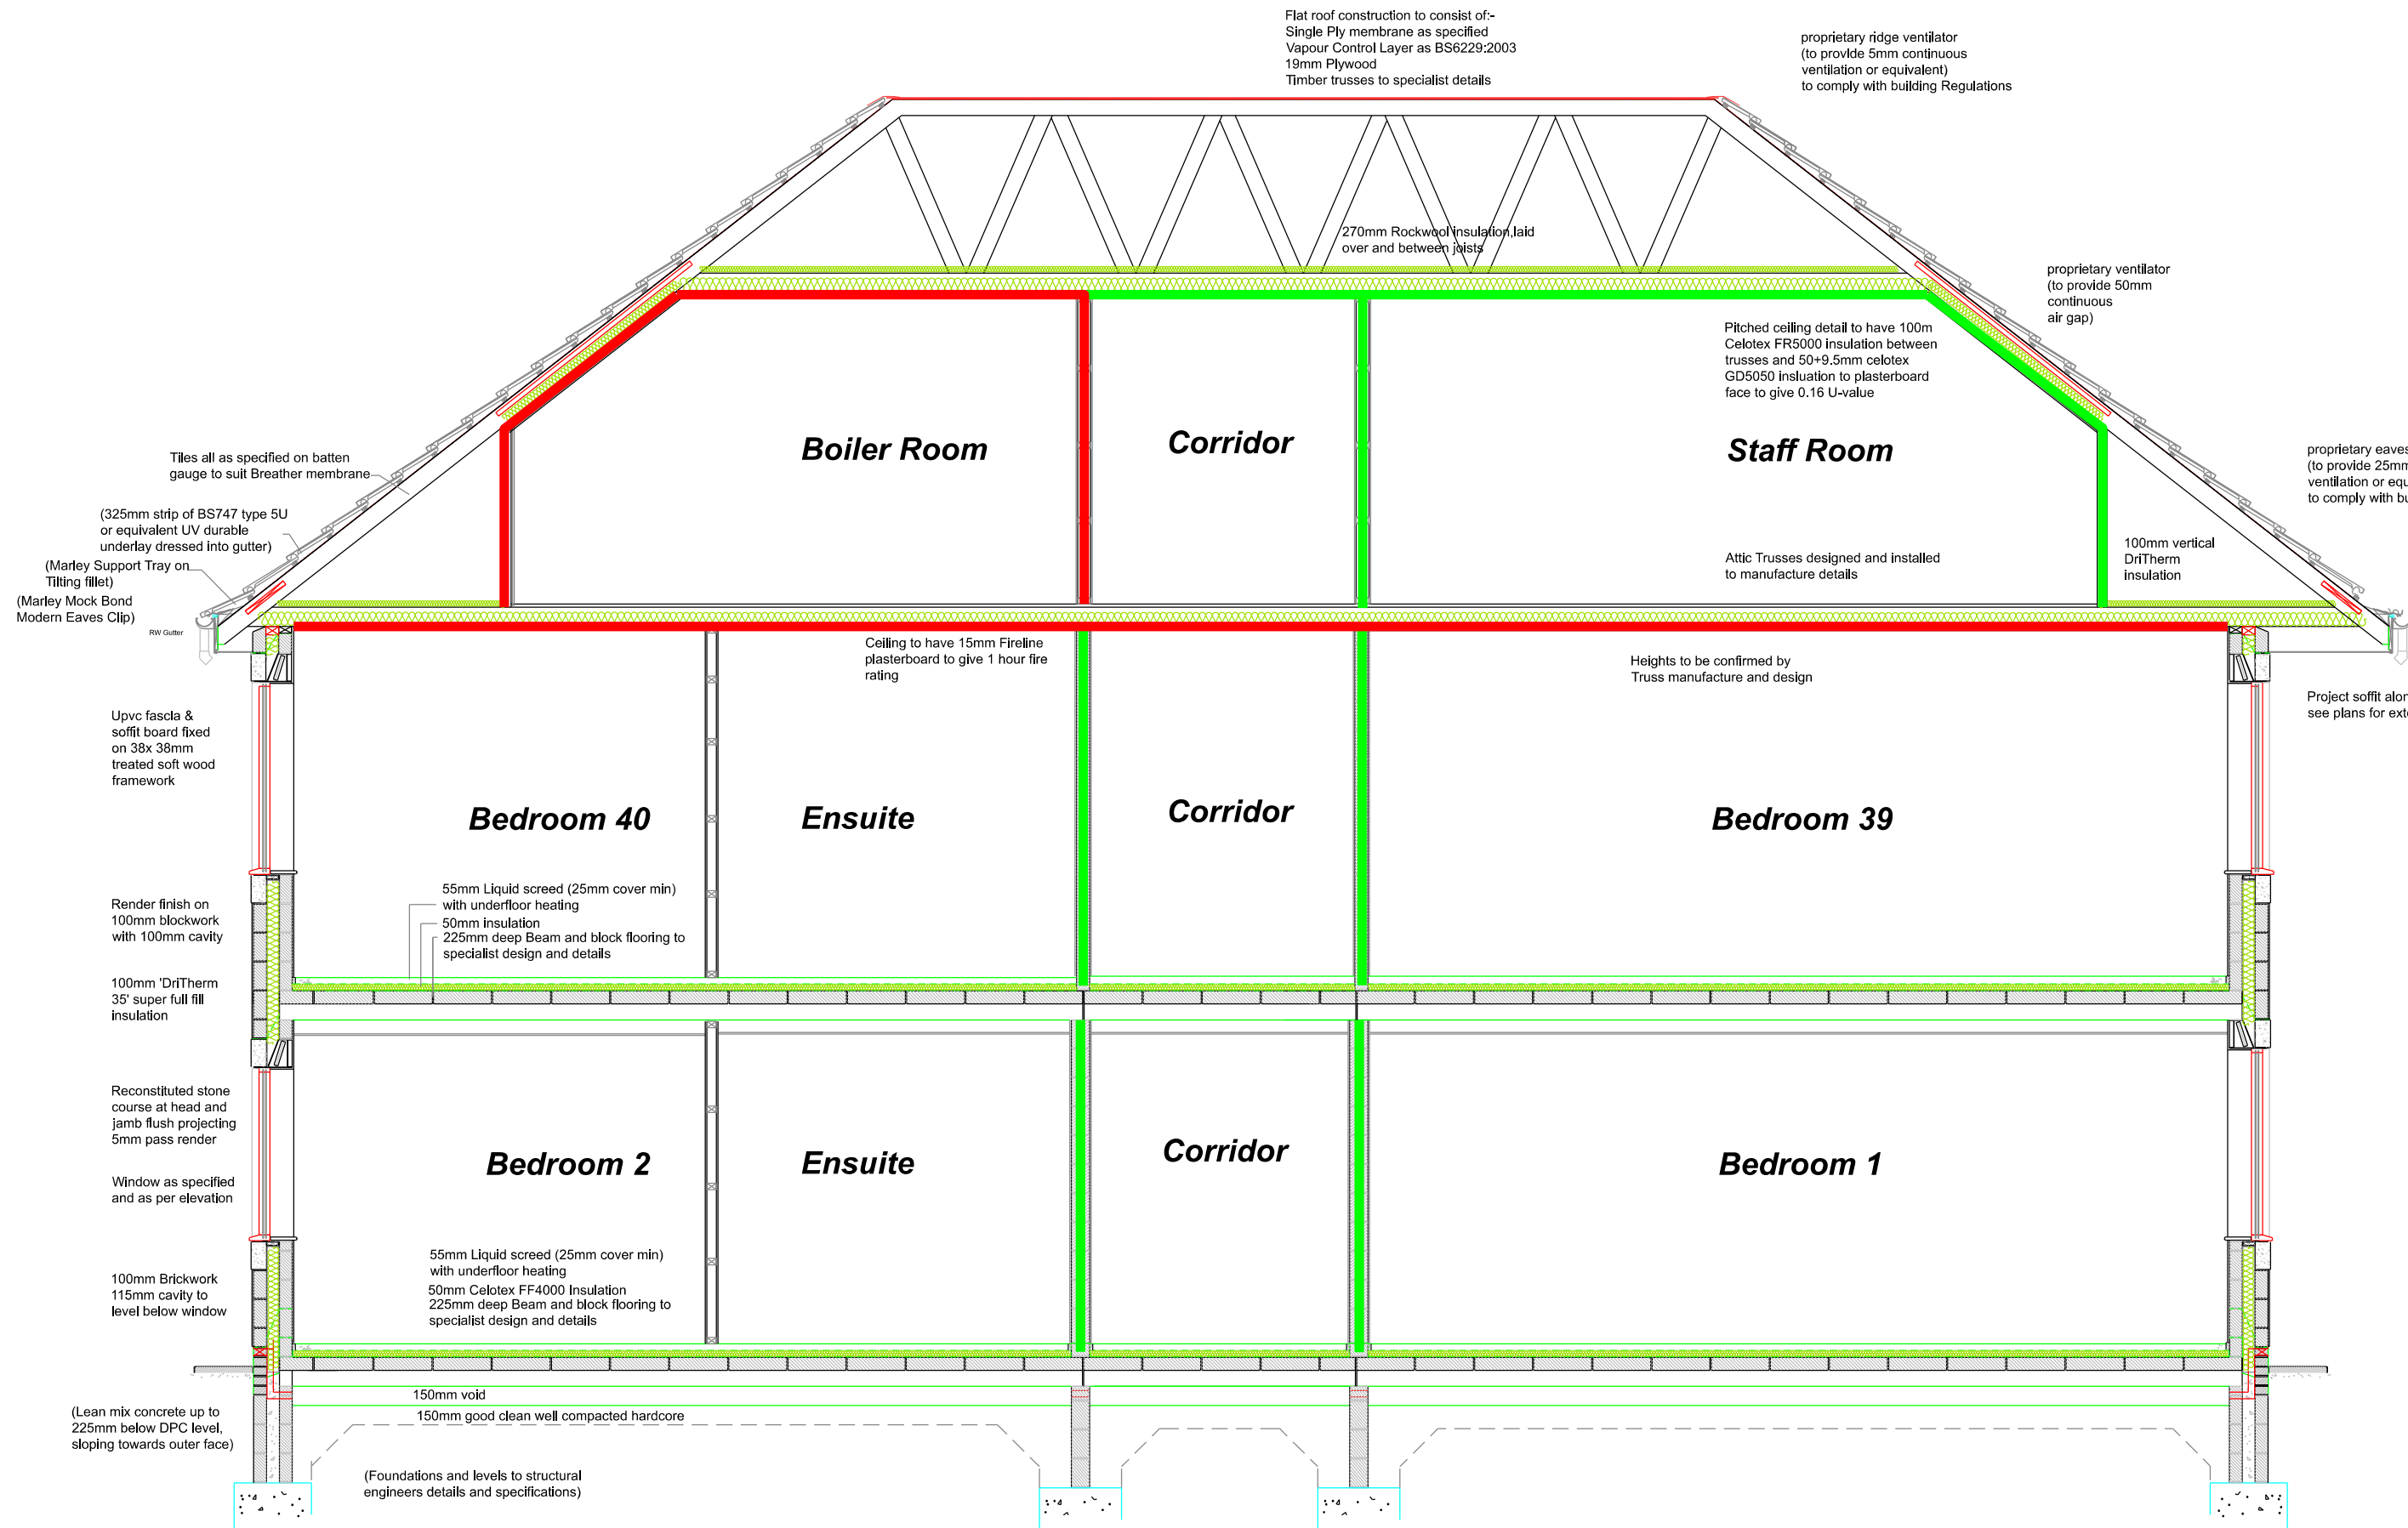

Section 'C-C'

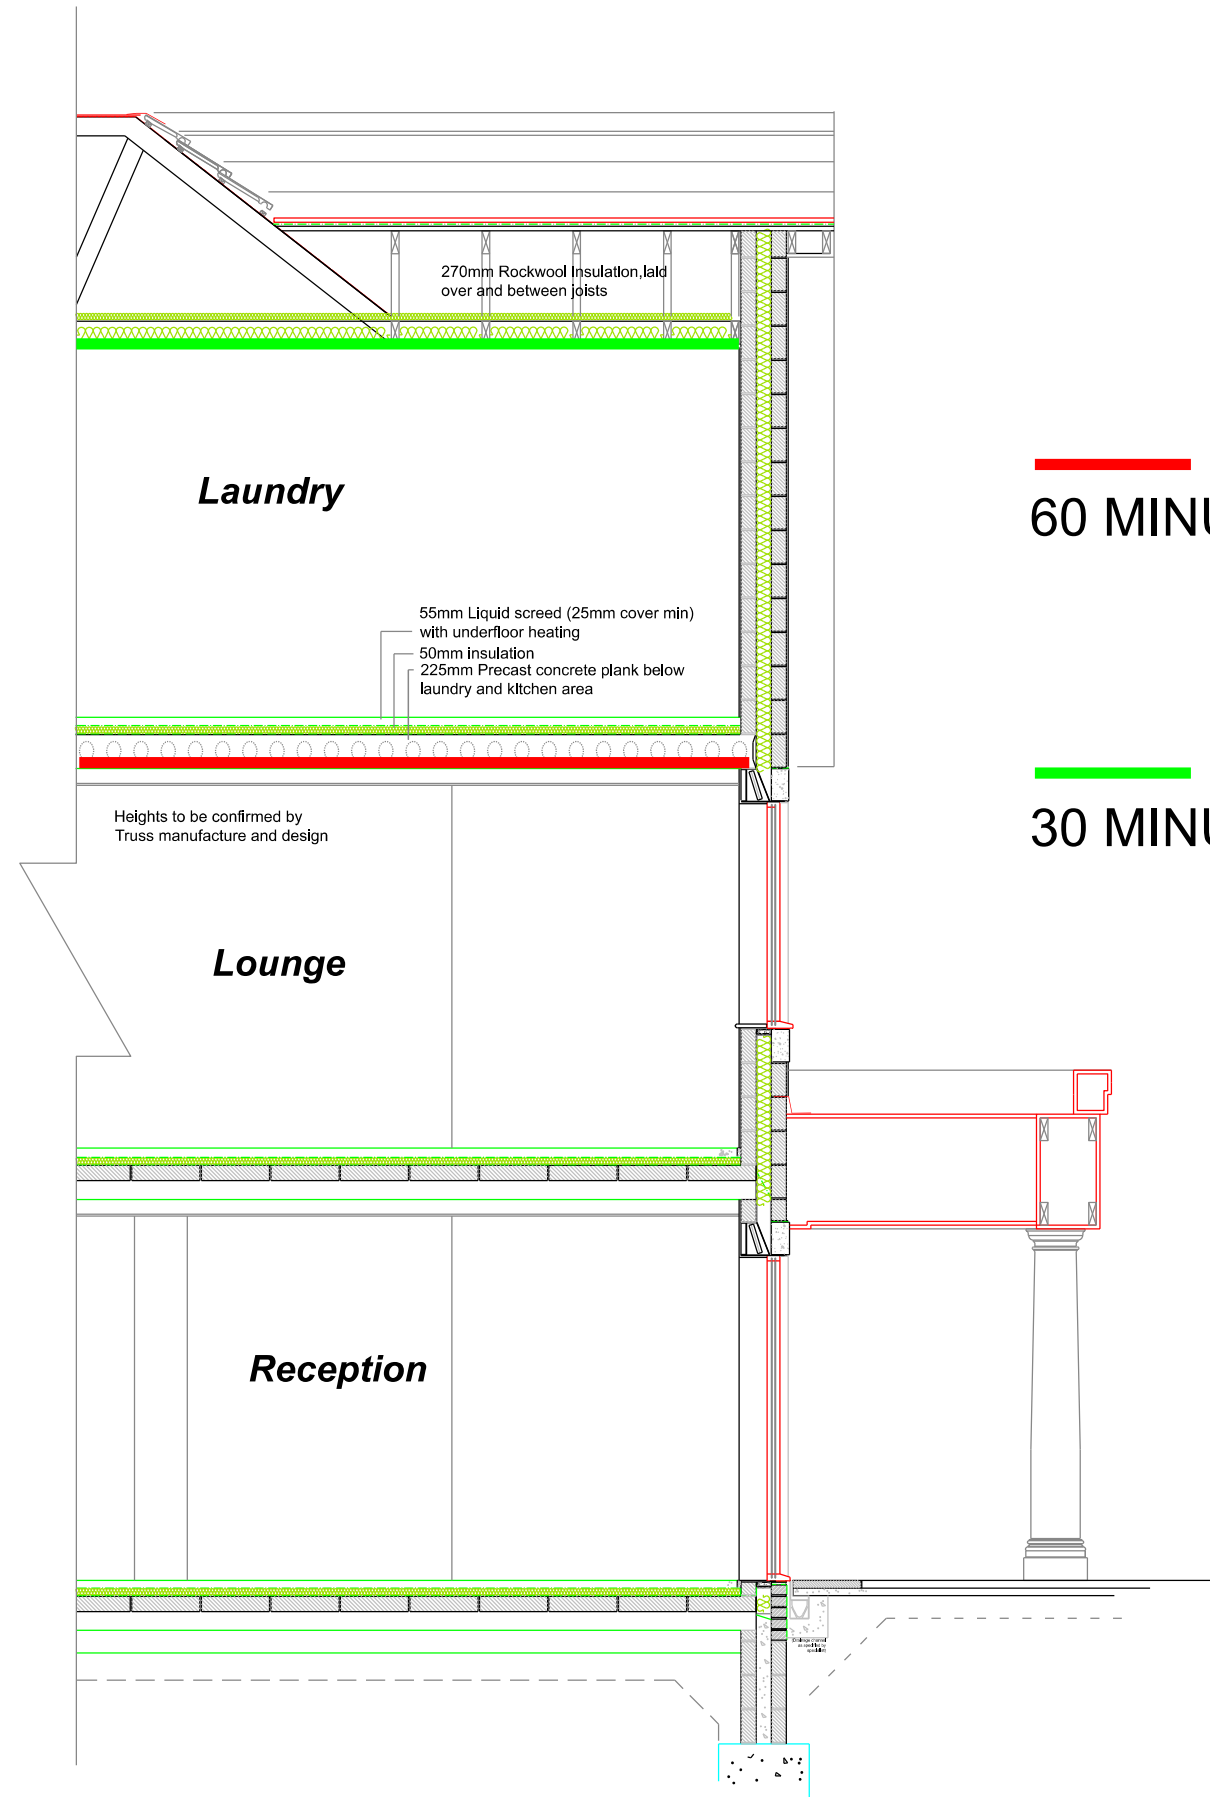

Section 'D-D'

60 MINUTE FIRE COMPARTMENTATION

30 MINUTE FIRE COMPARTMENTATION

REVISION DATE / DESCRIPTION

REVISION	NORTH
----------	-------

STAGE: AS BUILT

PROJECT
WALBERTON PLACE CARE HOME
YABTON LANE
WALBERTON
ARUNDEL
WEST SUSSEX
BN18 0AS

DRAWING
SECTION FIRE STRATEGY

PROJECT NO. 3112	DRAWING NO. L-10	REVISION
DATE APR 19	SCALES 1:50&A1	DRAWN BY BAS

MARIO MINCHELLA ARCHITECTS

UNIT 4, WITNEY WAY,
HI-TECH VILLAGE,
BOLDON BUSINESS PARK
TINE AND WEAR
NE35 9PE
T: 0191 3802227
W: www.mma.net
E: info@mma.net

THIS DRAWING IS
COPYRIGHT OF
DANAM LIMITED

NOT TO BE SCALED
ALL DIMENSIONS TO
BE CHECKED ON SITE