

A1

- ## RESIDUAL HAZARDS

1. Buried services. Contractor to refer to record drawings and use CAT to locate existing services and undertake necessary precautions and investigation prior to excavating.
2. Working in live traffic. Contractor to ensure traffic management is designed, erected and maintained to protect the workforce and the public. Contractor to undertake necessary precautions and ensure suitable traffic management is in place prior to commencement.
3. Working in live sewers. Contractor to ensure operatives are familiar and competent with the dangers of working in live sewers.
4. Excavations close to existing structures. Contractor to prepare method statement to ensure stability of existing structure.
5. Working in vicinity of Waterbodies with variable surface water flows & debris. Contractor to provide method statement and ensure operatives have appropriate safeguarding equipment.

G	Updated with As-Built Details	18/06/2021
F	Revised Issue	07/07/2020
E	Revised Issue	17/06/2020
D	Revised Issue	21/05/2020
C	Revised Issue	06/05/2020
B	Revised Issue	09/04/2020
A	Revised Issue	13/03/2020
-	Original Issue	03/03/2020

--	--	--	--





Client	Driftstone Developments Ltd
--------	-----------------------------




Drawing Title	Construction Details
---------------	----------------------

Scale As Shown	Date Jun. '21	Drawn By DJL	Checked By MJA
-------------------	------------------	-----------------	-------------------

1-1000 001	0
------------	---

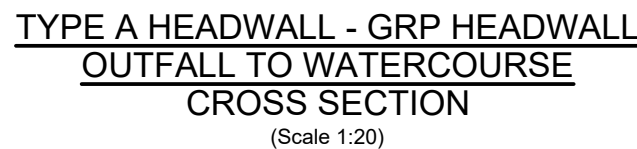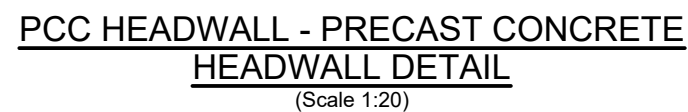

- Designed in accordance with BS:EN 1997-1:2004, BS:EN 1991-1-1:2004
- Concrete Grade C50/60
- Reinforcement Grade B500B
- Reinforcement Cover 60mm
- Exposure Class XF3/4
- Design Life 120 years
- Approx. Mass 1418kg

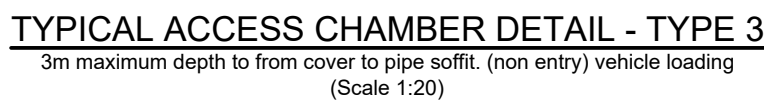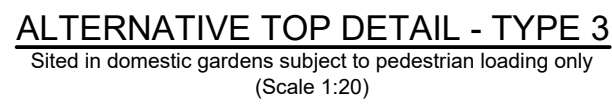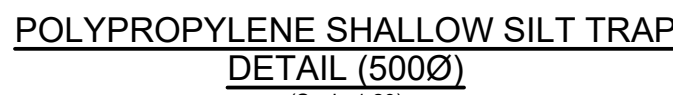

The details shown above are indicative only and should not be used as a scaled drawing. Please refer to manufacturers installation.

