



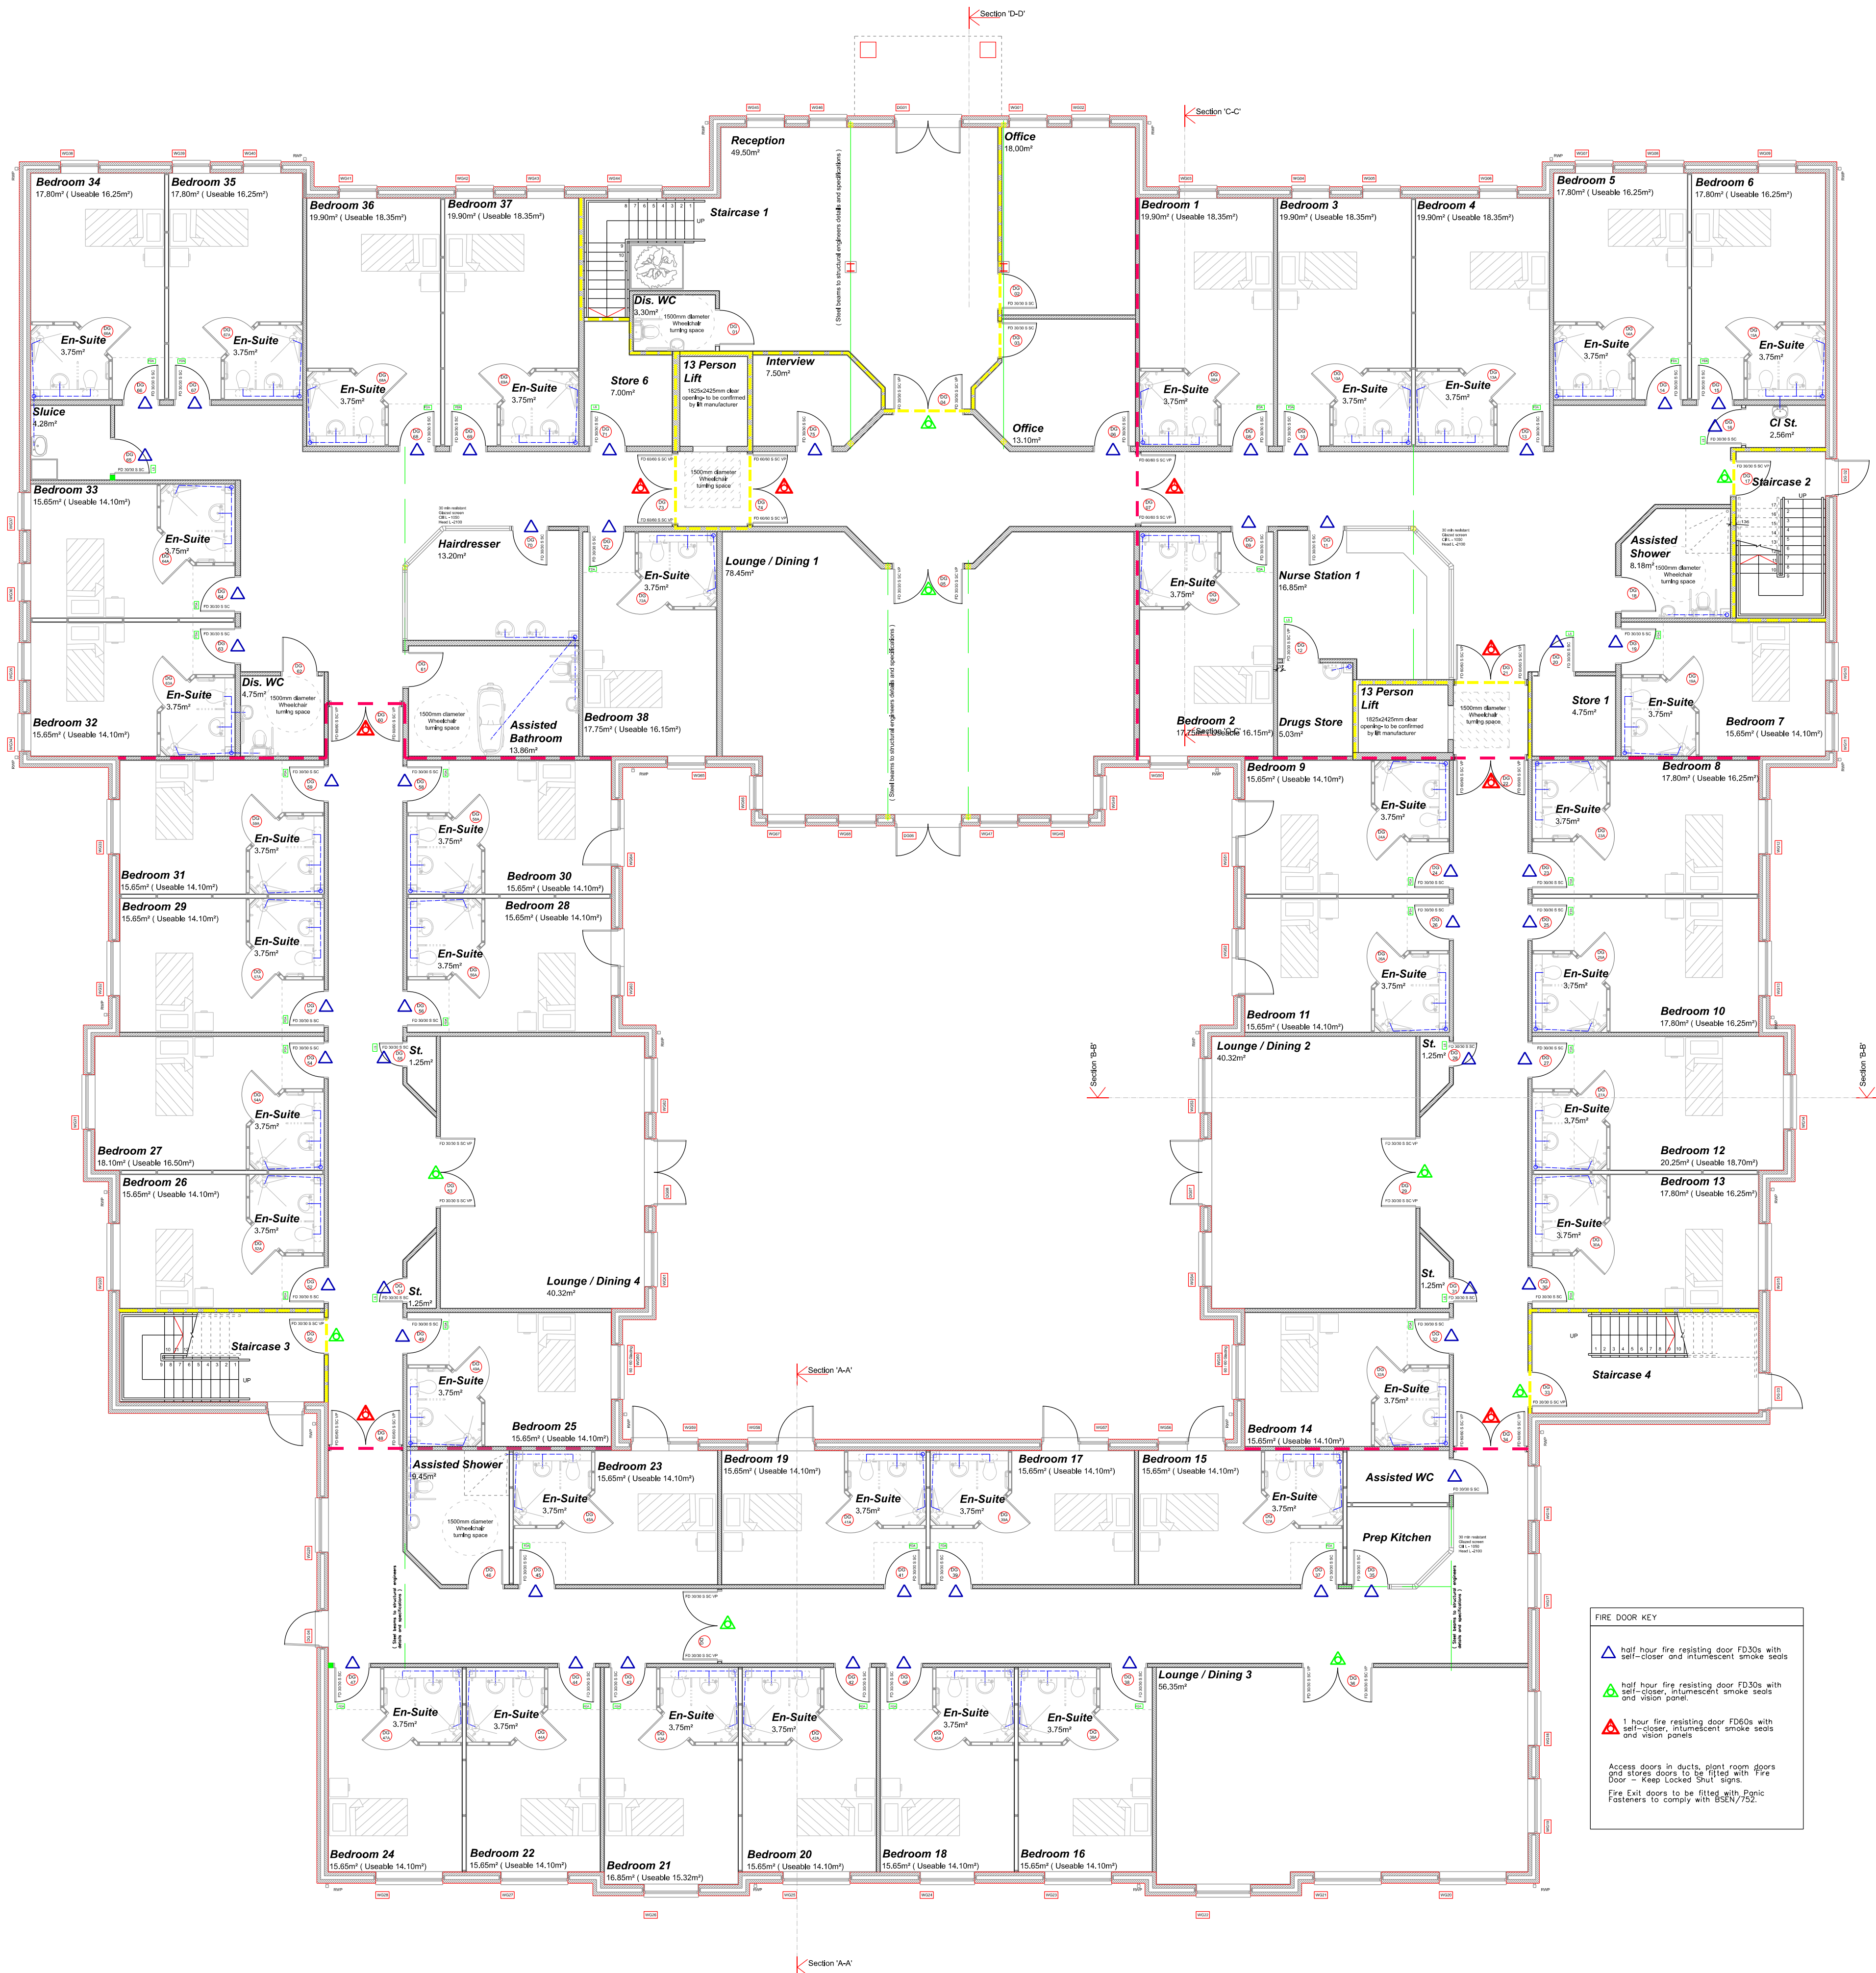

AS BUILT GROUND FLOOR PLAN

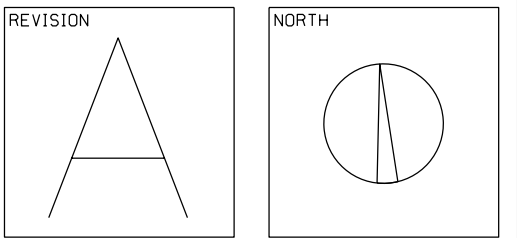

STAGE: AS BUILT

PROJECT
WALBERTON PLACE CARE HOME
YAPTON LANE
WALBERTON
ARUNDEL
WEST SUSSEX
BN15 0AS


DRAWING
GROUND FLOOR PLAN

PROJECT NO. 3112	DRAWING NO. L-01	REVISION A
---------------------	---------------------	---------------

DATE APR '19	SCALES 1:100@A1	DRAWN BY
-----------------	--------------------	----------

MARIO MINCHELLA ARCHITECTS

UNIT 4, WITNEY WAY,
HI-TECH VILLAGE,
BOLDON BUSINESS PARK
TYNNE AND WEAR
NE35 9PE
T: 0191 3802227
W: www.mma.net
E: info@mma.net

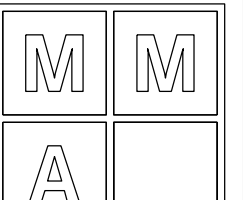

THIS DRAWING IS
COPYRIGHT OF
DAMIAN LIMITED

NOT TO BE SCALED
ALL DIMENSIONS TO
BE CHECKED ON SITE