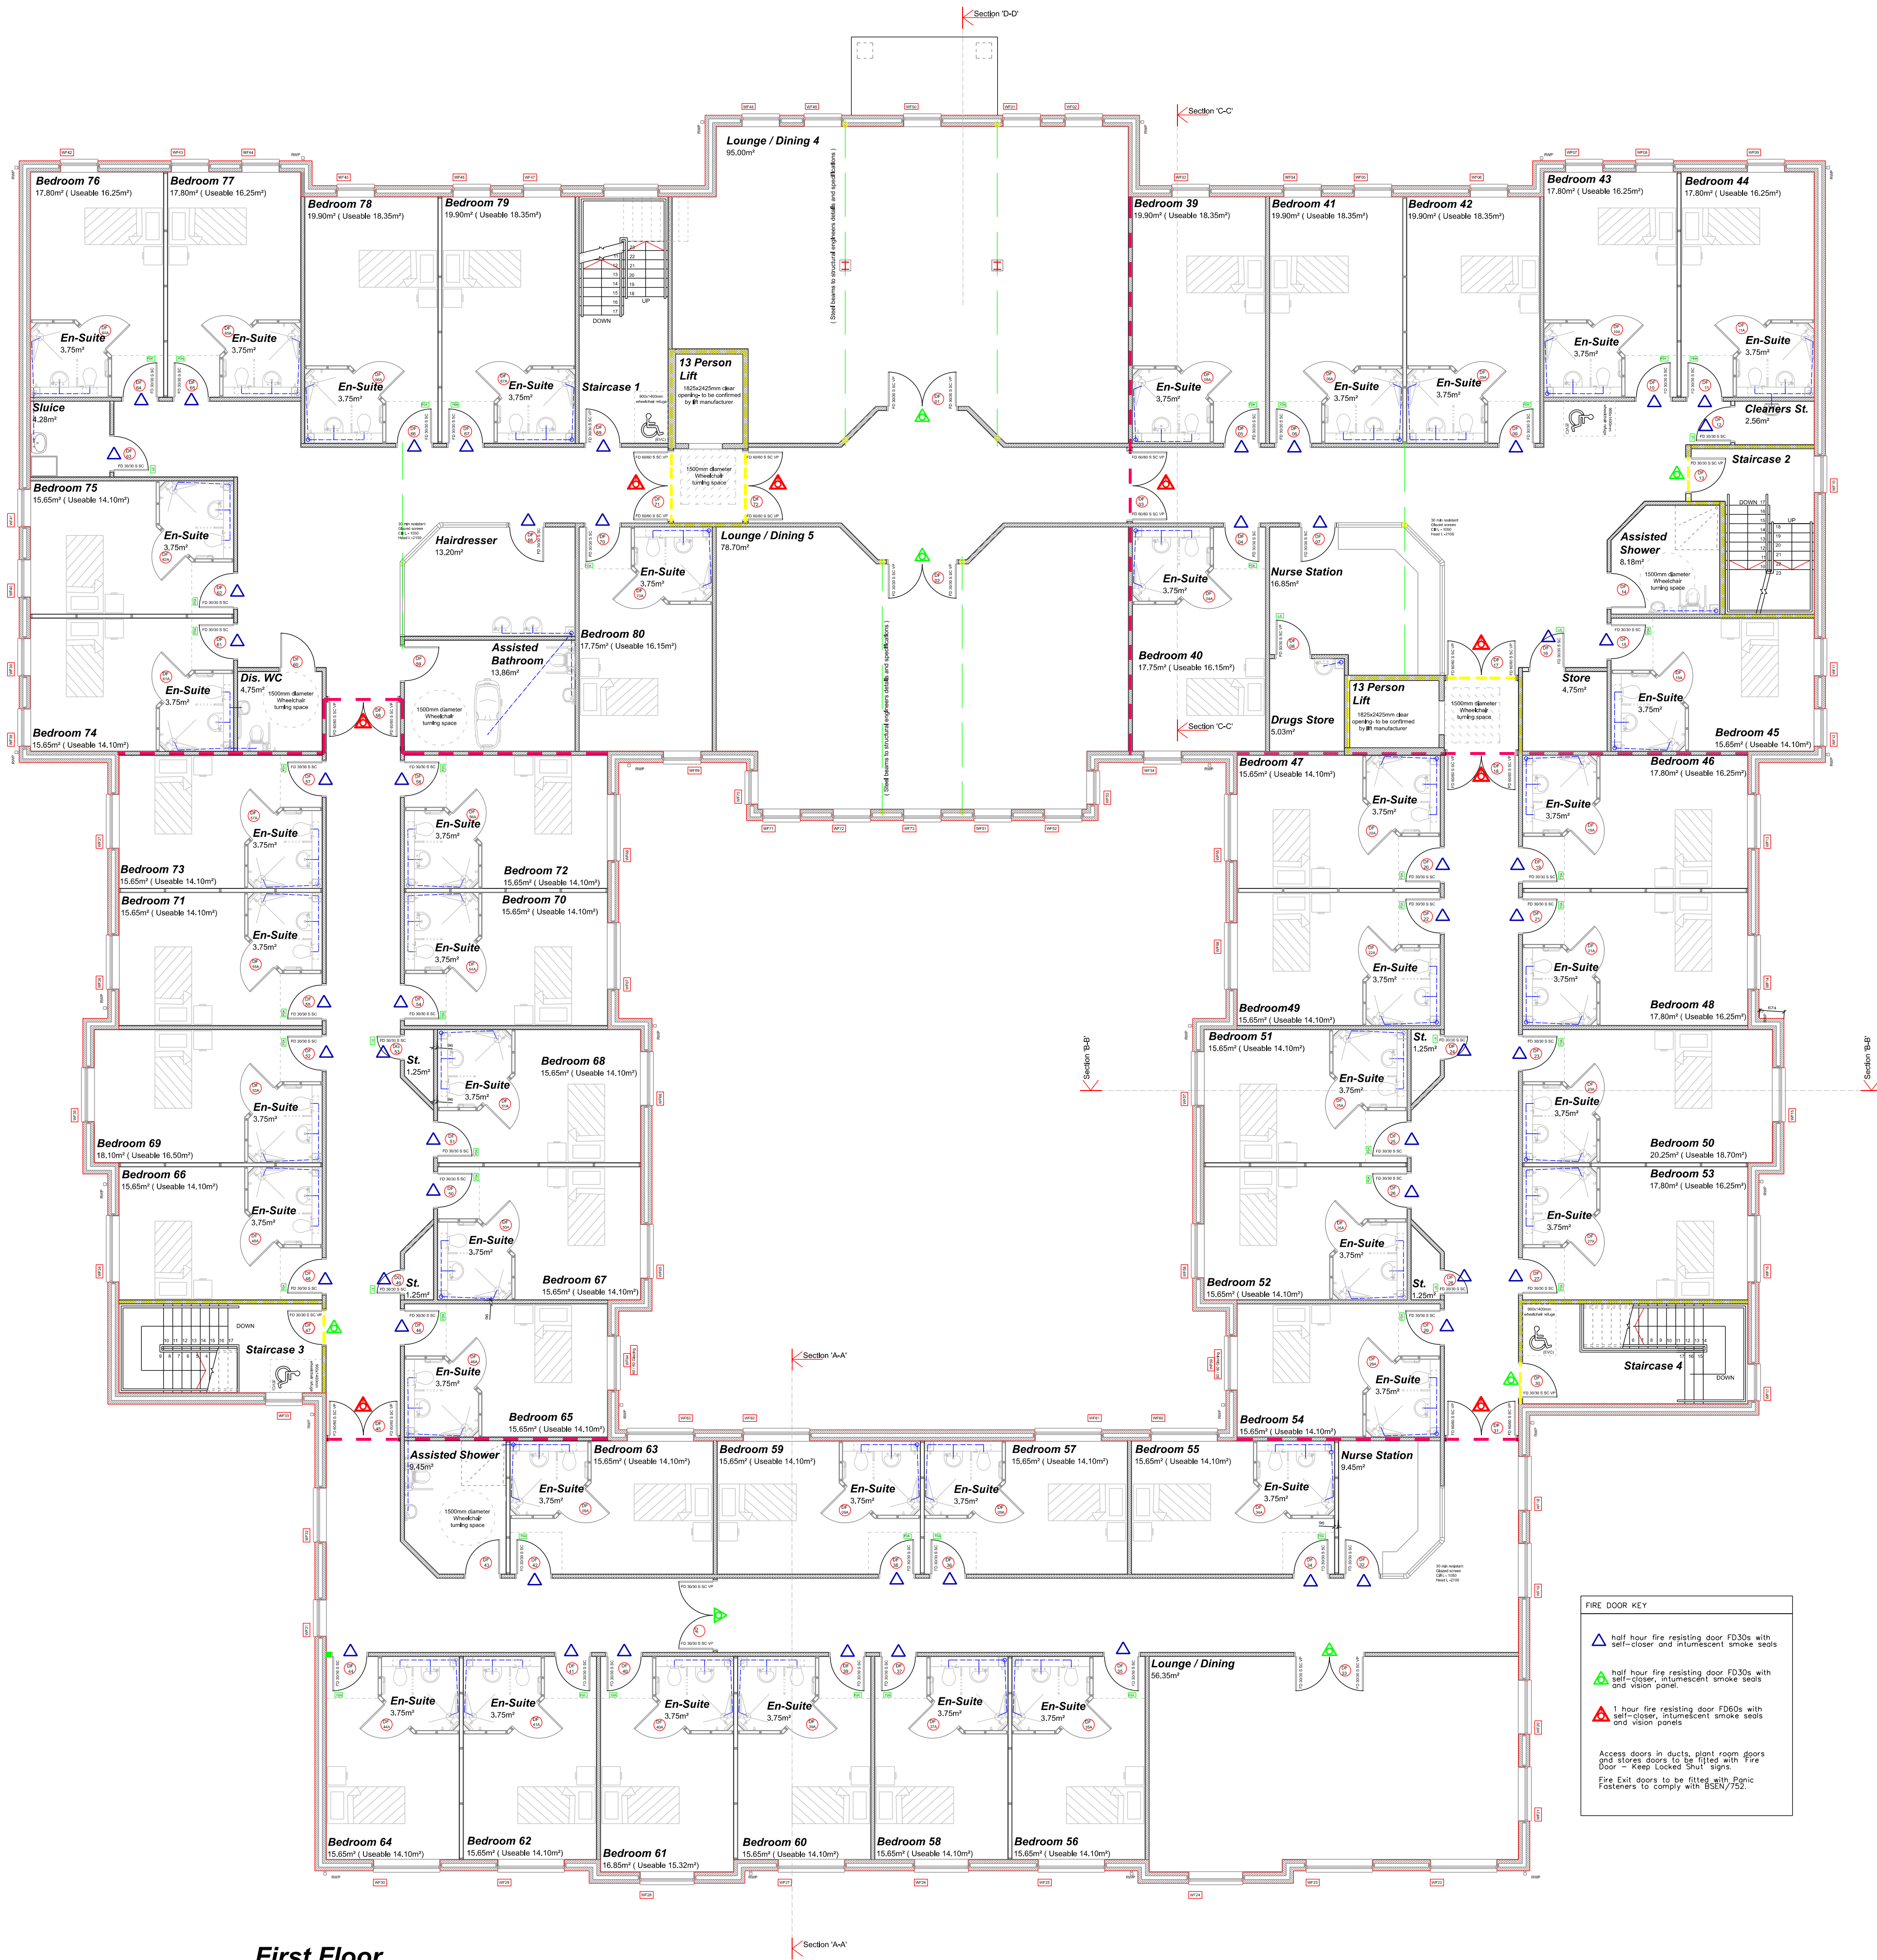


STAGE: AS BUILT

PROJECT
WALBERTON PLACE CARE HOME
YAPTON LANE
WALBERTON
ARUNDEL
WEST SUSSEX
BN15 0AS

DRAWING
FIRST FLOOR PLAN

PROJECT NO.	DRAWING NO.	REVISION
3112	L-02	A

DATE	SCALES	DRAWN BY
APR '19	1:100@A1	

MARIO MINCHELLA ARCHITECTS

UNIT 4, WITNEY WAY,
HI-TECH VILLAGE,
BOLDON BUSINESS PARK
TYNE AND WEAR
NE35 9PE
T: 0191 3802227
E: info@m-m-a.net
W: www.m-m-a.net

THIS DRAWING IS
COPYRIGHT OF
DAMIAN LIMITED

NOT TO BE SCALED
ALL DIMENSIONS TO
BE CHECKED ON SITE