



REV 'A' 08/05/19
1) ROOF DUCTS ADDED

REV 'B' 08/05/19
1) DUCTS FROM LAUNDRY ADDED

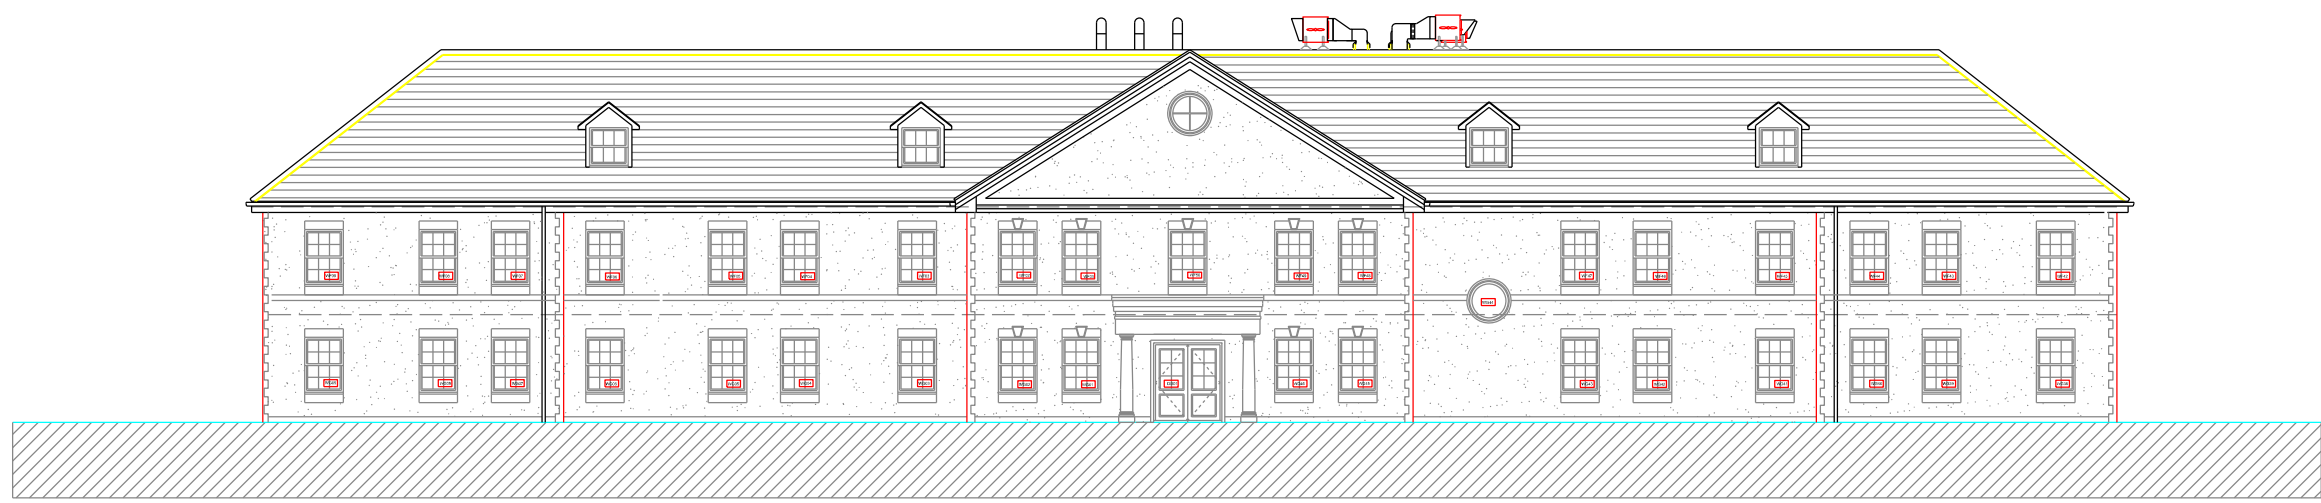


FRONT (NORTH) ELEVATION

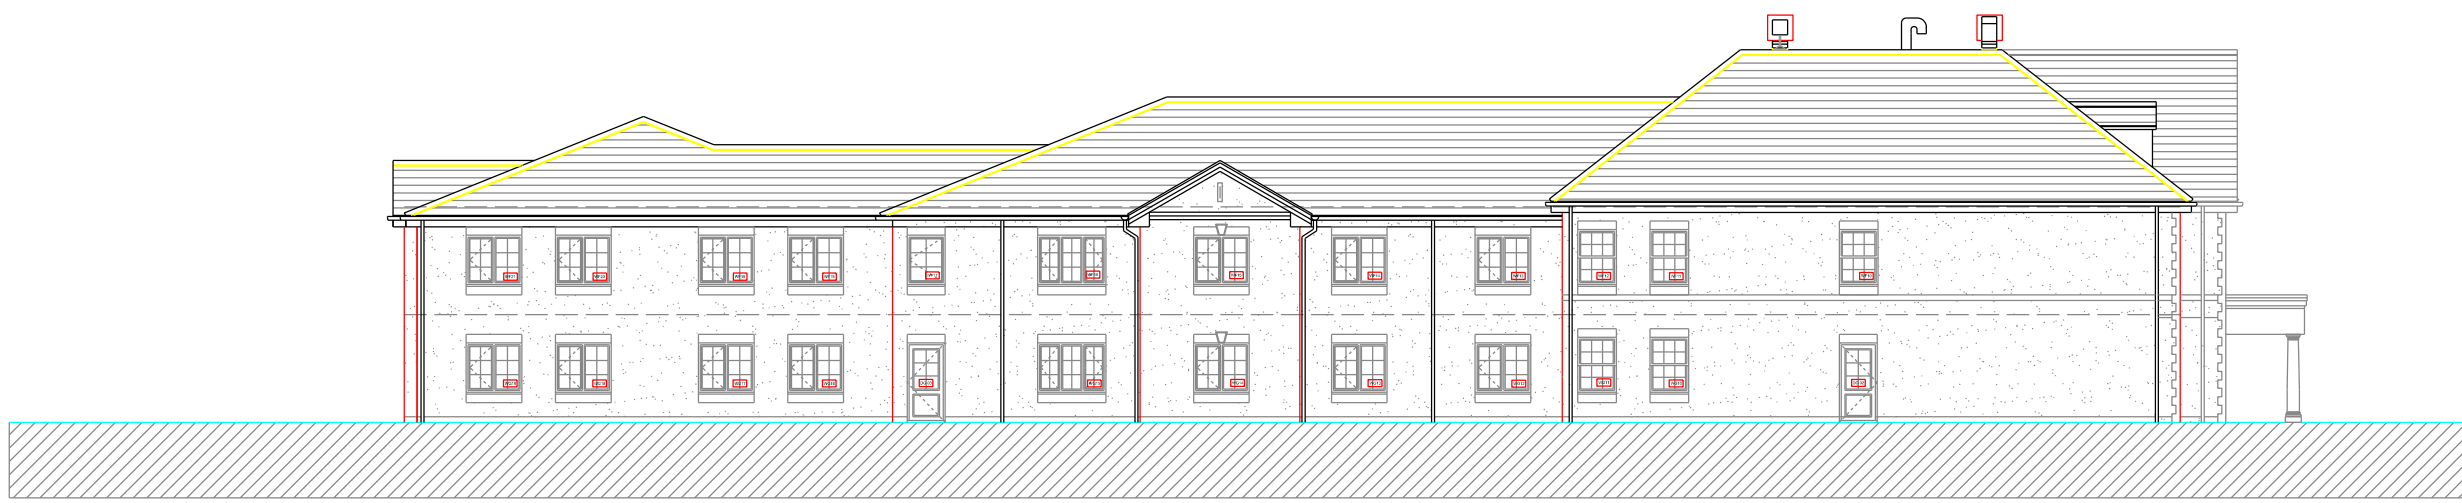

SIDE (EAST) ELEVATION




REAR (SOUTH) ELEVATION

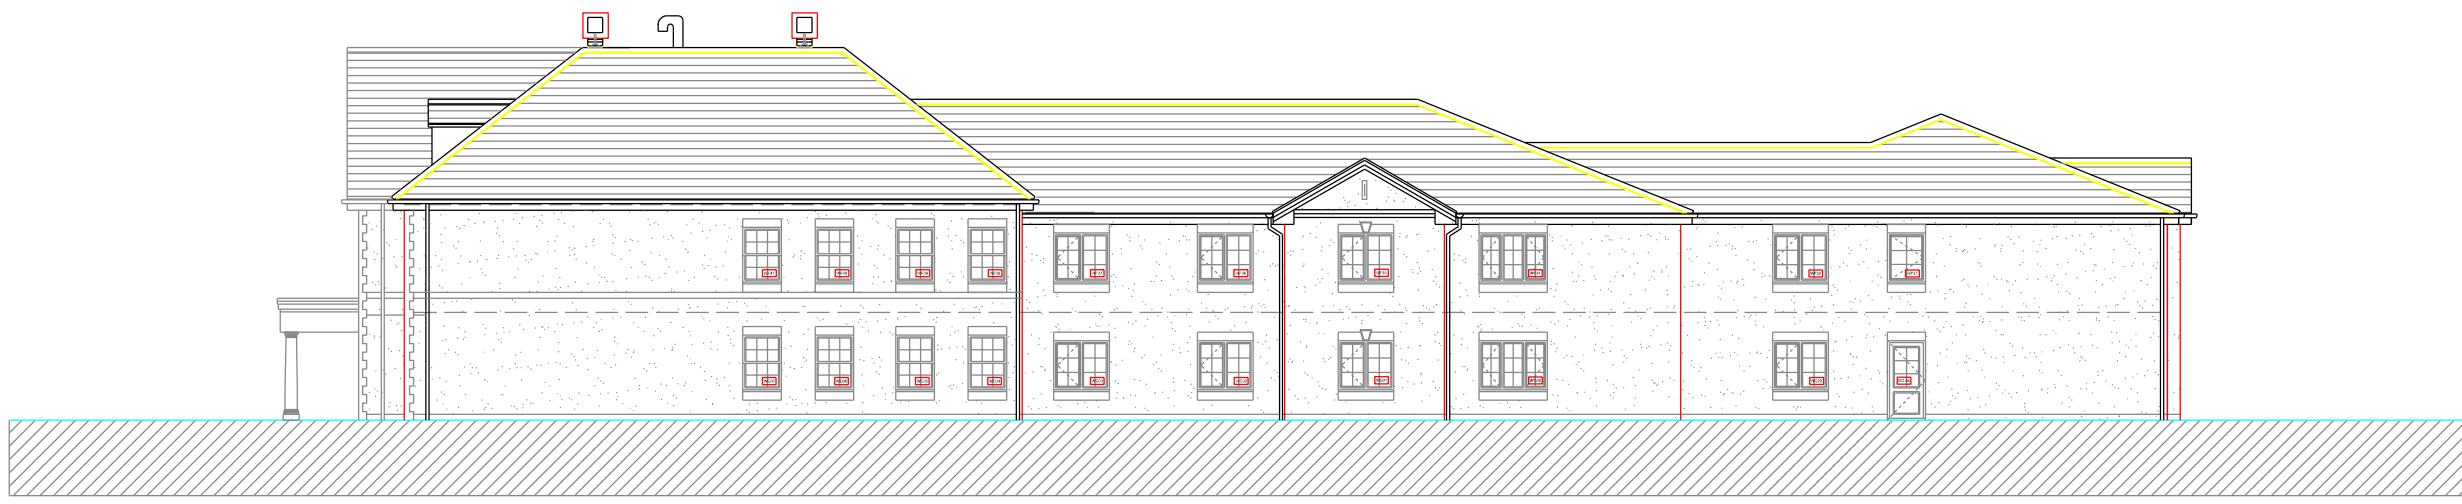

SIDE (WEST) ELEVATION

AS BUILT ELEVATIONS

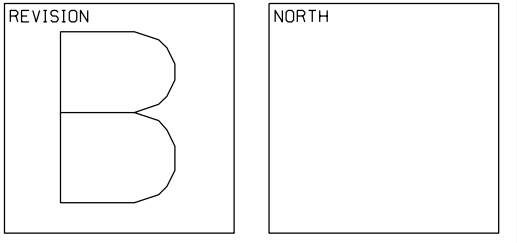

STAGE: AS BUILT


PROJECT
WALBERTON PLACE CARE HOME
YAPTON LANE
WALBERTON
ARUNDEL
WEST SUSSEX
BN18 0AS

DRAWING
ELEVATION DRAWINGS

PROJECT NO.	DRAWING NO.	REVISION
3112	L-05	B
DATE	SCALES	DRAWN BY
APR 19	1:200@A1	BAS

MARIO MINCHELLA ARCHITECTS

UNIT 4, WITNEY WAY,
HI-TECH VILLAGE,
BOLDON BUSINESS PARK
TYNE AND WEAR
NE35 9PE
T: 0191 3802227
E: info@micha.net
W: www.micha.net

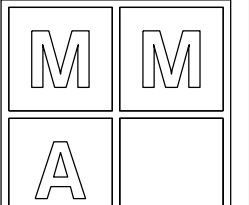

THIS DRAWING IS
COPYRIGHT OF
DAJAM LIMITED

NOT TO BE SCALED
ALL DIMENSIONS TO
BE CHECKED ON SITE