





FRONT (NORTH) COURTYARD ELEVATION



SIDE (EAST) COURTYARD ELEVATION

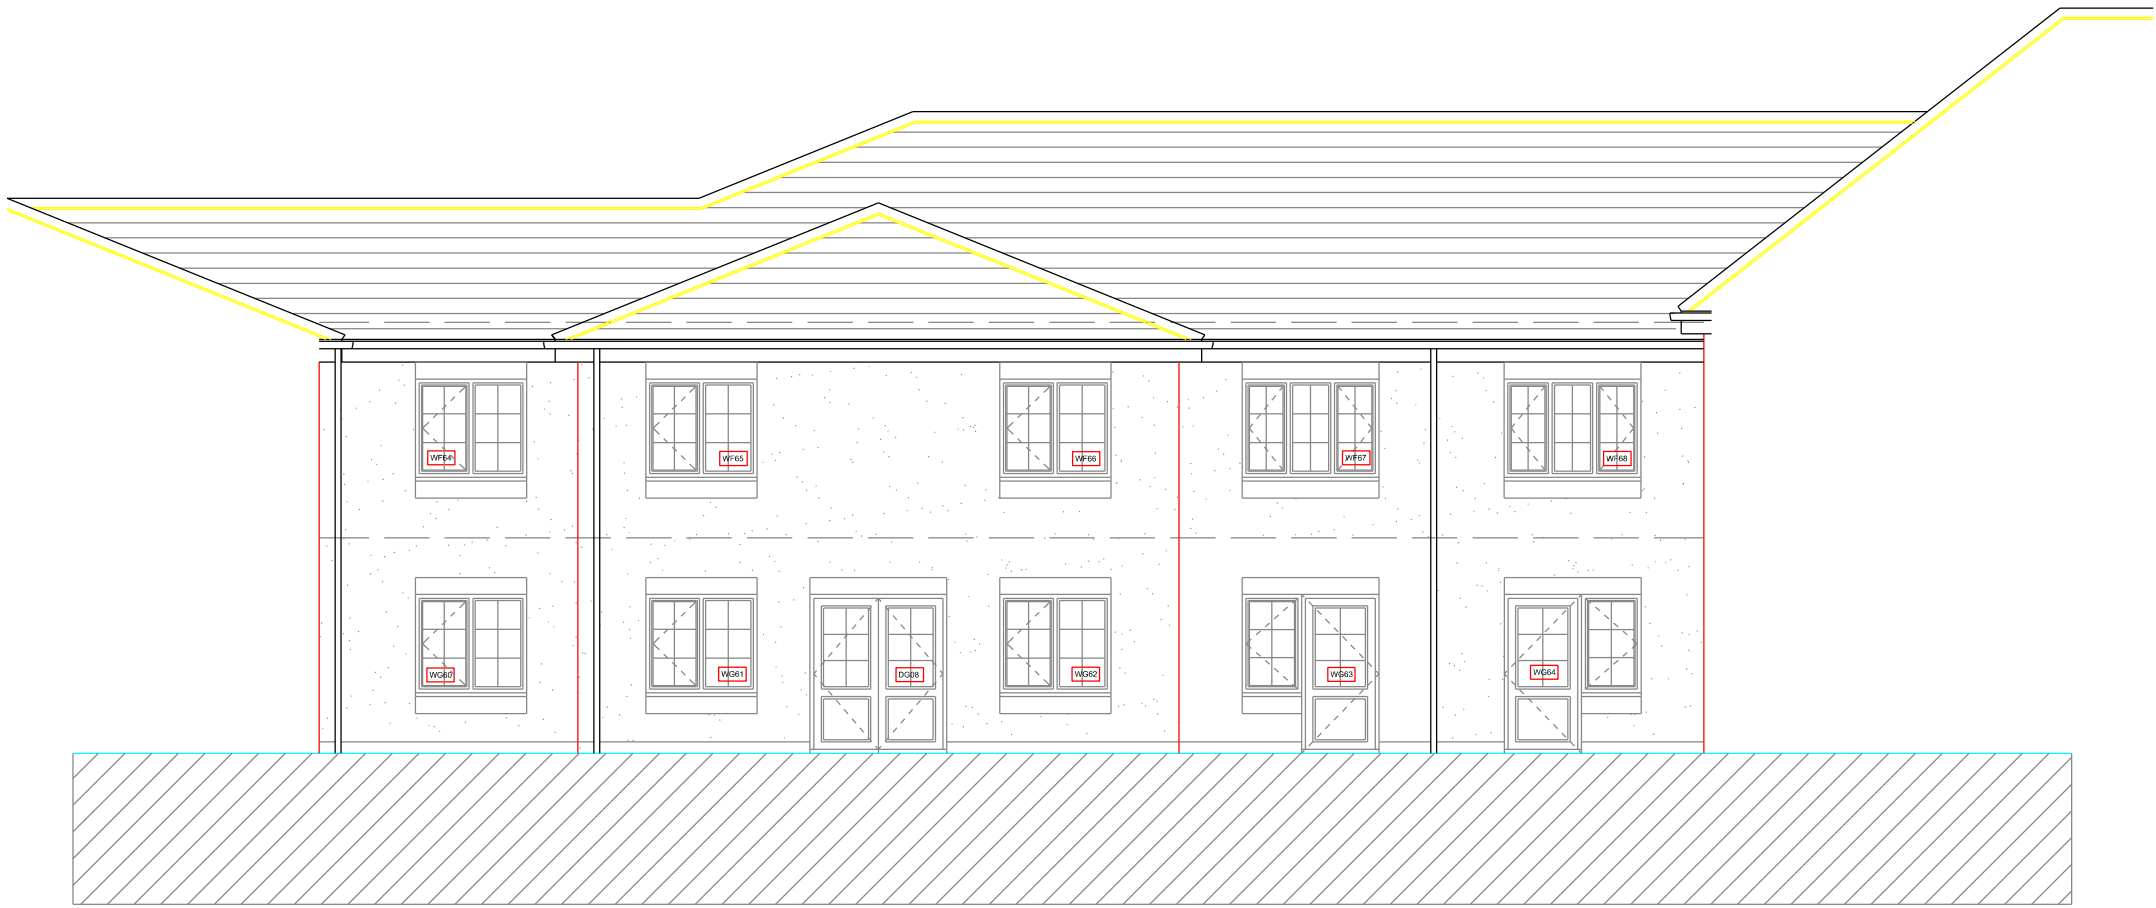

REAR (SOUTH) COURTYARD ELEVATION

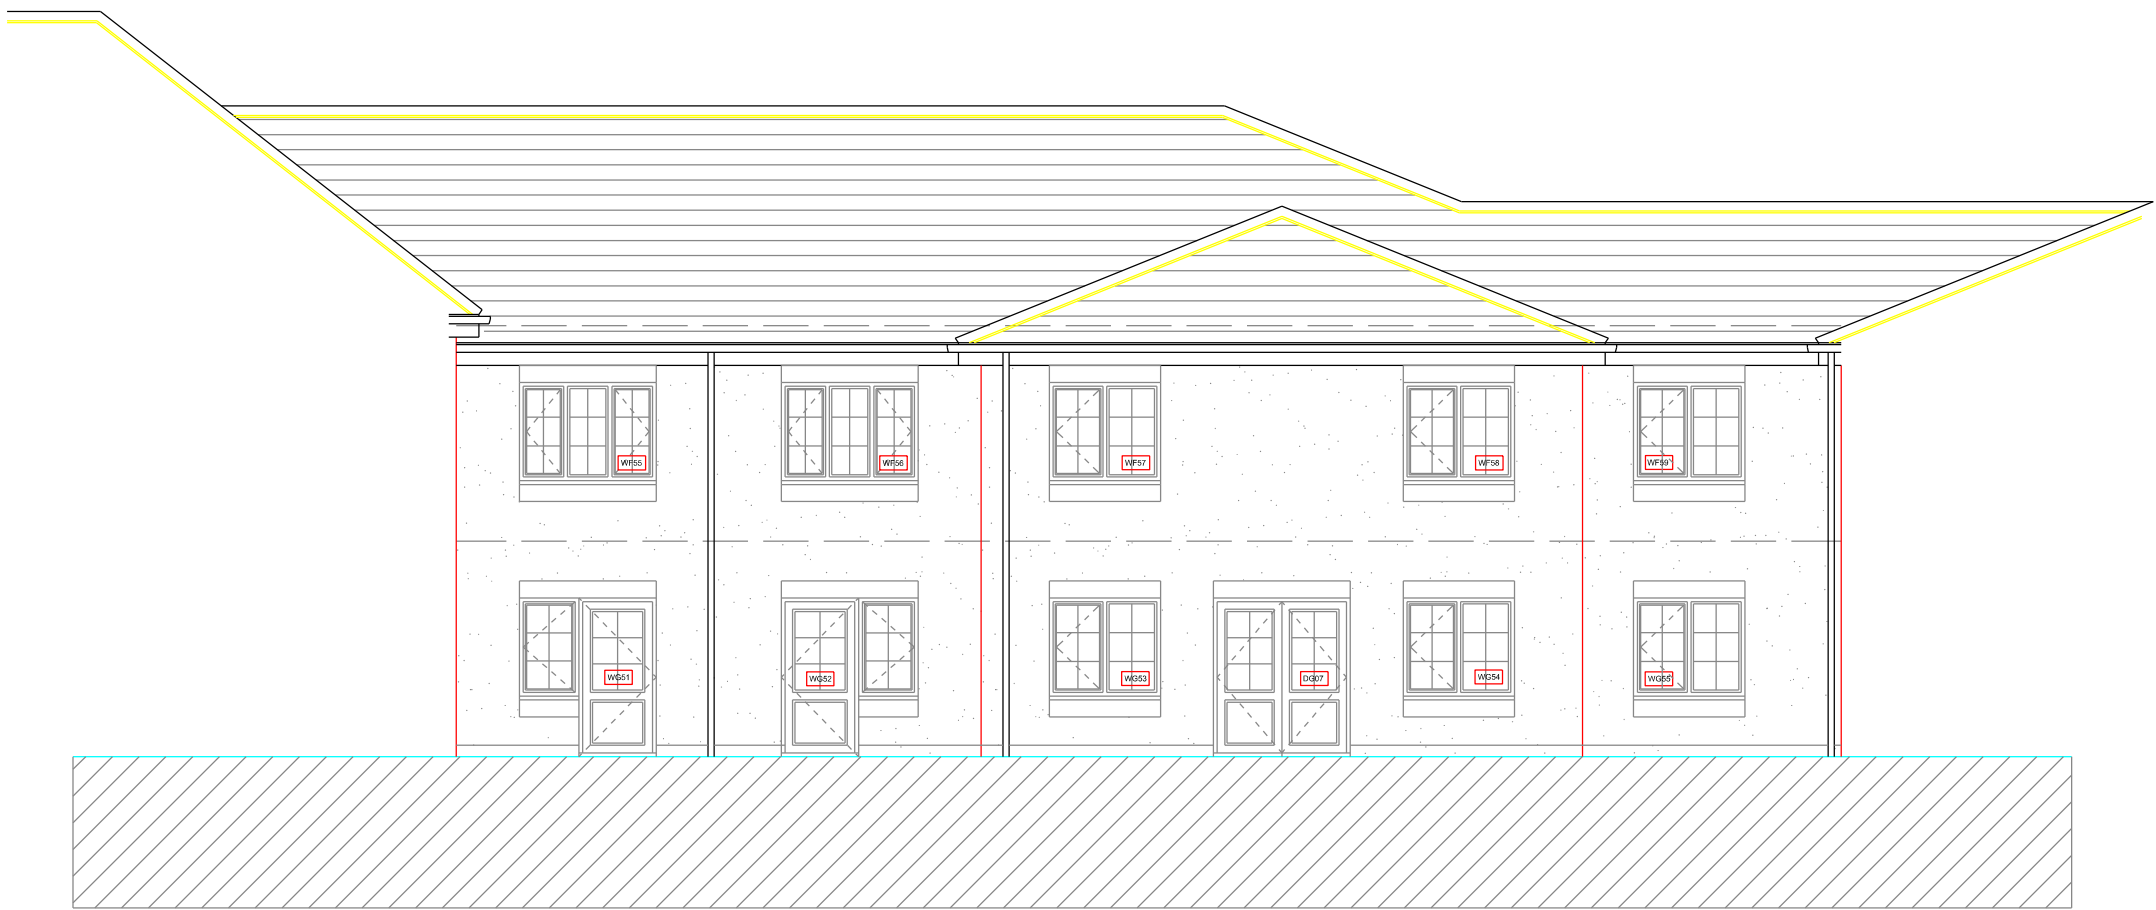

SIDE (WEST) COURTYARD ELEVATION

AS BUILT COURTYARD ELEVATIONS

REVISION DATE / DESCRIPTION
REVISION 'A' 08/05/19
1) ROOF DUCTS ADDED
REVISION 'B' 08/05/19
1) LAUNDRY DUCTS ADDED

REVISION

B

NORTH

STAGE: AS BUILT

PROJECT
WALBERTON PLACE CARE HOME
YAPTON LANE
WALBERTON
ARUNDEL
WEST SUSSEX
BN18 0AS

DRAWING
COURTYARD ELEVATION DRAWINGS

PROJECT NO.	DRAWING NO.	REVISION
3112	L-06	B
DATE	SCALES	DRAWN BY
APR 19	1:50@A1	

MARIO MINCHELLA ARCHITECTS

UNIT 4, WITNEY WAY,
HI-TECH VILLAGE,
BOLDON BUSINESS PARK
TYNE AND WEAR
NE35 9PE
T: 0191 3802227
W: www.mma.net
E: info@mma.net

M

M

A

THIS DRAWING IS
COPYRIGHT OF
DMAJAN LIMITED

NOT TO BE SCALED
ALL DIMENSIONS TO
BE CHECKED ON SITE