


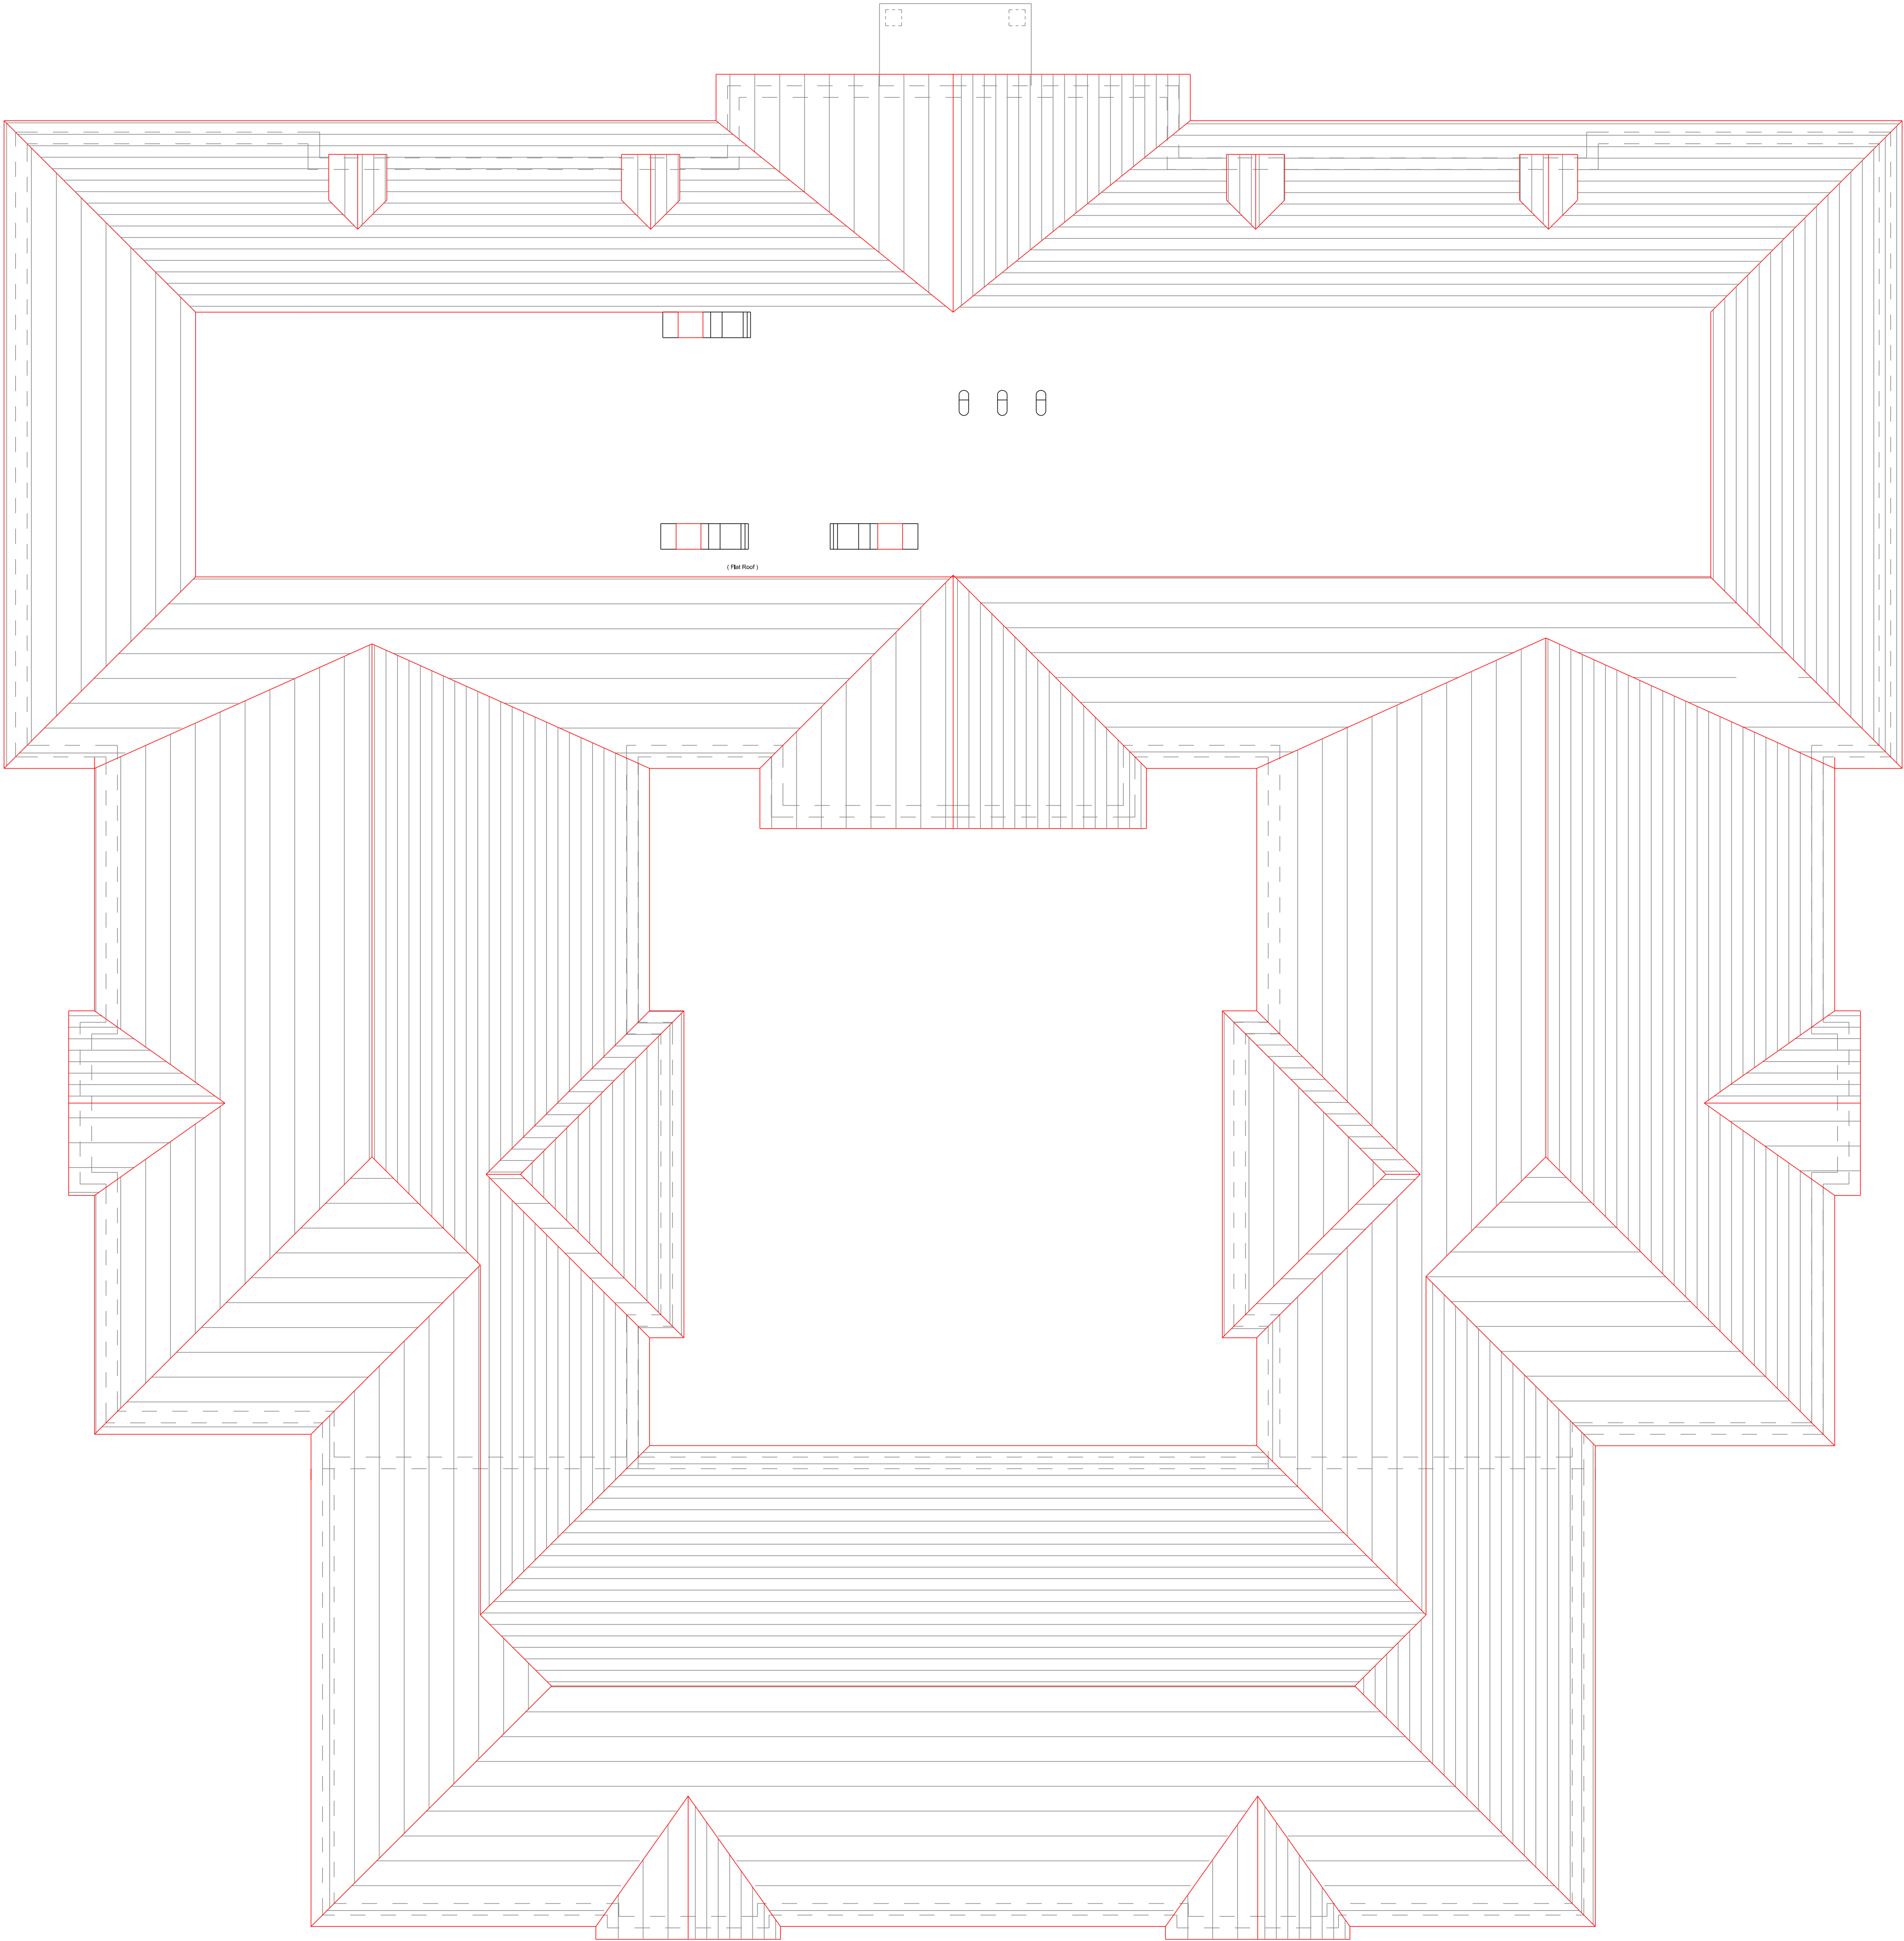

Roof Plan

AS BUILT ROOF PLAN

REVISION DATE / DESCRIPTION
REVISION 'A' 08/05/19
- ROOF DUCTS ADDED
REVISION 'B' 08/05/19
- LAUNDRY DUCTS ADDED
REVISION 'C' 08/05/19
- RESITING OF BUILDING FOOTPRINT

REVISION
C

NORTH

STAGE: AS BUILT

PROJECT
WALBERTON PLACE CARE HOME
YAPTON LANE
ARUNDEL
WEST SUSSEX
BN18 0AS

DRAWING
ROOF PLAN

PROJECT NO. 3112	DRAWING NO. L-11	REVISION C
DATE APR 19	SCALES 1:100@A1	DRAWN BY

MARIO MINCHELLA ARCHITECTS
UNIT 4, WITNEY WAY,
HI-TECH VILLAGE,
BOLDON BUSINESS PARK
TYNE AND WEAR
NE35 9PE
T: 0191 3802227
E: www@m-m.net
www.m-m.net
info@m-m.net

THIS DRAWING IS
COPYRIGHT OF
DASAM LIMITED

NOT TO BE SCALED
ALL DIMENSIONS TO
BE CHECKED ON SITE