


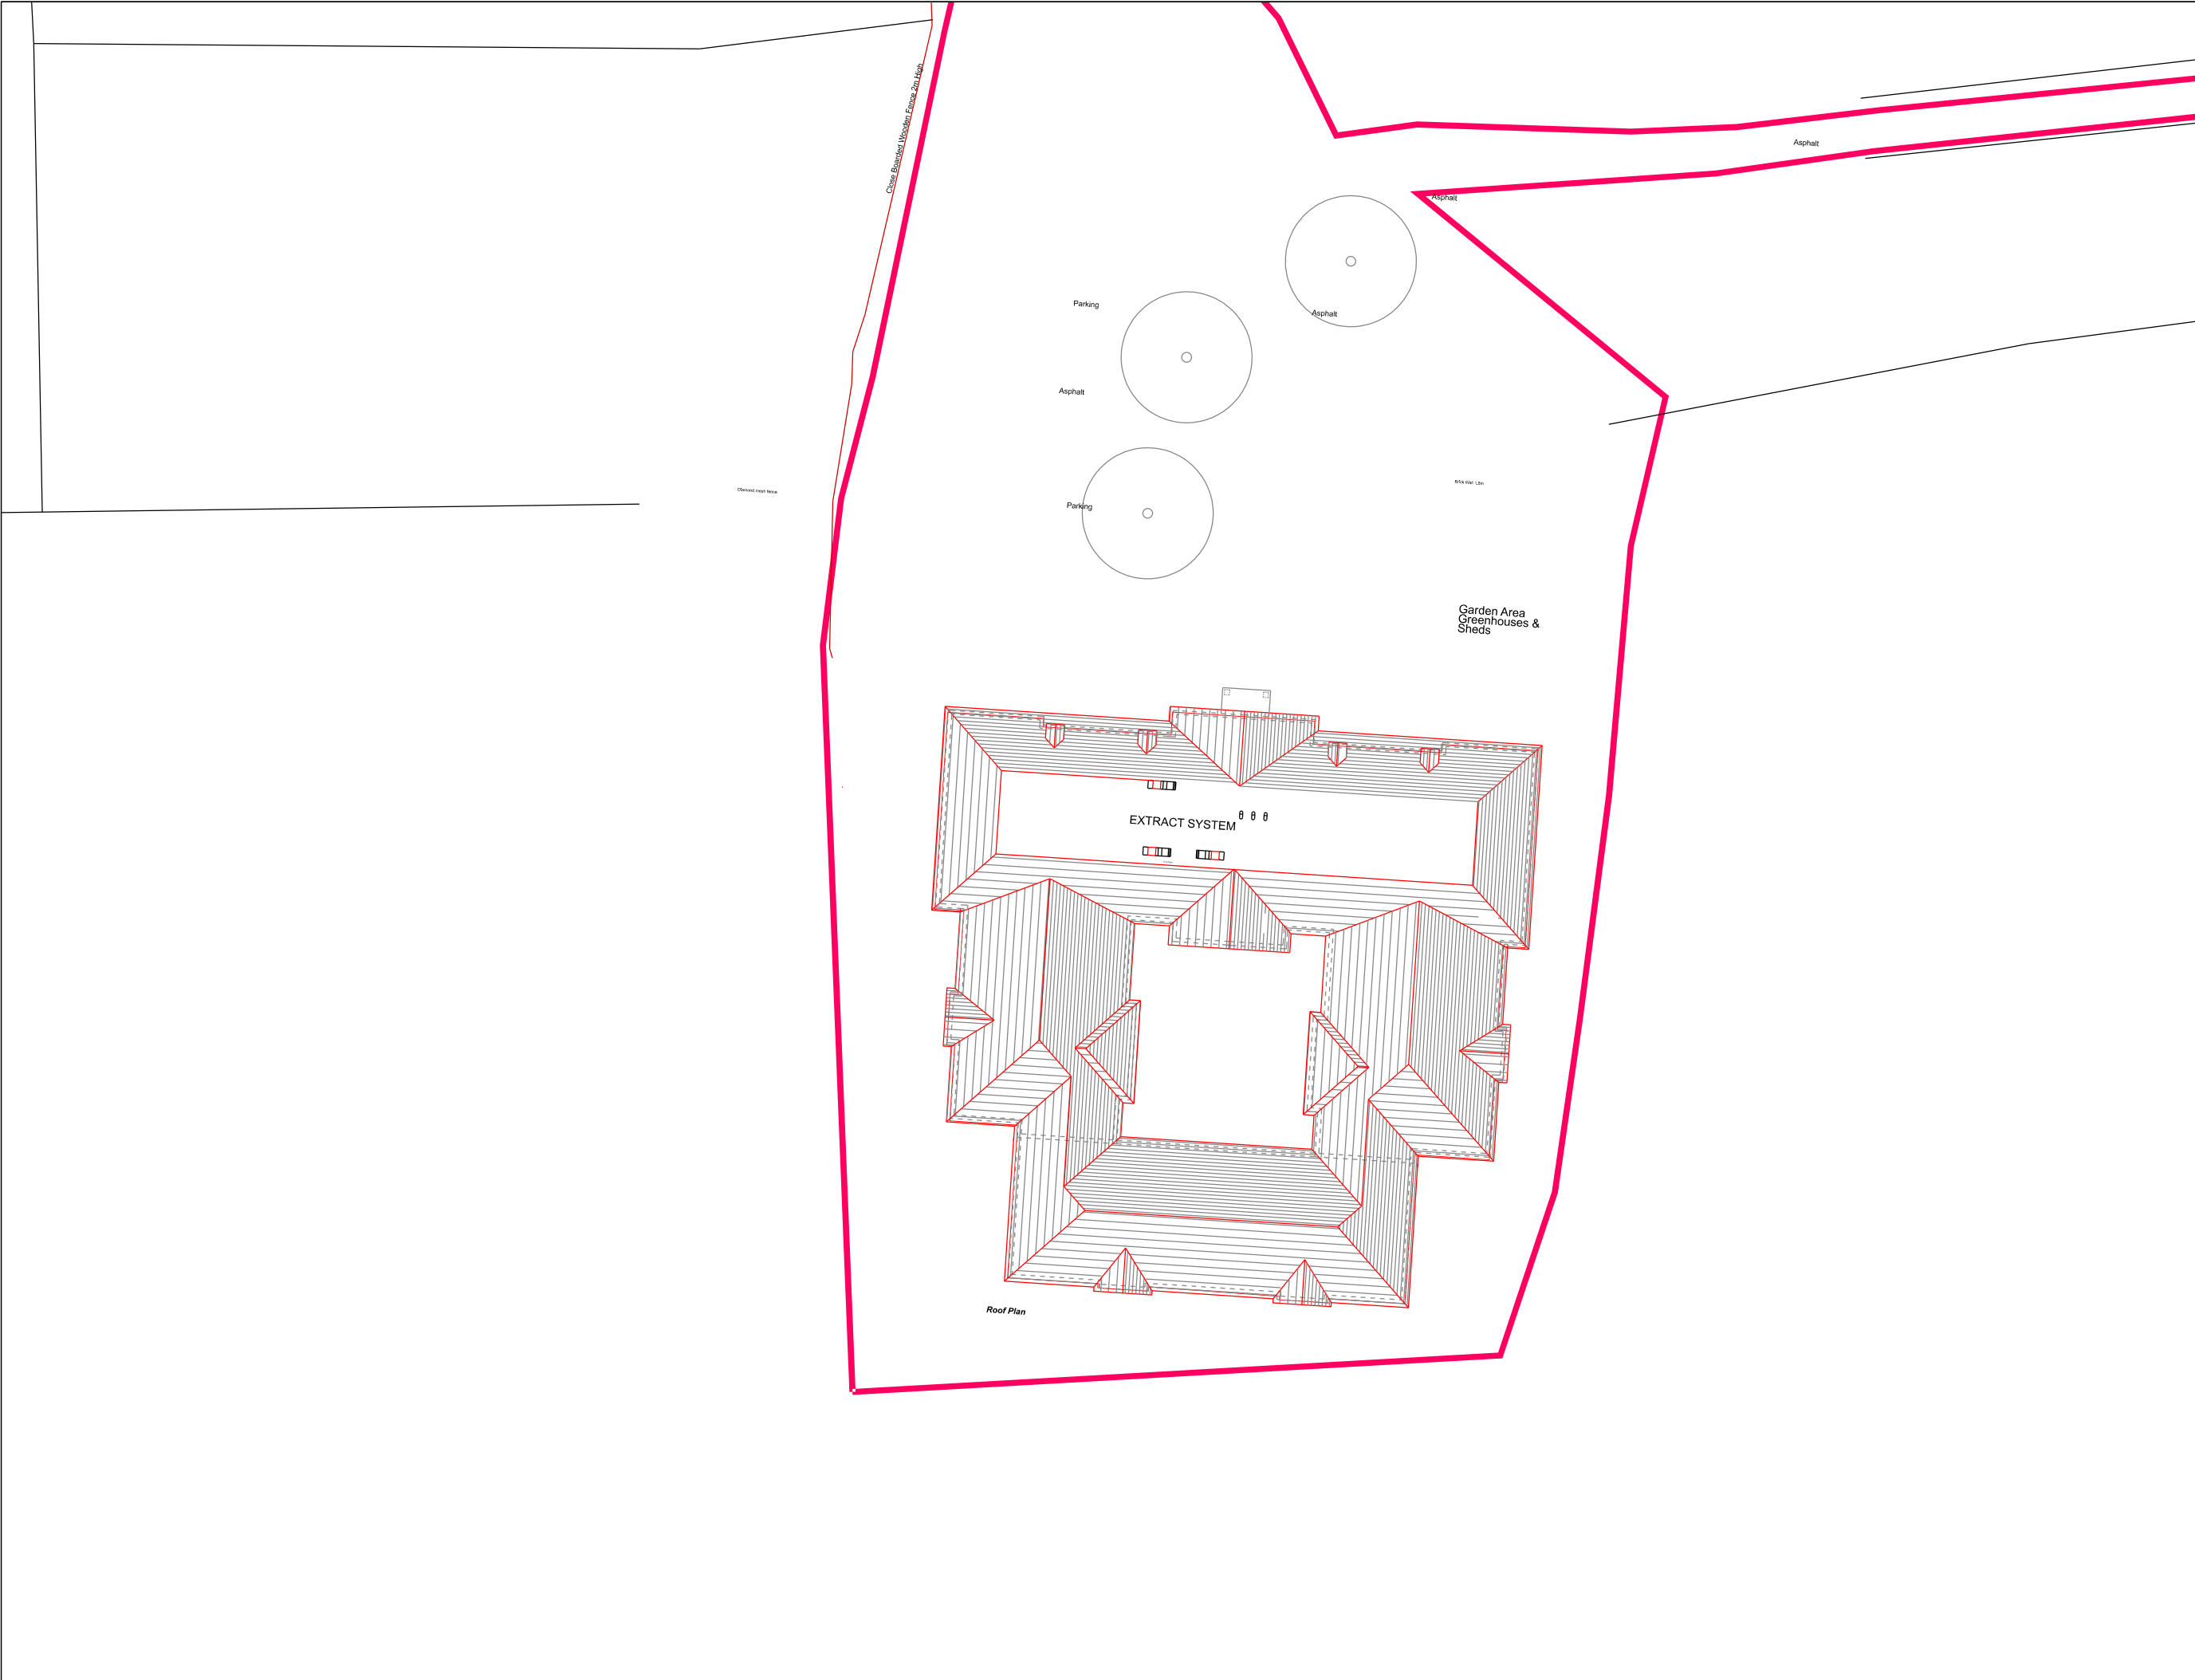

REVISION DATE / DESCRIPTION
REVISION 'A' 01/07/19
- ROOF PLAN WITH EXTRACTION
SYSTEM ADDED

REVISION
A

NORTH

STAGE: AS BUILT

PROJECT
WALBERTON PLACE
CARE HOME
YAPTON LANE
WALBERTON
ARUNDEL

DRAWING
SITE PLAN

PROJECT NO. 3112	DRAWING NO. L-00	REVISION A
DATE APR 19	SCALES 1:500 @ A3	DRAWN BY BAS

MARIO MINCHELLA ARCHITECTS

UNIT 4, WITNEY WAY,
HI-TECH VILLAGE,
BOLDON BUSINESS PARK
TINE AND WEAR
NEAR WYE
T: 0191 3882227
W: www.mma-architects.co.uk
E: info@m-m-a.net

MM

A

THIS DRAWING IS
COPYRIGHT OF
MMA

NOT TO BE SCALED
ALL DIMENSIONS TO
BE CHECKED ON SITE