



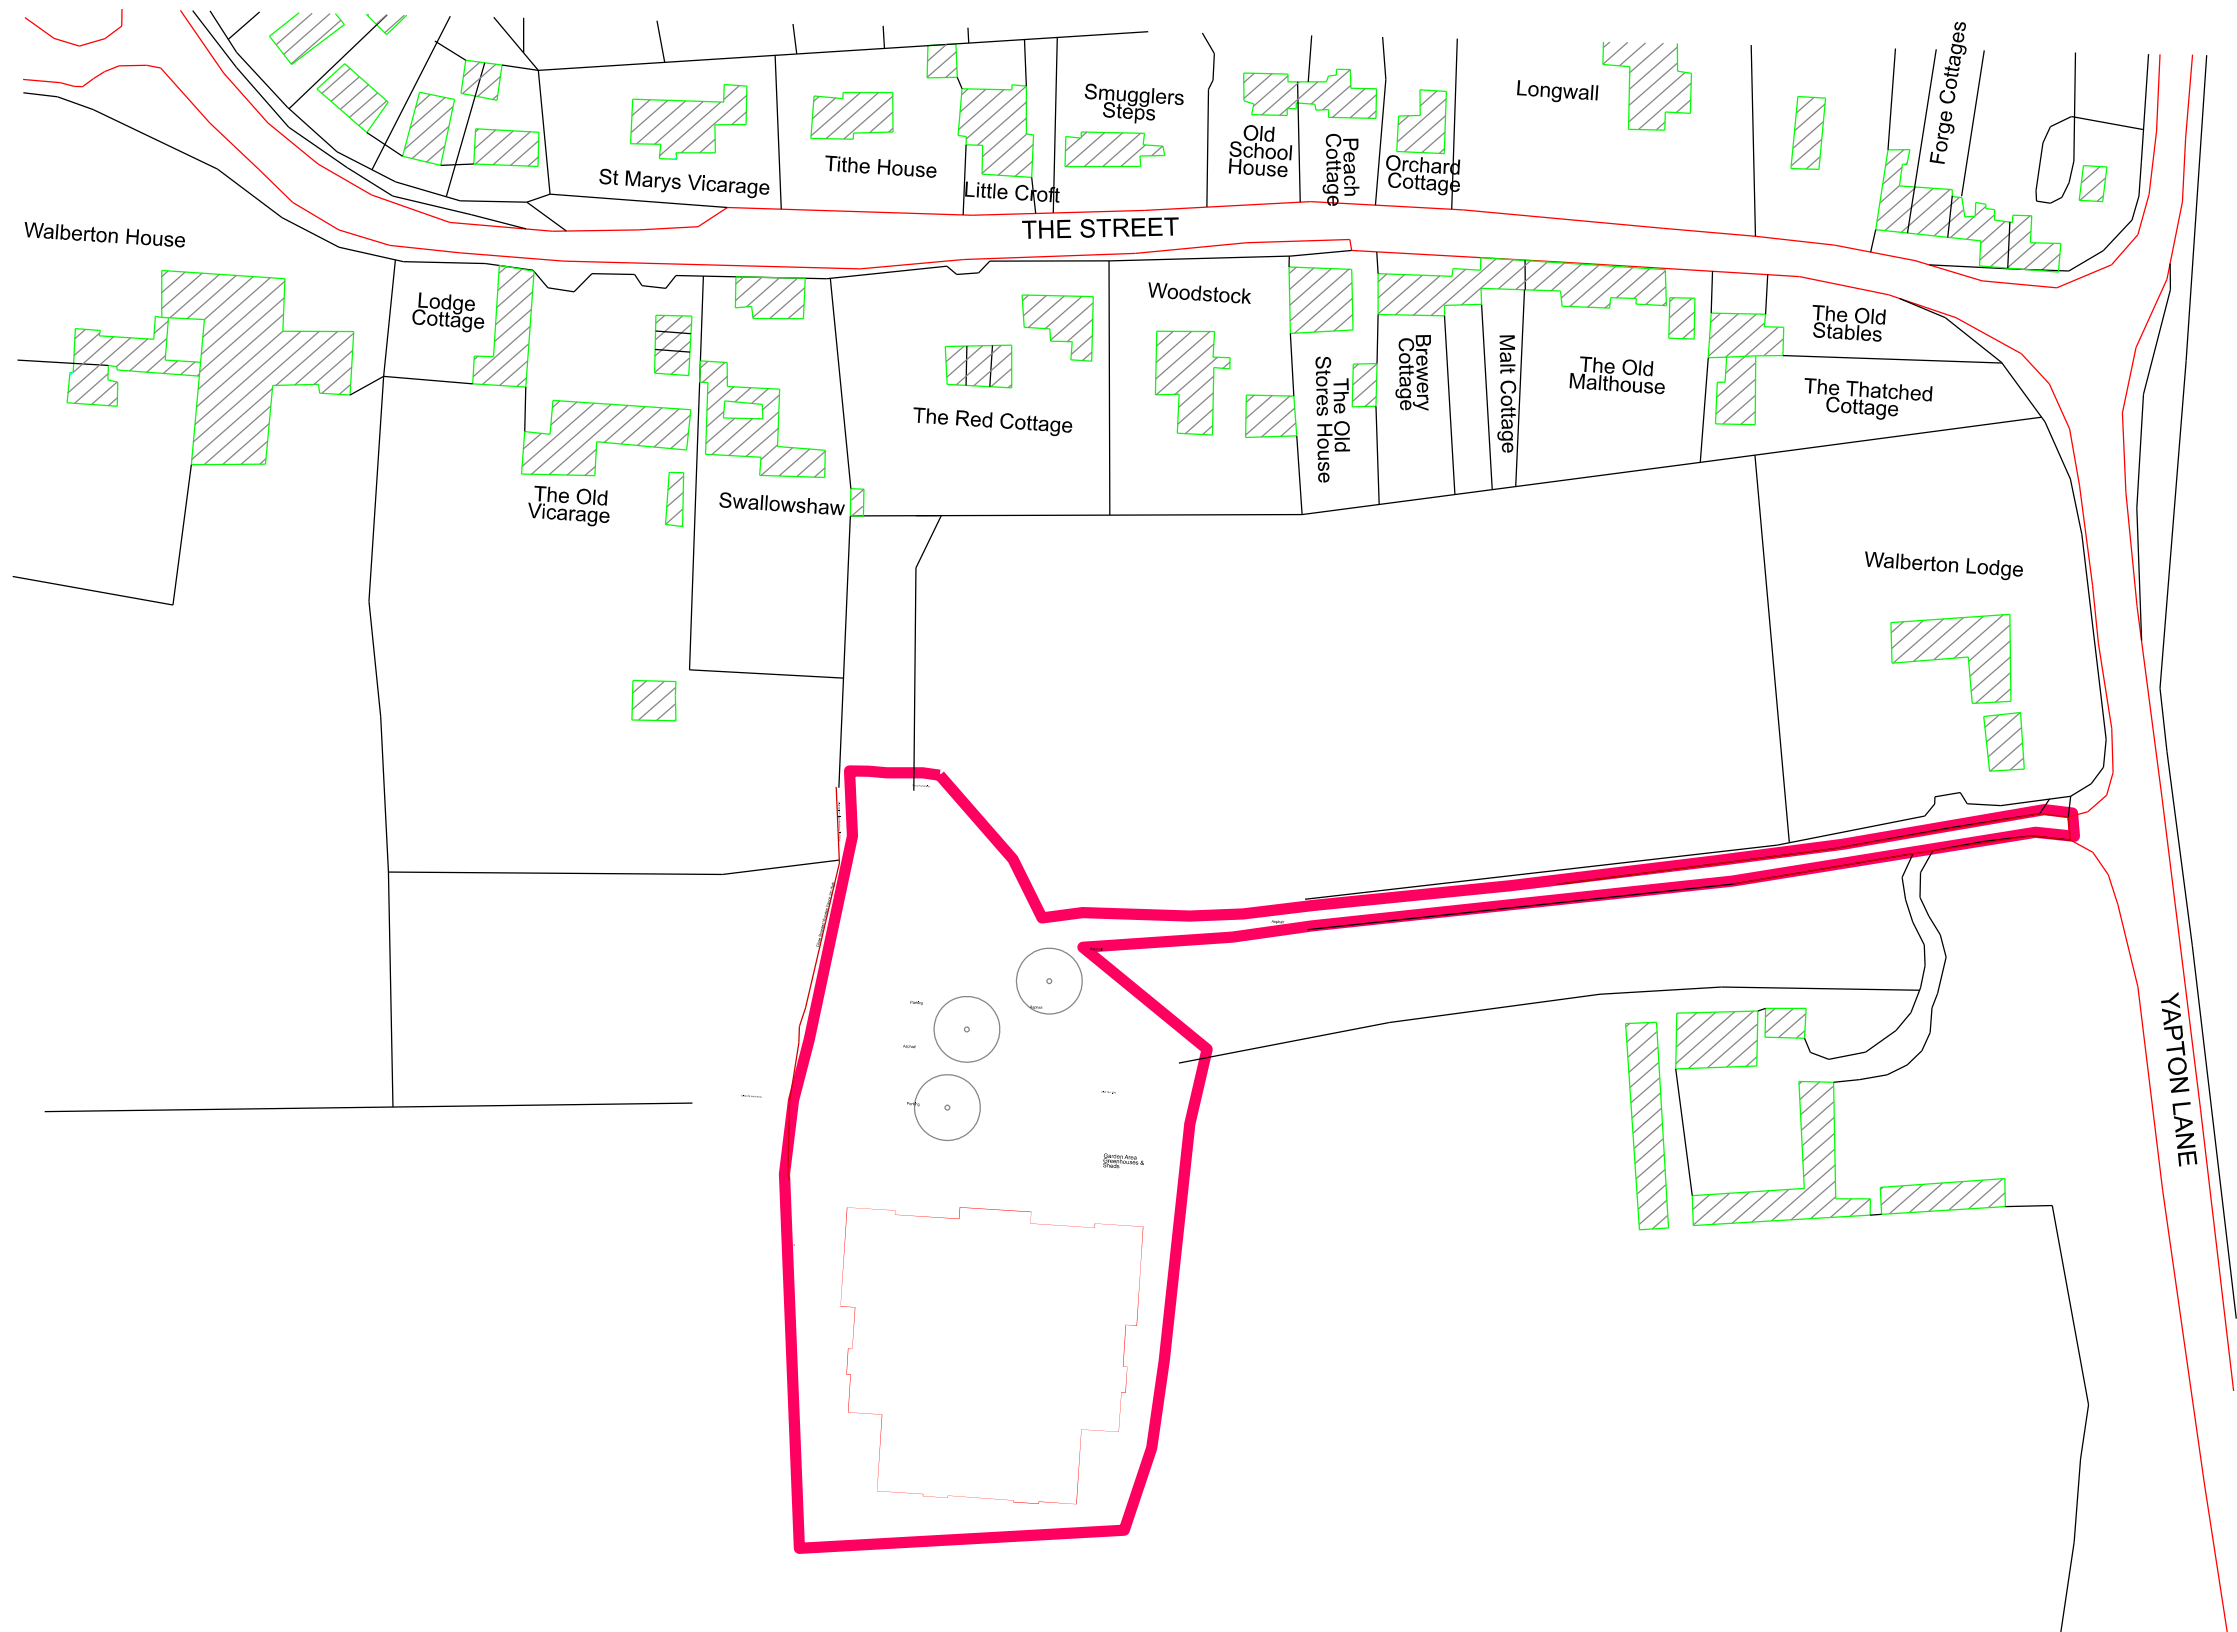

REVISION DATE / DESCRIPTION

REVISION 'A' 28/05/19
- RESITING OF BUILDING FOOTPRINT

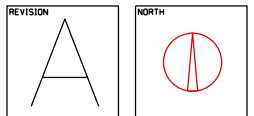

STAGE: AS BUILT

PROJECT
WALBERTON PLACE CARE HOME
YAPTON LANE
WALBERTON
ARUNDEL
WEST SUSSEX
BN18 0AS

DRAWING
LOCATION PLAN

PROJECT NO. 3112	DRAWING NO. L-12	REVISION A
---------------------	---------------------	---------------

DATE APR '19	SCALE 1:1250@A3	DRAWN BY BAS
-----------------	--------------------	-----------------

MARIO MINCHELLA ARCHITECTS



THIS DRAWING IS COPYRIGHT OF MUMAH LIMITED	NOT TO BE SCALED ALL DIMENSIONS TO BE CHECKED ON SITE
--	---