


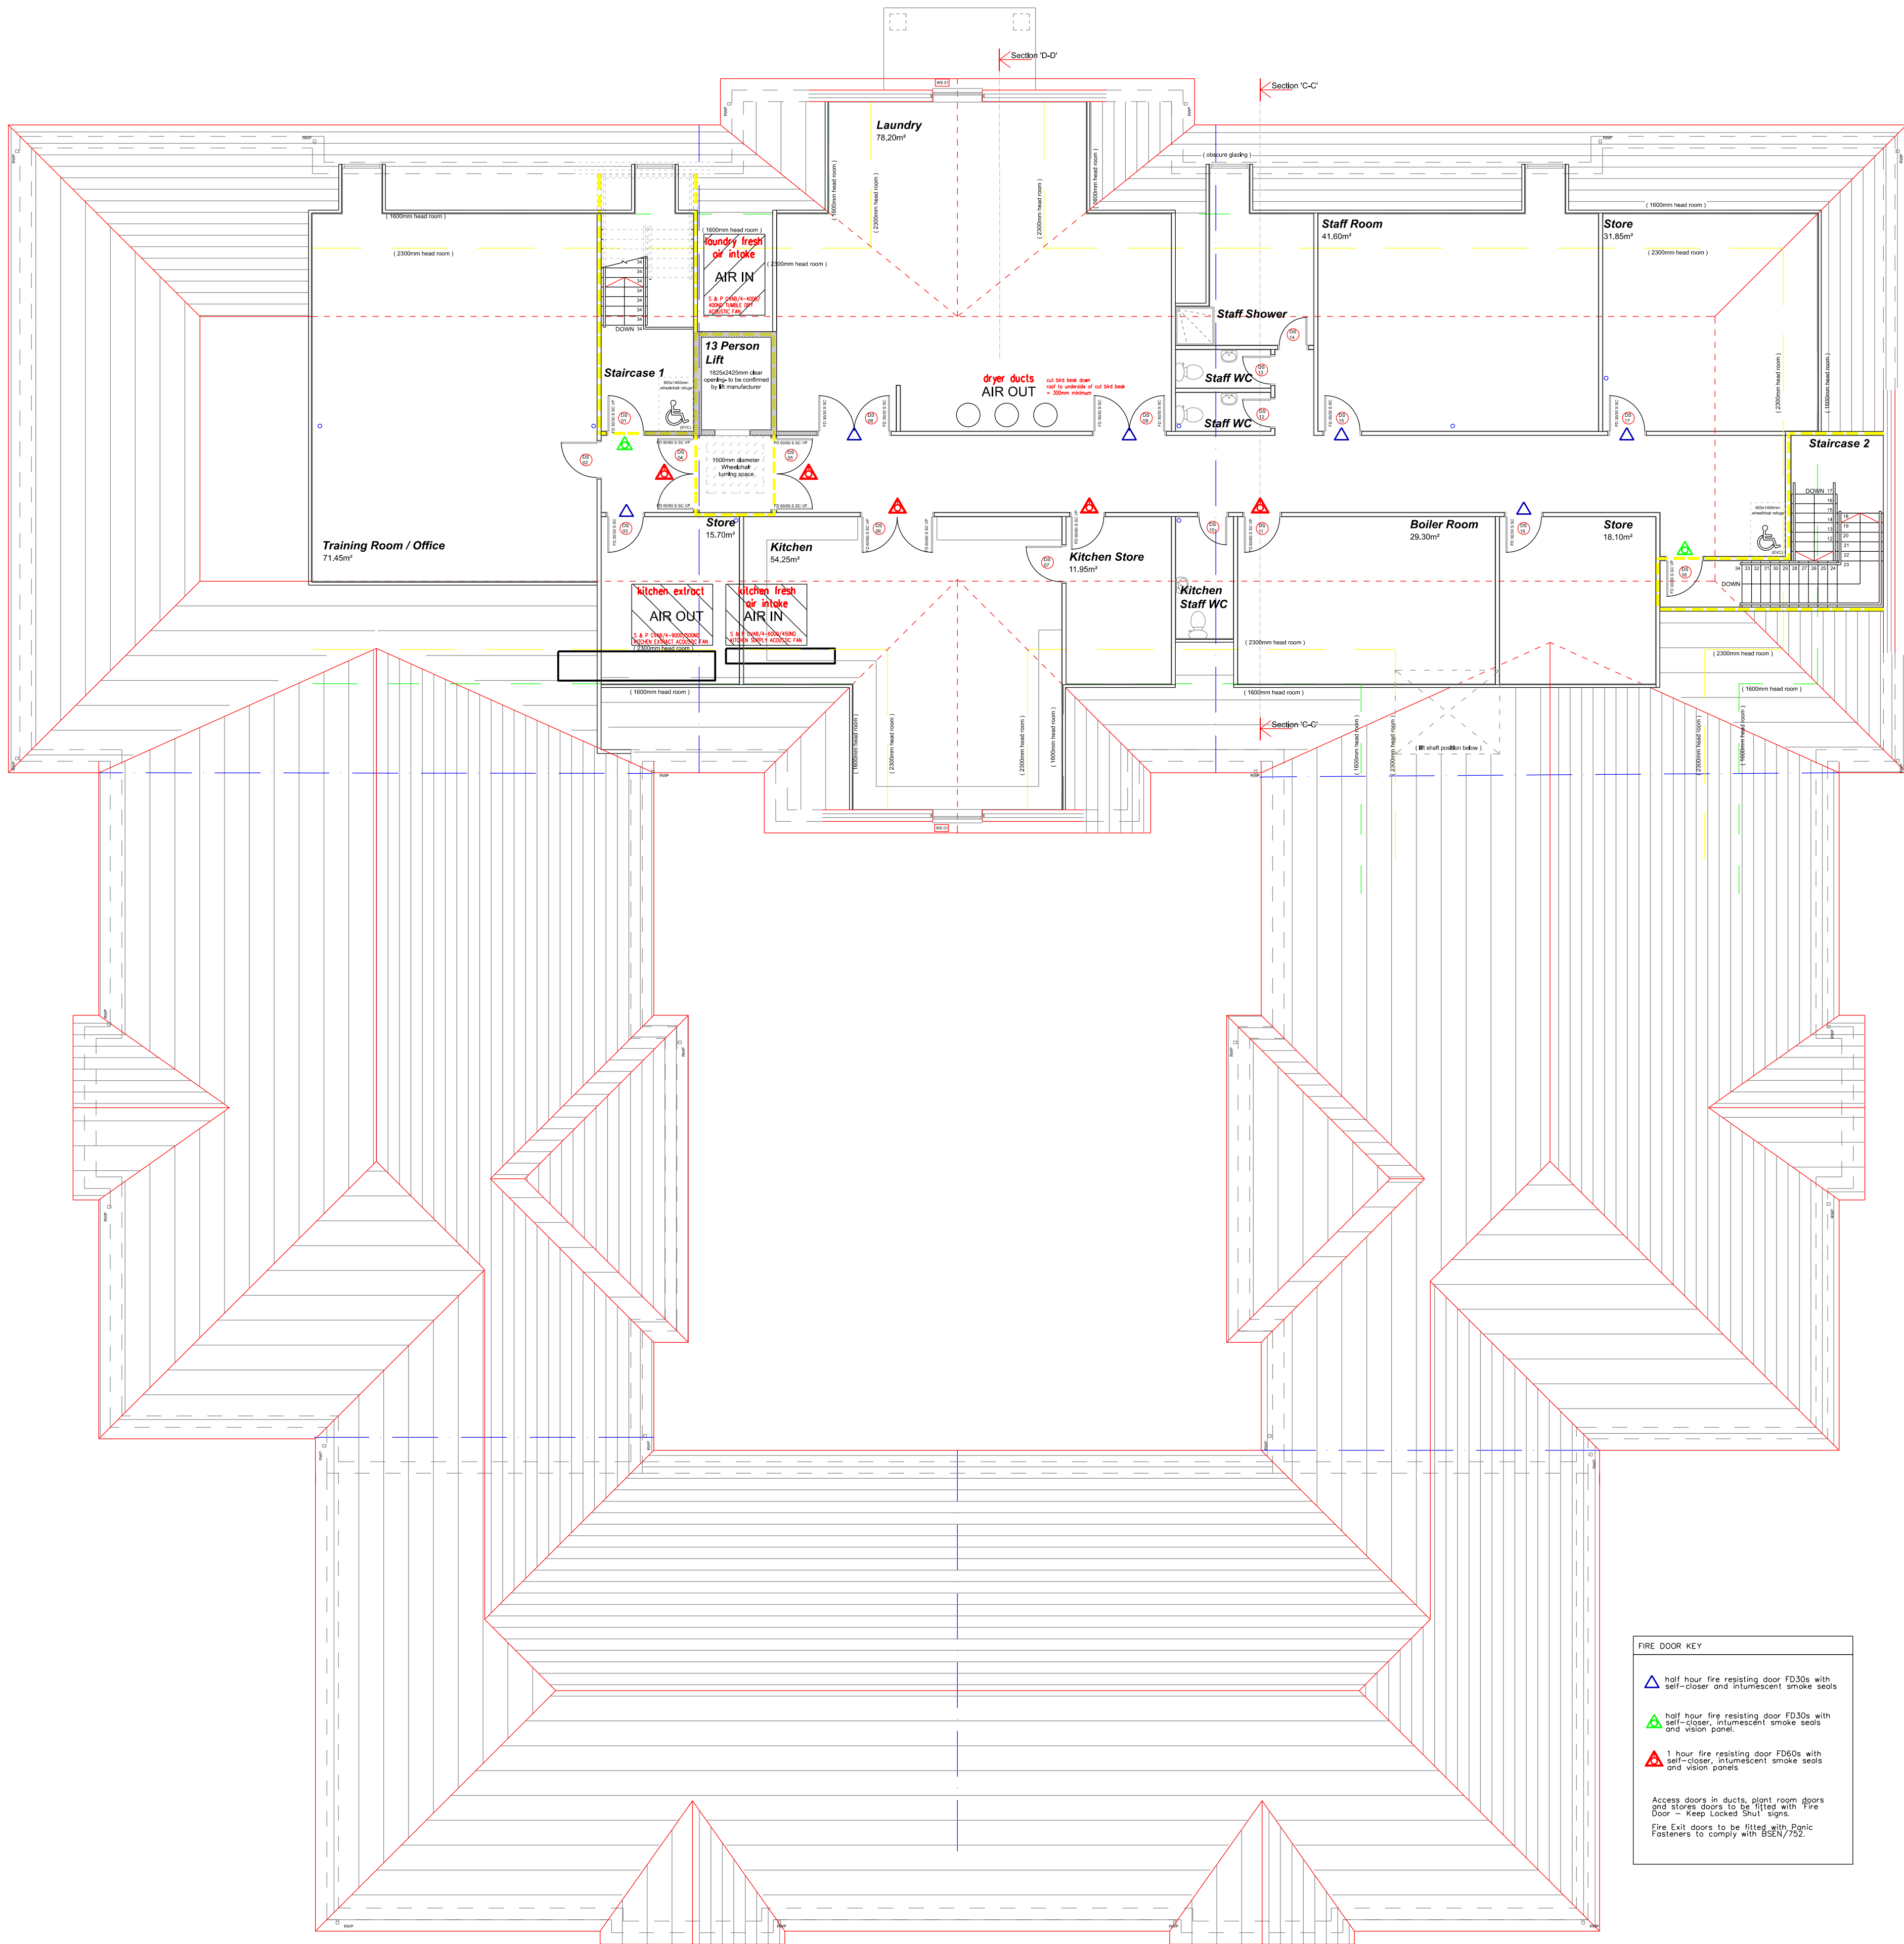


Second Floor

AS BUILT SECOND FLOOR PLAN

REVISION DATE / DESCRIPTION

- REVISION 'A' 08/05/19
- DUCTS ADDED IN LAUNDRY
AND KITCHEN
- REVISION 'B' 28/05/19
- RESTING OF FOOTPRINT
- REVISION 'C' 31/10/19
- ANNOTATION ADDED

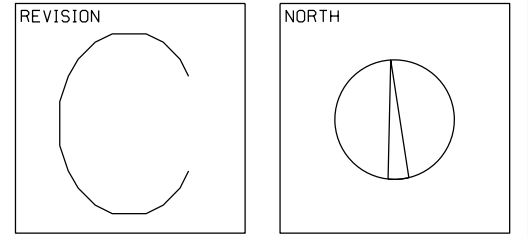

STAGE: AS BUILT

PROJECT
WALBERTON PLACE CARE HOME
YAPTON LANE
WALBERTON
ARUNDEL
WEST SUSSEX
BN15 0AS

DRAWING
SECOND FLOOR PLAN

PROJECT NO.	DRAWING NO.	REVISION
3112	L-03	C
DATE	SCALES	DRAWN BY
APR '19	1:100@A1	

MARIO MINCHELLA ARCHITECTS

UNIT 4, WITNEY WAY,
HI-TECH VILLAGE,
BOLDON BUSINESS PARK
TYNE AND WEAR
NE35 9PE
T: 0191 3802227
E: www@m-m-a.net
W: www.m-m-a.net
E: info@m-m-a.net

M M
A

THIS DRAWING IS
COPYRIGHT OF
MMA

NOT TO BE SCALED
ALL DIMENSIONS TO
BE CHECKED ON SITE