


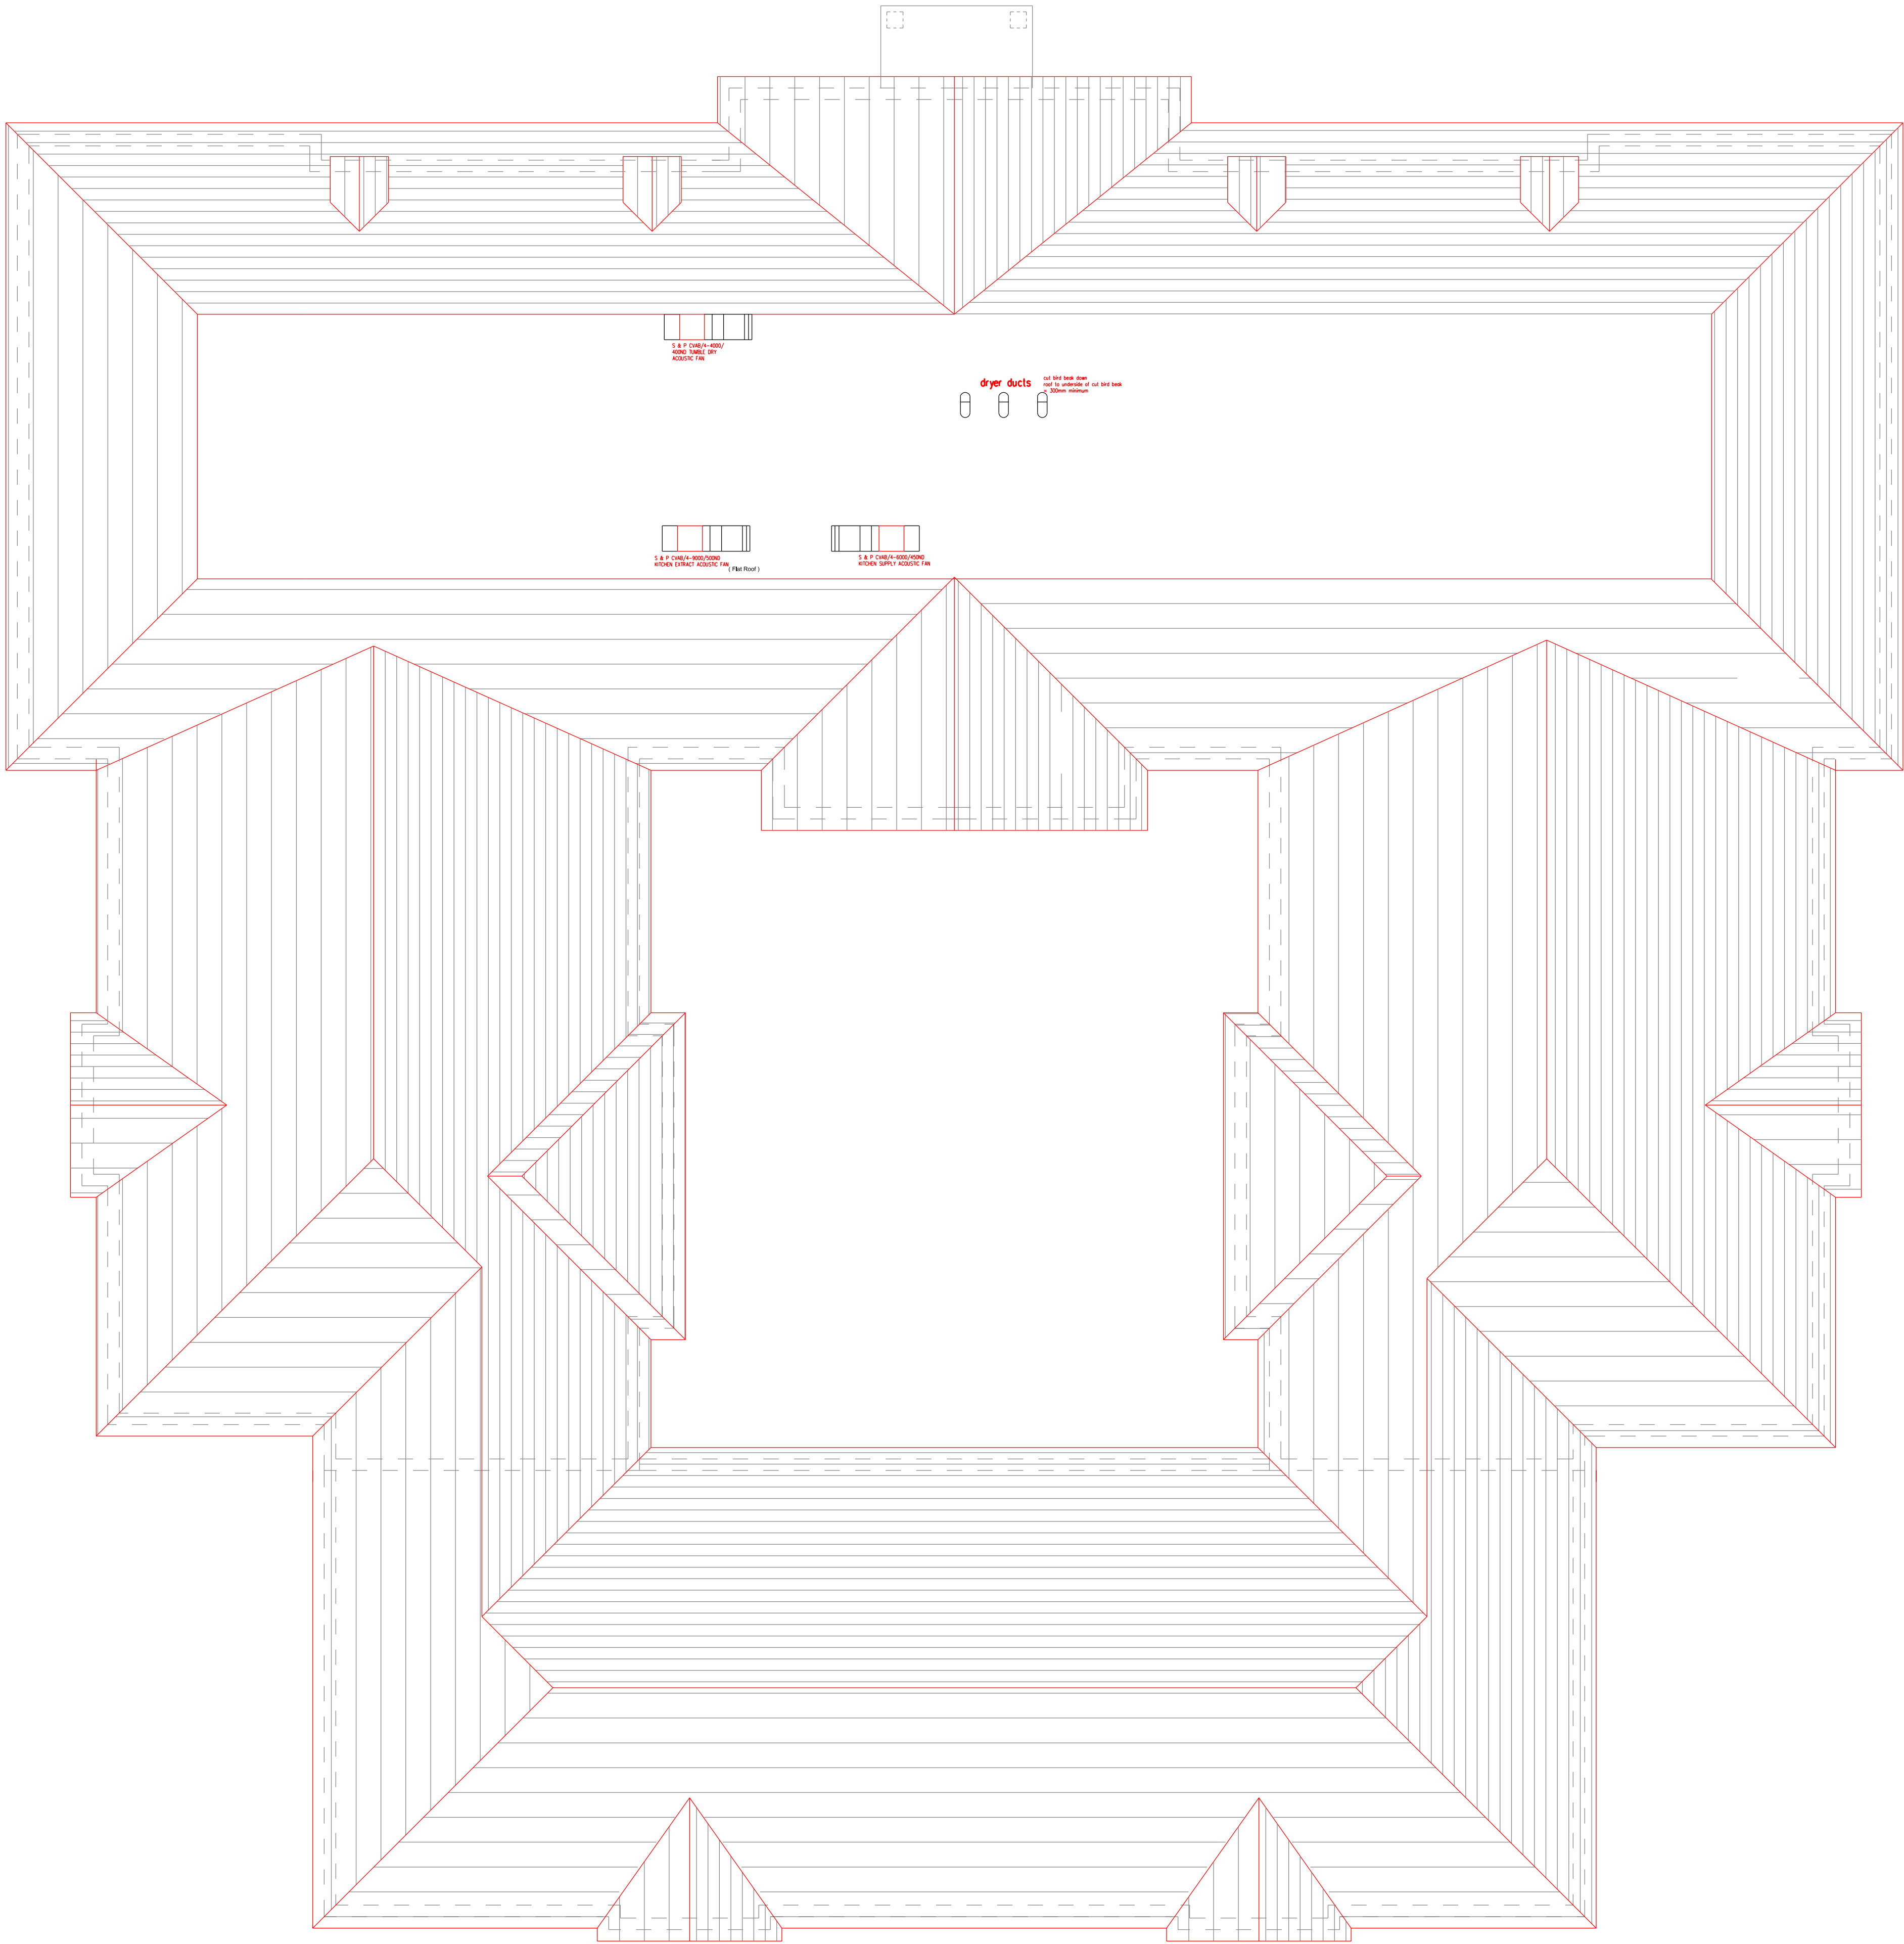

Roof Plan

AS BUILT ROOF PLAN

REVISION DATE / DESCRIPTION
REVISION 'A' 31/10/19
1) ANNOTATION ADDED

REVISION
A

NORTH

STAGE: AS BUILT

PROJECT
WALBERTON PLACE CARE HOME
YAPTON LANE
WALBERTON
ARUNDEL
WEST SUSSEX
BN15 0AS

DRAWING
ROOF PLAN

PROJECT NO. 3112	DRAWING NO. L-11	REVISION A
DATE APR '19	SCALES 1:100@A1	DRAWN BY

MARIO MINCHELLA ARCHITECTS

UNIT 4, WITNEY WAY,
HI-TECH VILLAGE,
BOLDON BUSINESS PARK
TYNE AND WEAR
NE35 9PE
T: 0191 3802227
E: info@m-m-a.net
W: www.m-m-a.net

THIS DRAWING IS
COPYRIGHT OF
MMA

NOT TO BE SCALED
ALL DIMENSIONS TO
BE CHECKED ON SITE