


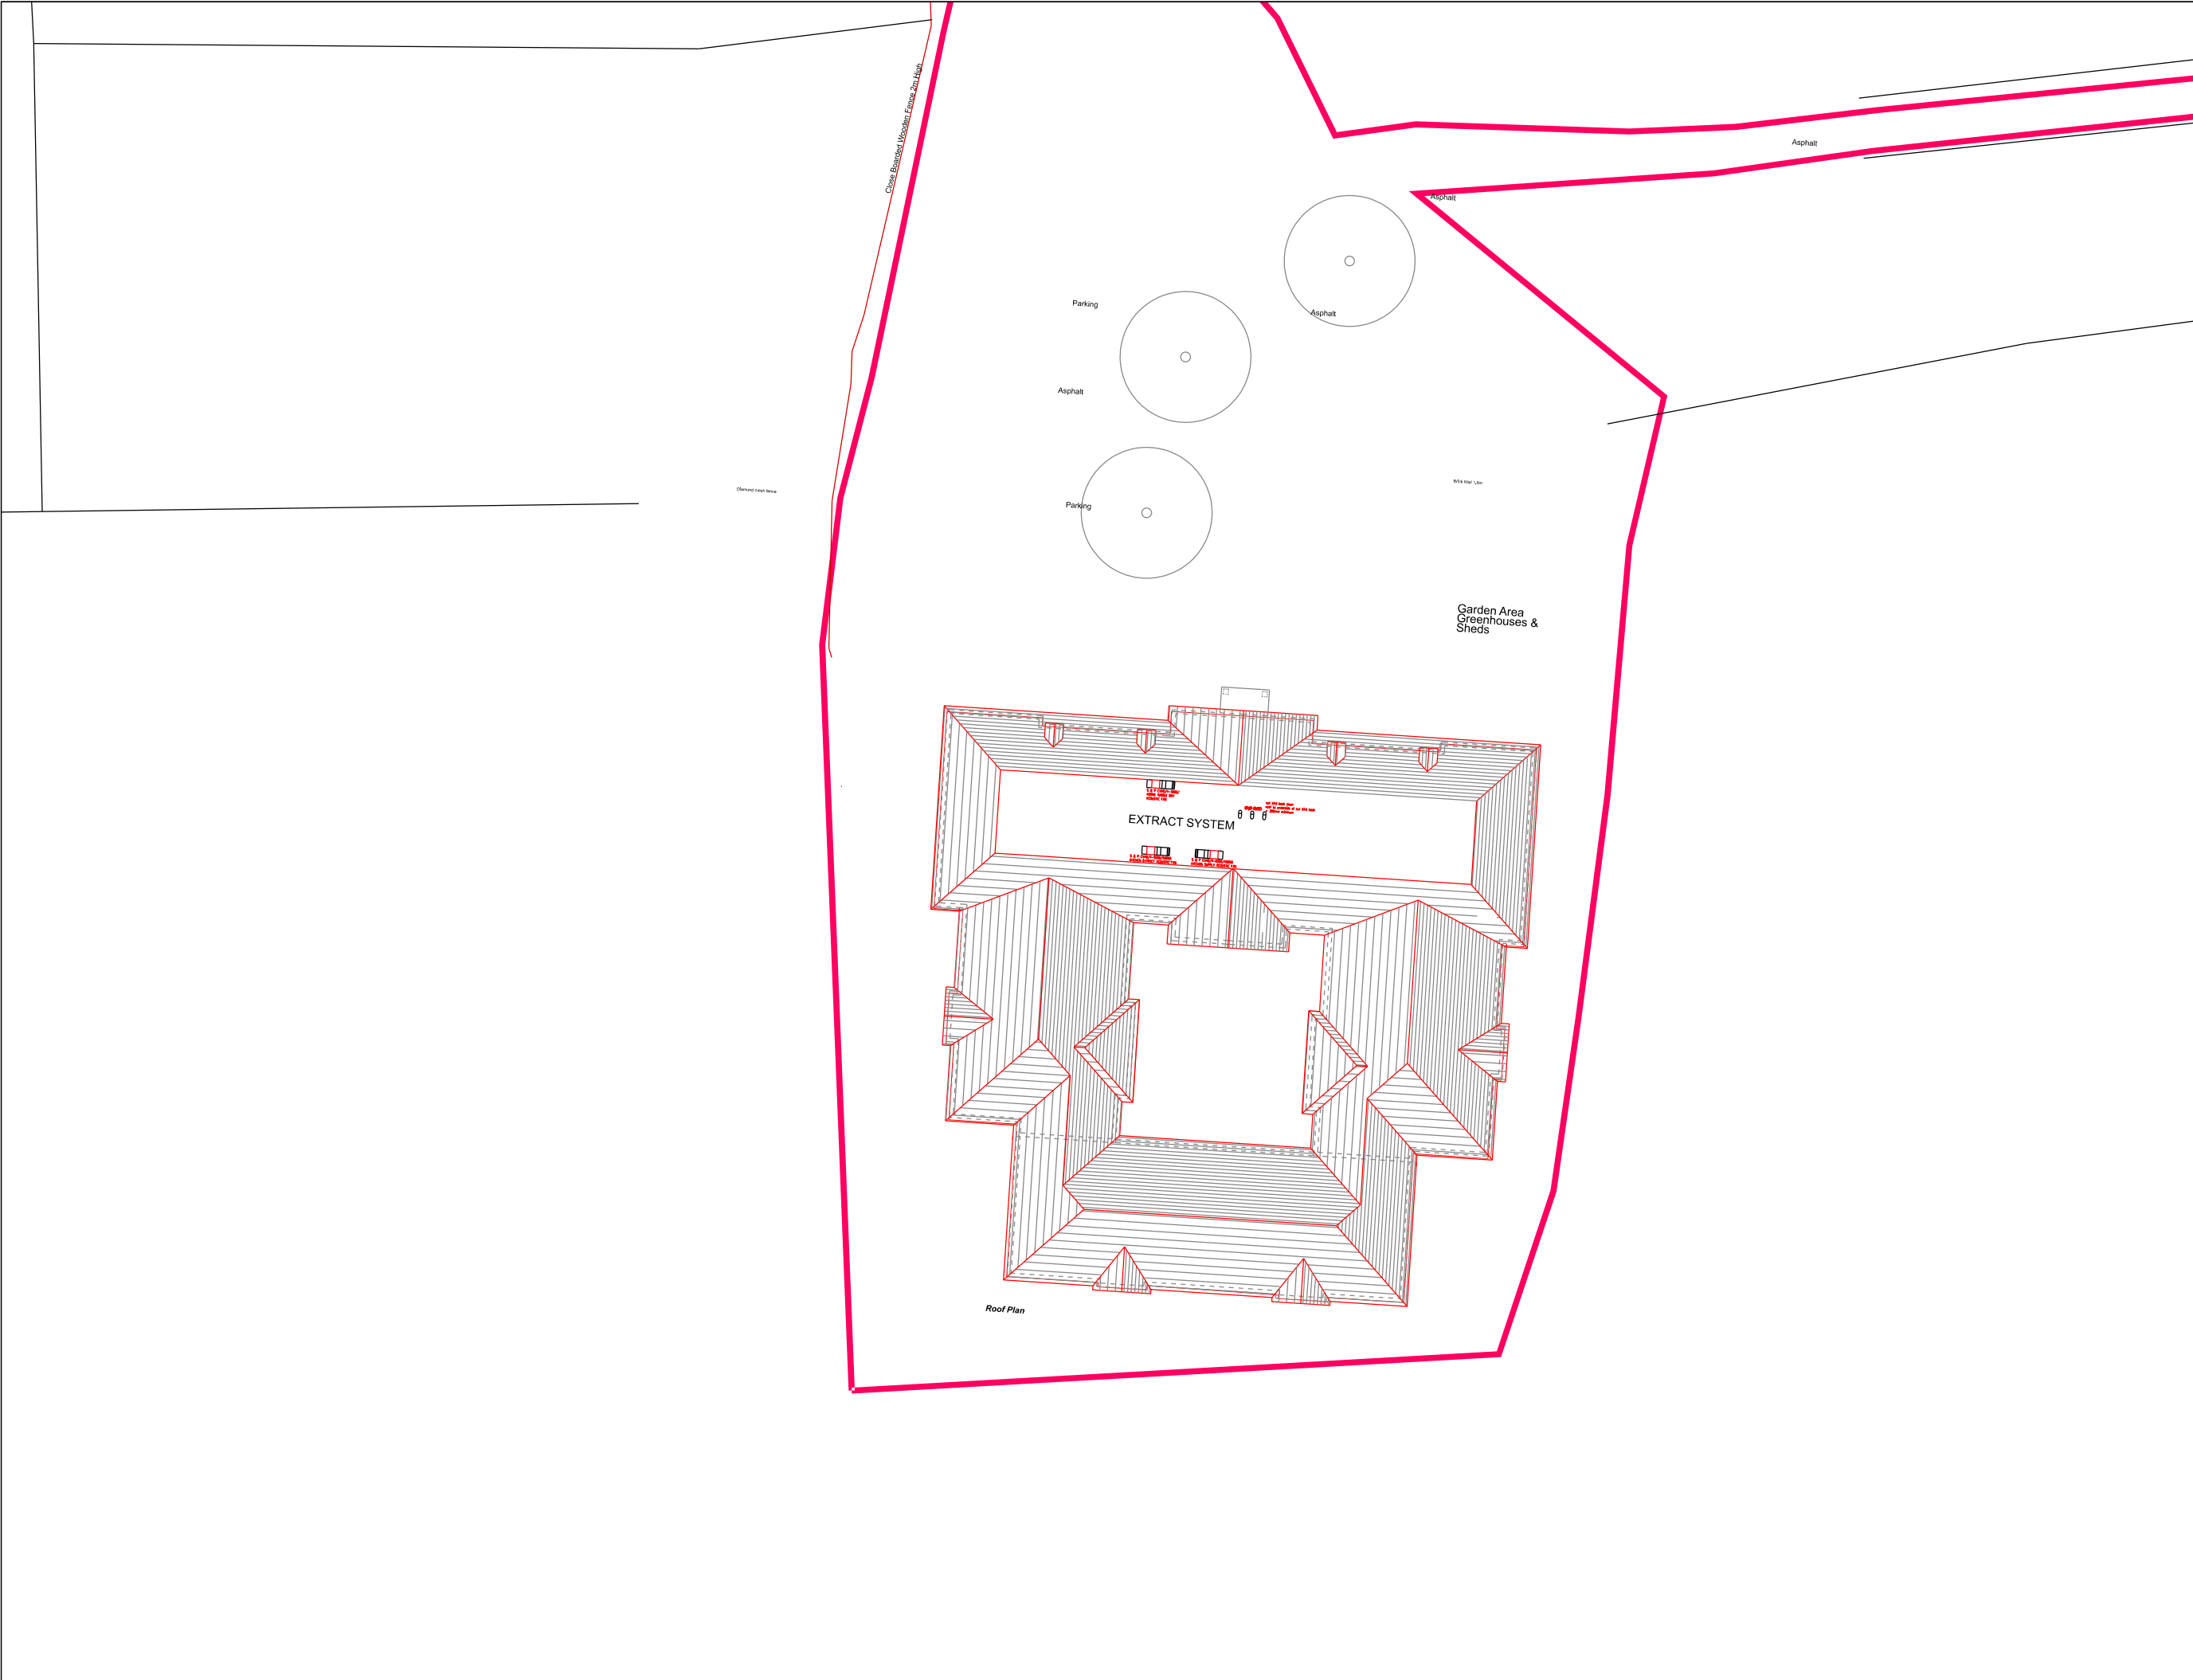

REVISION DATE / DESCRIPTION

REVISION 'A' 01/07/19
- ROOF PLAN WITH EXTRACTION
SYSTEM ADDED

REVISION 'B' 31/10/19
- ANNOTATION ADDED

REVISION

B

NORTH

STAGE:

AS BUILT

PROJECT

WALBERTON PLACE
CARE HOME
YAPTON LANE
WALBERTON
ARUNDEL

DRAWING

SITE PLAN

PROJECT NO.

3112

DRAWING NO.

L-00

REVISION

B

DATE

APR 19

SCALE

1:500@A3

DRAWN BY

BAS

MARIO MINCHELLA ARCHITECTS

UNIT 4, WITNEY WAY,
HI-TECH VILLAGE,
BOLDON BUSINESS PARK
TINE AND WEAR
NEAR WYE
T: 0191 3882227
W: www.minchella-architects.co.uk
E: info@minchella-architects.co.uk

M

M

A

THIS DRAWING IS
COPYRIGHT OF
MMA

NOT TO BE SCALED
ALL DIMENSIONS TO
BE CHECKED ON SITE