

EVOLVE RPS (LIMITED) SURVEY RETURN
(STAMP OF APPROVAL)

SURVEYORS STATEMENT


THIS SURVEY DRAWING HAS BEEN COMPLETED BY **ANDY FINCH**, USING THE DIMENSIONS I HAVE RECORDED FROM SITE. THIS SURVEYING PROJECT HAS BEEN CLASSED AS A MAJOR TYPE SURVEY AND THEREFORE I HAVE TAKEN FULL SITE DIMENSIONS IN ORDER TO PRODUCE THE RECORD SURVEY PROVIDED. LIMITED ACCESS WAS MADE AVAILABLE TO INSPECT CONCEALED AREAS AND THEREFORE A FULLY INTRUSIVE SURVEY SHOULD BE ARRANGED IF ADDITIONAL INFORMATION IS REQUIRED.

ANDY FINCH

REVIT MODELLERS STATEMENT


THIS REVIT MODEL HAS BEEN COMPLETED BY GREG BIERNACKI, USING THE SURVEY INFORMATION PROVIDED BY **ANDY FINCH**. I CAN CONFIRM THAT I RECEIVED ALL INFORMATION REQUIRED IN ORDER TO PRODUCE THIS MODEL AND THAT THE MODEL I HAVE PRODUCED IS AN ACCURATE REPRESENTATION OF THE BUILDING.

GREG BIERNACKI - 01-06-2017

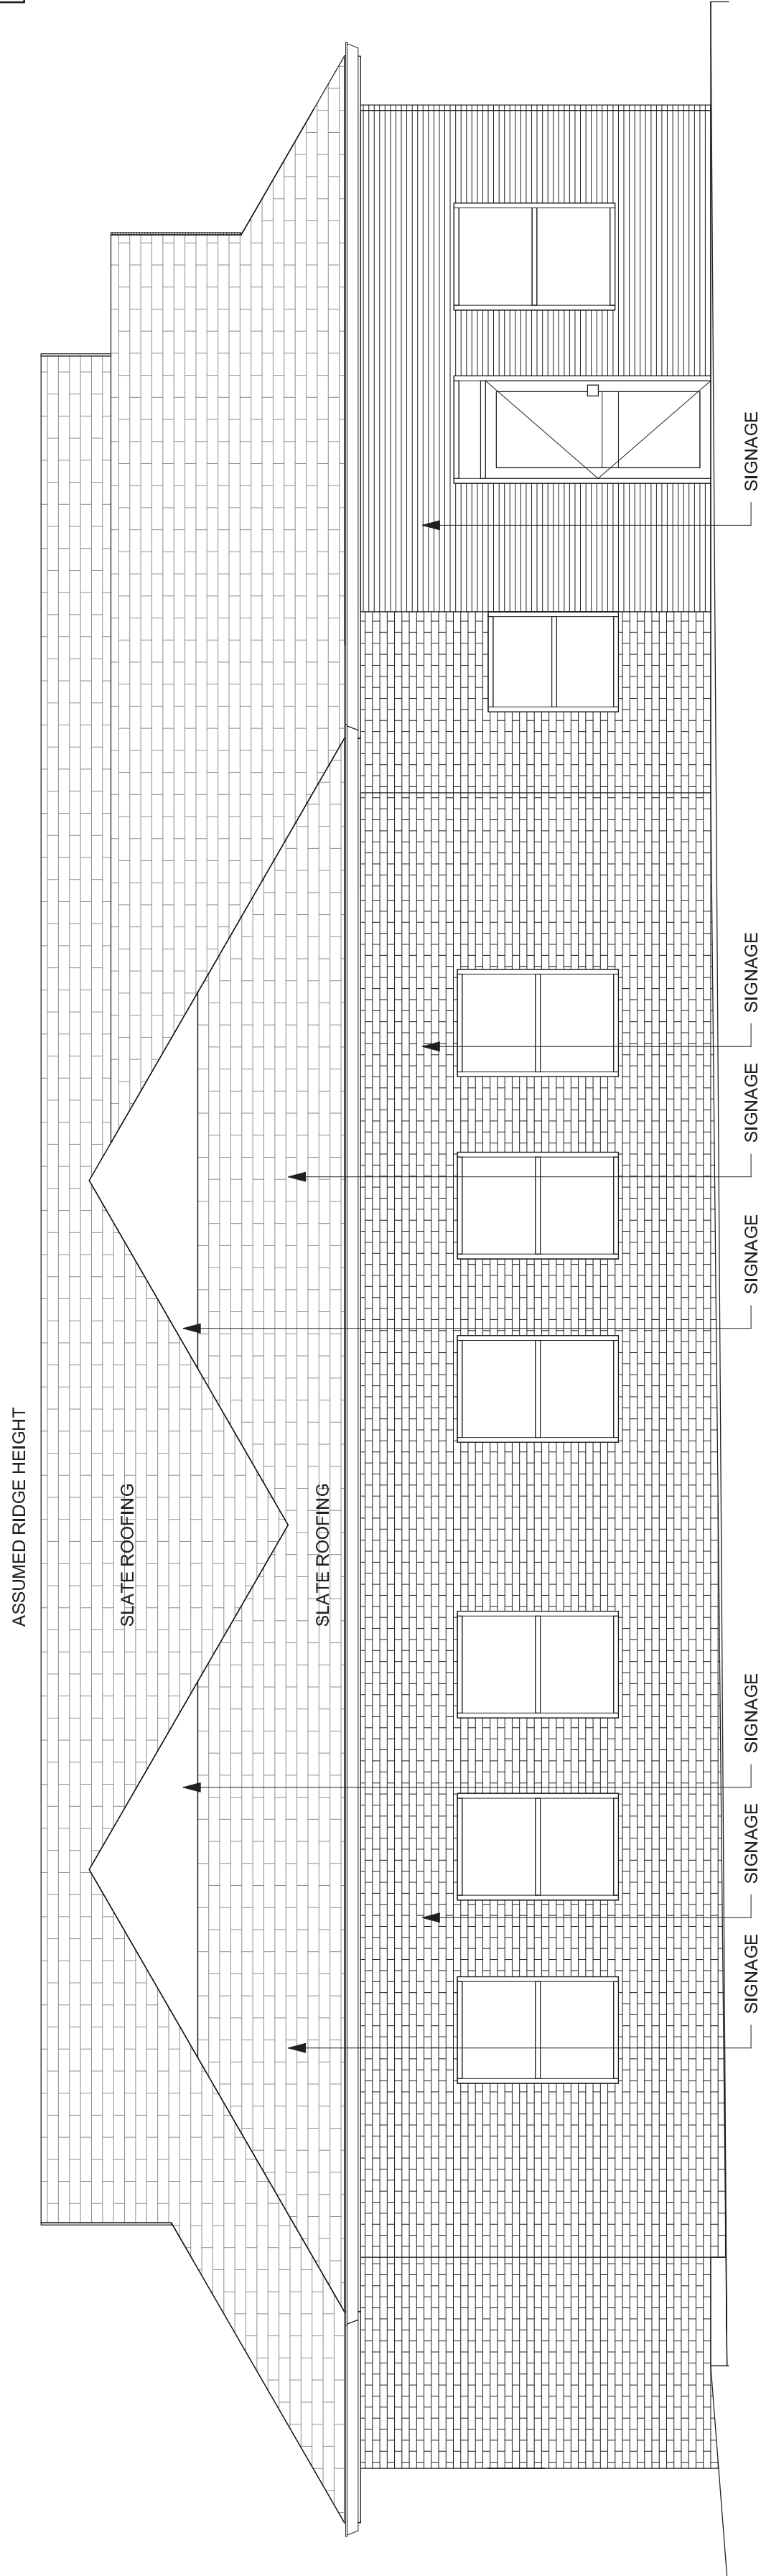

ELEVATION A


Scale: 1 : 50

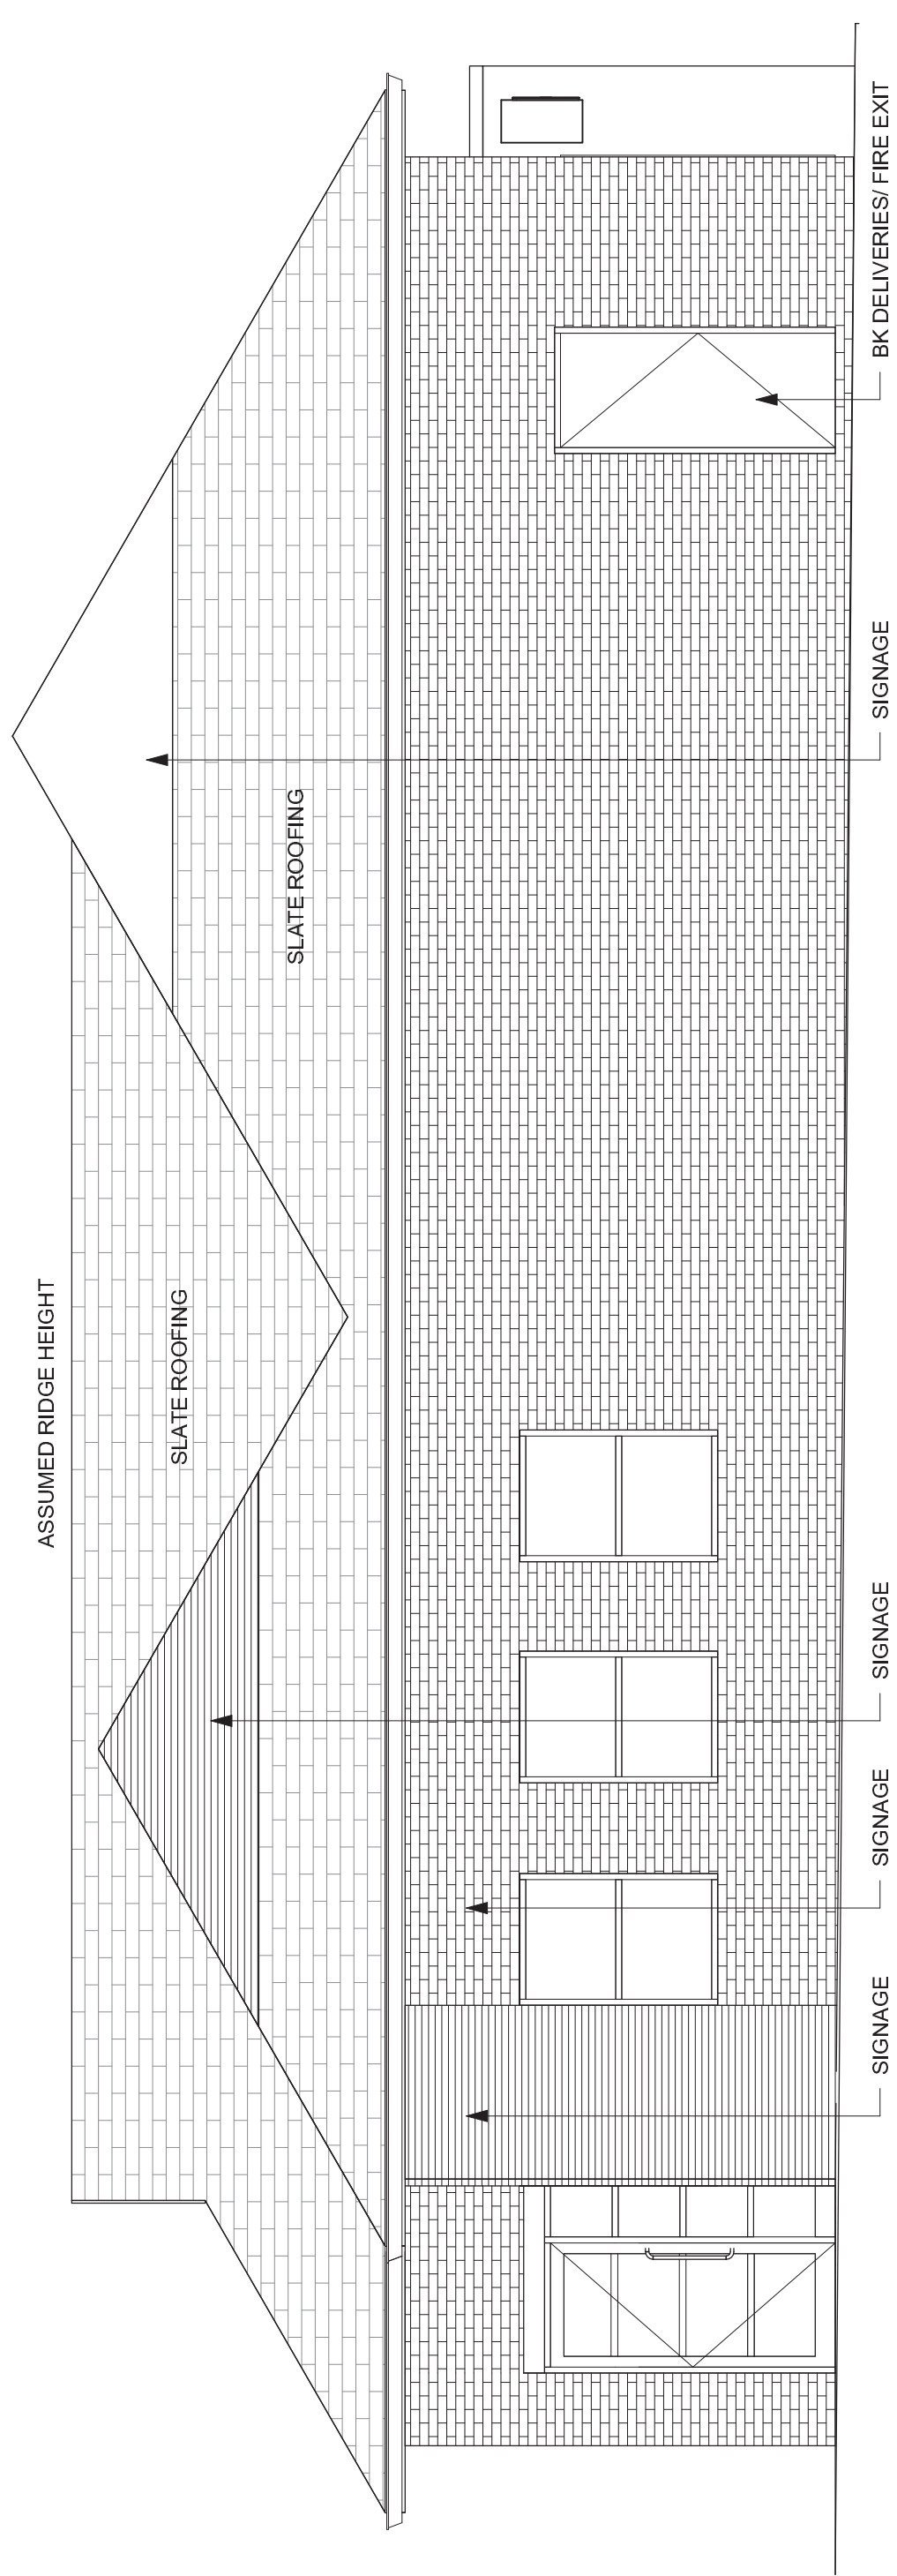

B ELEVATION B
Scale: 1:50



Scale 1: 50 @ A1 (1: 100 @ A3)

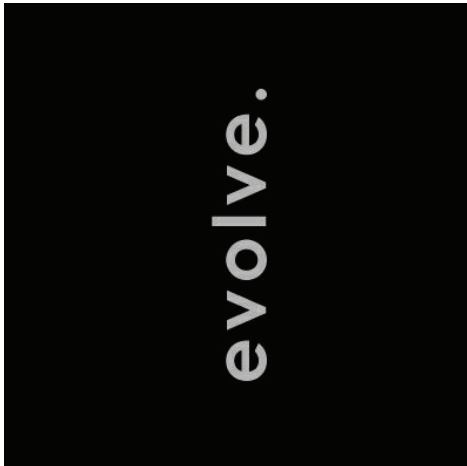

DESIGN DEVELOPMENT ONLY - NOT INTENDED FOR CONSTRUCTION

EVOLVE ARCHITECTURE

The Coach House
Grange Business Park
Hewish Bristol
BS24 6RR

ARCHITECT OF RECORD

THIS DRAWING IS A DESIGN DEVELOPMENT DOCUMENT. SITE SPECIFIC MODIFICATIONS MADE UNDER THE RESPONSIBLE CHARGE OF THE ARCHITECT AND/OR ENGINEER-OF-RECORD WILL BE REQUIRED PRIOR TO USING THIS DOCUMENT FOR BIDDING, PERMITTING, OR CONSTRUCTION.

[illegible]

PROJECT NAME: Fontwell

PROJECT ADDRESS: Little Chef, Fontwell

BN18 0SB

STORE #: tbc
PROJECT #: tbc
CONCEPT:
PALETTE:
ISSUE DATE:
DESIGN MANAGER:
LEED® AP:
PRODUCTION DESIGNER:
CHECKED BY:

SHEET TITLE:
**EXISTING EXTERIOR
ELEVATIONS**
AS SHOWN

SCALE:

SHEET NUMBER:
SU-6001