

MAJOR SURVEY STAMP

EVOLVE RPS (LIMITED) SURVEY RETURN
(STAMP OF APPROVAL)

SURVEYORS STATEMENT


THIS SURVEY DRAWING HAS BEEN COMPLETED BY **ANDY FINCH**. USING THE DIMENSIONS I HAVE RECORDED FROM SITE, THIS SURVEYING PROJECT HAS BEEN COMPLETED TO THE BEST OF MY KNOWLEDGE AND BELIEF. I HAVE NOT RECEIVED ANY INFORMATION FROM THE ARCHITECT OR ENGINEER THAT WOULD CAUSE ME TO BELIEVE THAT THE DIMENSIONS IN ORDER TO PRODUCE THE RECORD SURVEY PROVIDED LIMITED ACCESS WAS MADE AVAILABLE TO INSPECT CONCEALED AREAS AND THEREFORE A FULLY INTRUSIVE SURVEY SHOULD BE ARRANGED IF ADDITIONAL INFORMATION IS REQUIRED.

ANDY FINCH


REVIT MODELLERS STATEMENT

THIS REVIT MODEL HAS BEEN COMPLETED BY GREG BIERNACKI. USING THE SURVEY INFORMATION PROVIDED BY **ANDY FINCH**, I CAN CONFIRM THAT I RECEIVED ALL INFORMATION REQUIRED IN ORDER TO PRODUCE THIS MODEL AND THAT THE MODEL I HAVE PRODUCED IS AN ACCURATE REPRESENTATION OF THE BUILDING.


GREG BIERNACKI - 01-06-2017

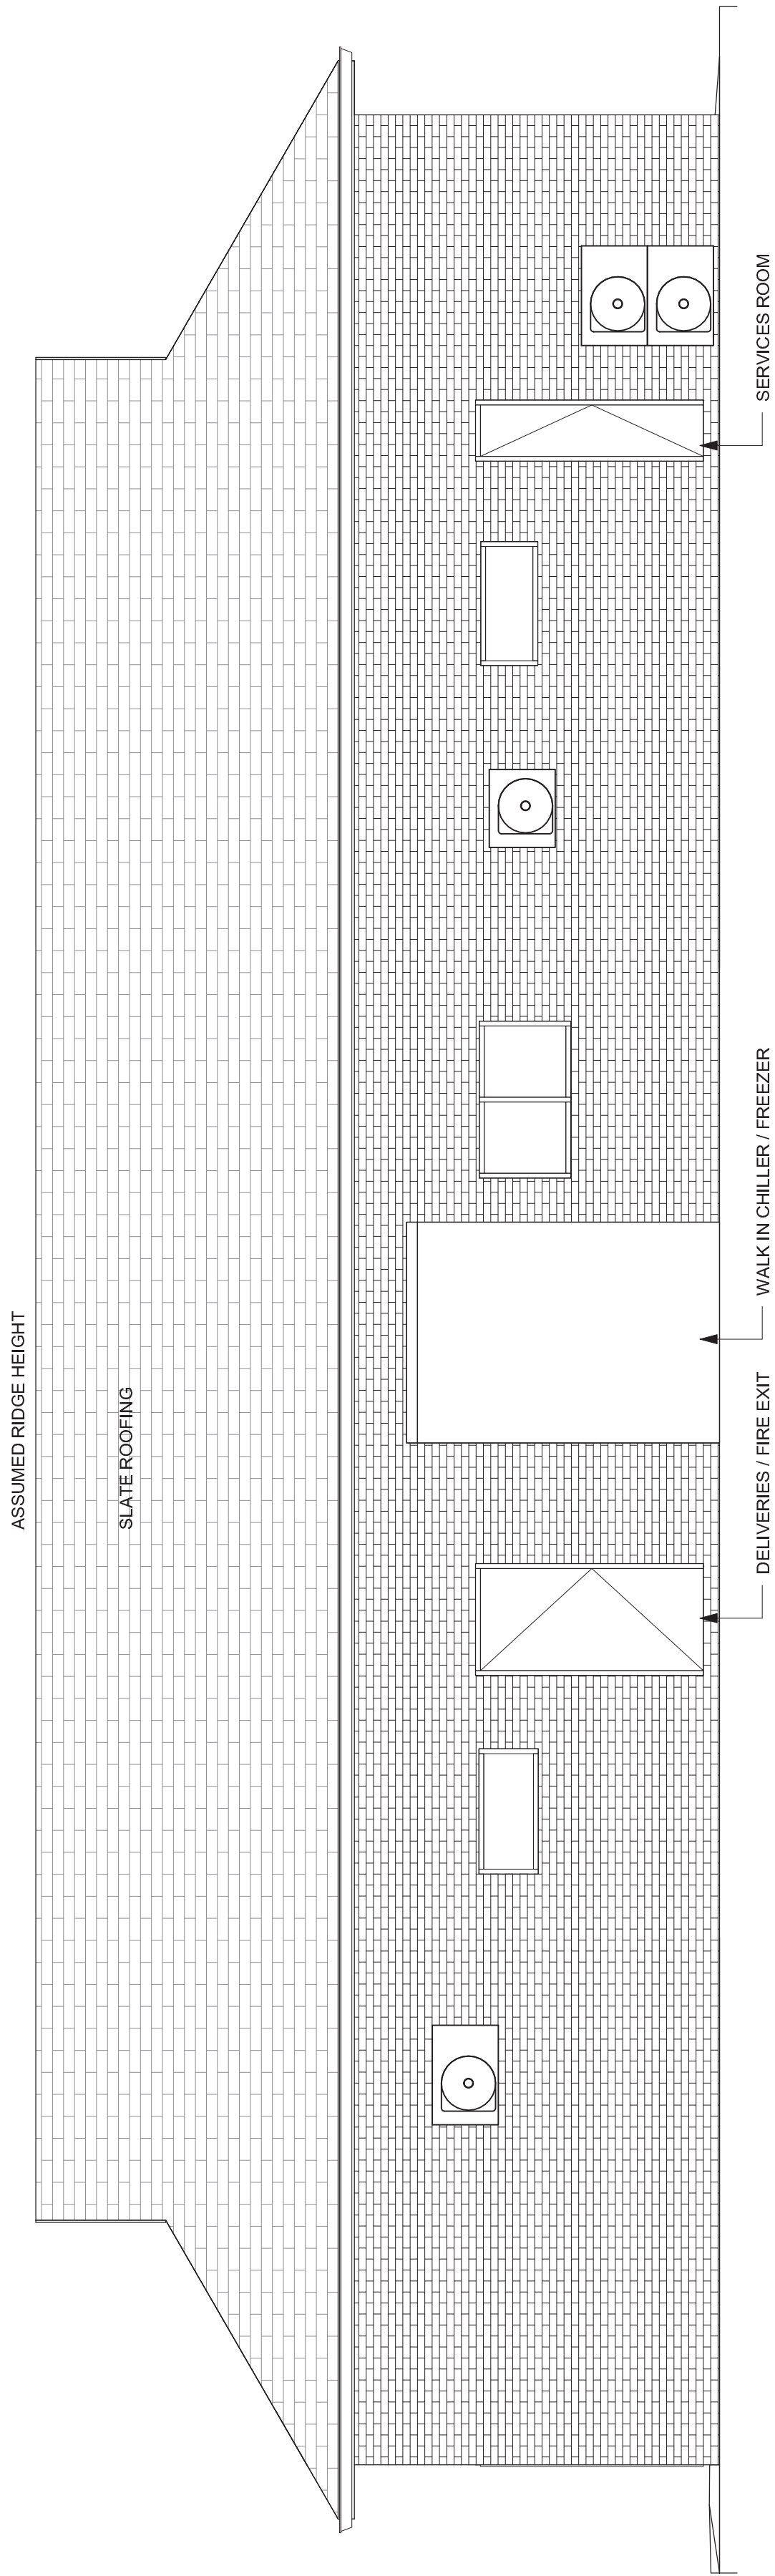

1 ELEVATION C
Scale: 1 : 50

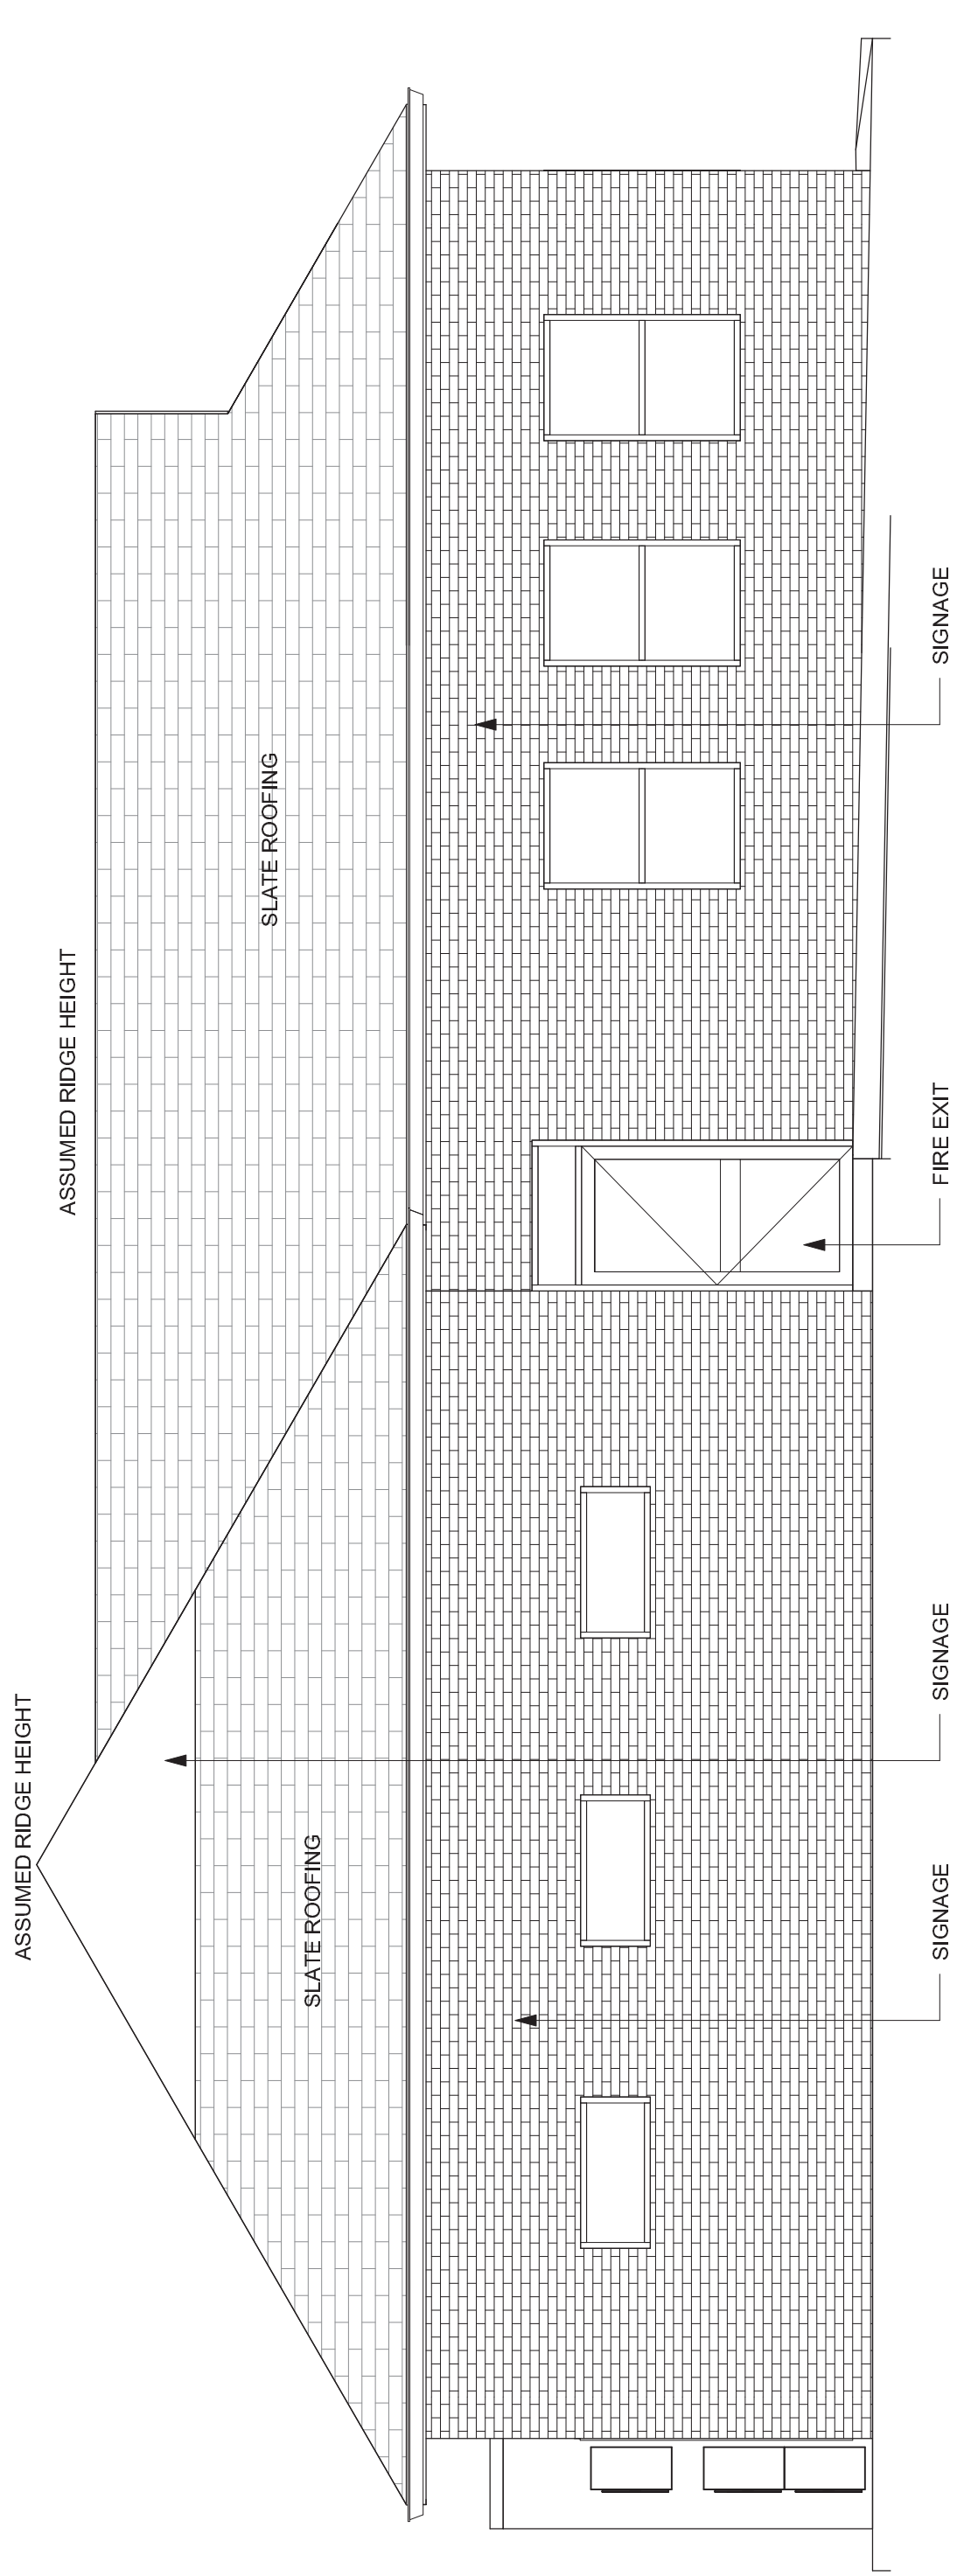

2 ELEVATION D
Scale: 1 : 50

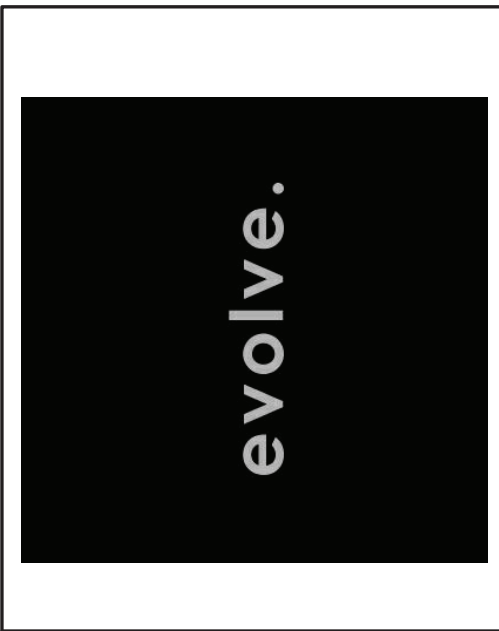

EVOLVE ARCHITECTURE
The Coach House
Gange Business Park
Hewish Bristol
BS24 6RR

ARCHITECT OF RECORD
THIS DRAWING IS A DESIGN DEVELOPMENT DOCUMENT. SITE SPECIFIC MODIFICATIONS MADE UNDER THE RESPONSIBLE CHARGE OF THE ARCHITECT AND/OR ENGINEER OR RECORDING OF THE BUILDING USING THIS DOCUMENT FOR BIDDING, PERMITTING, OR CONSTRUCTION.

Revision Schedule	
Rev	Description

Fontwell
PROJECT NAME:
PROJECT ADDRESS:
Little Chef, Fontwell
BN18 0SB

STORE #: tbc
PROJECT #: tbc
CONCEPT:
PALETTE:
ISSUE DATE:
DESIGN MANAGER:
LEED® AP:
PRODUCTION DESIGNER:
CHECKED BY:

SHEET TITLE:
EXISTING EXTERIOR ELEVATIONS
SCALE:
AS SHOWN

SHEET NUMBER:
SU-6002

DESIGN DEVELOPMENT ONLY - NOT INTENDED FOR CONSTRUCTION