


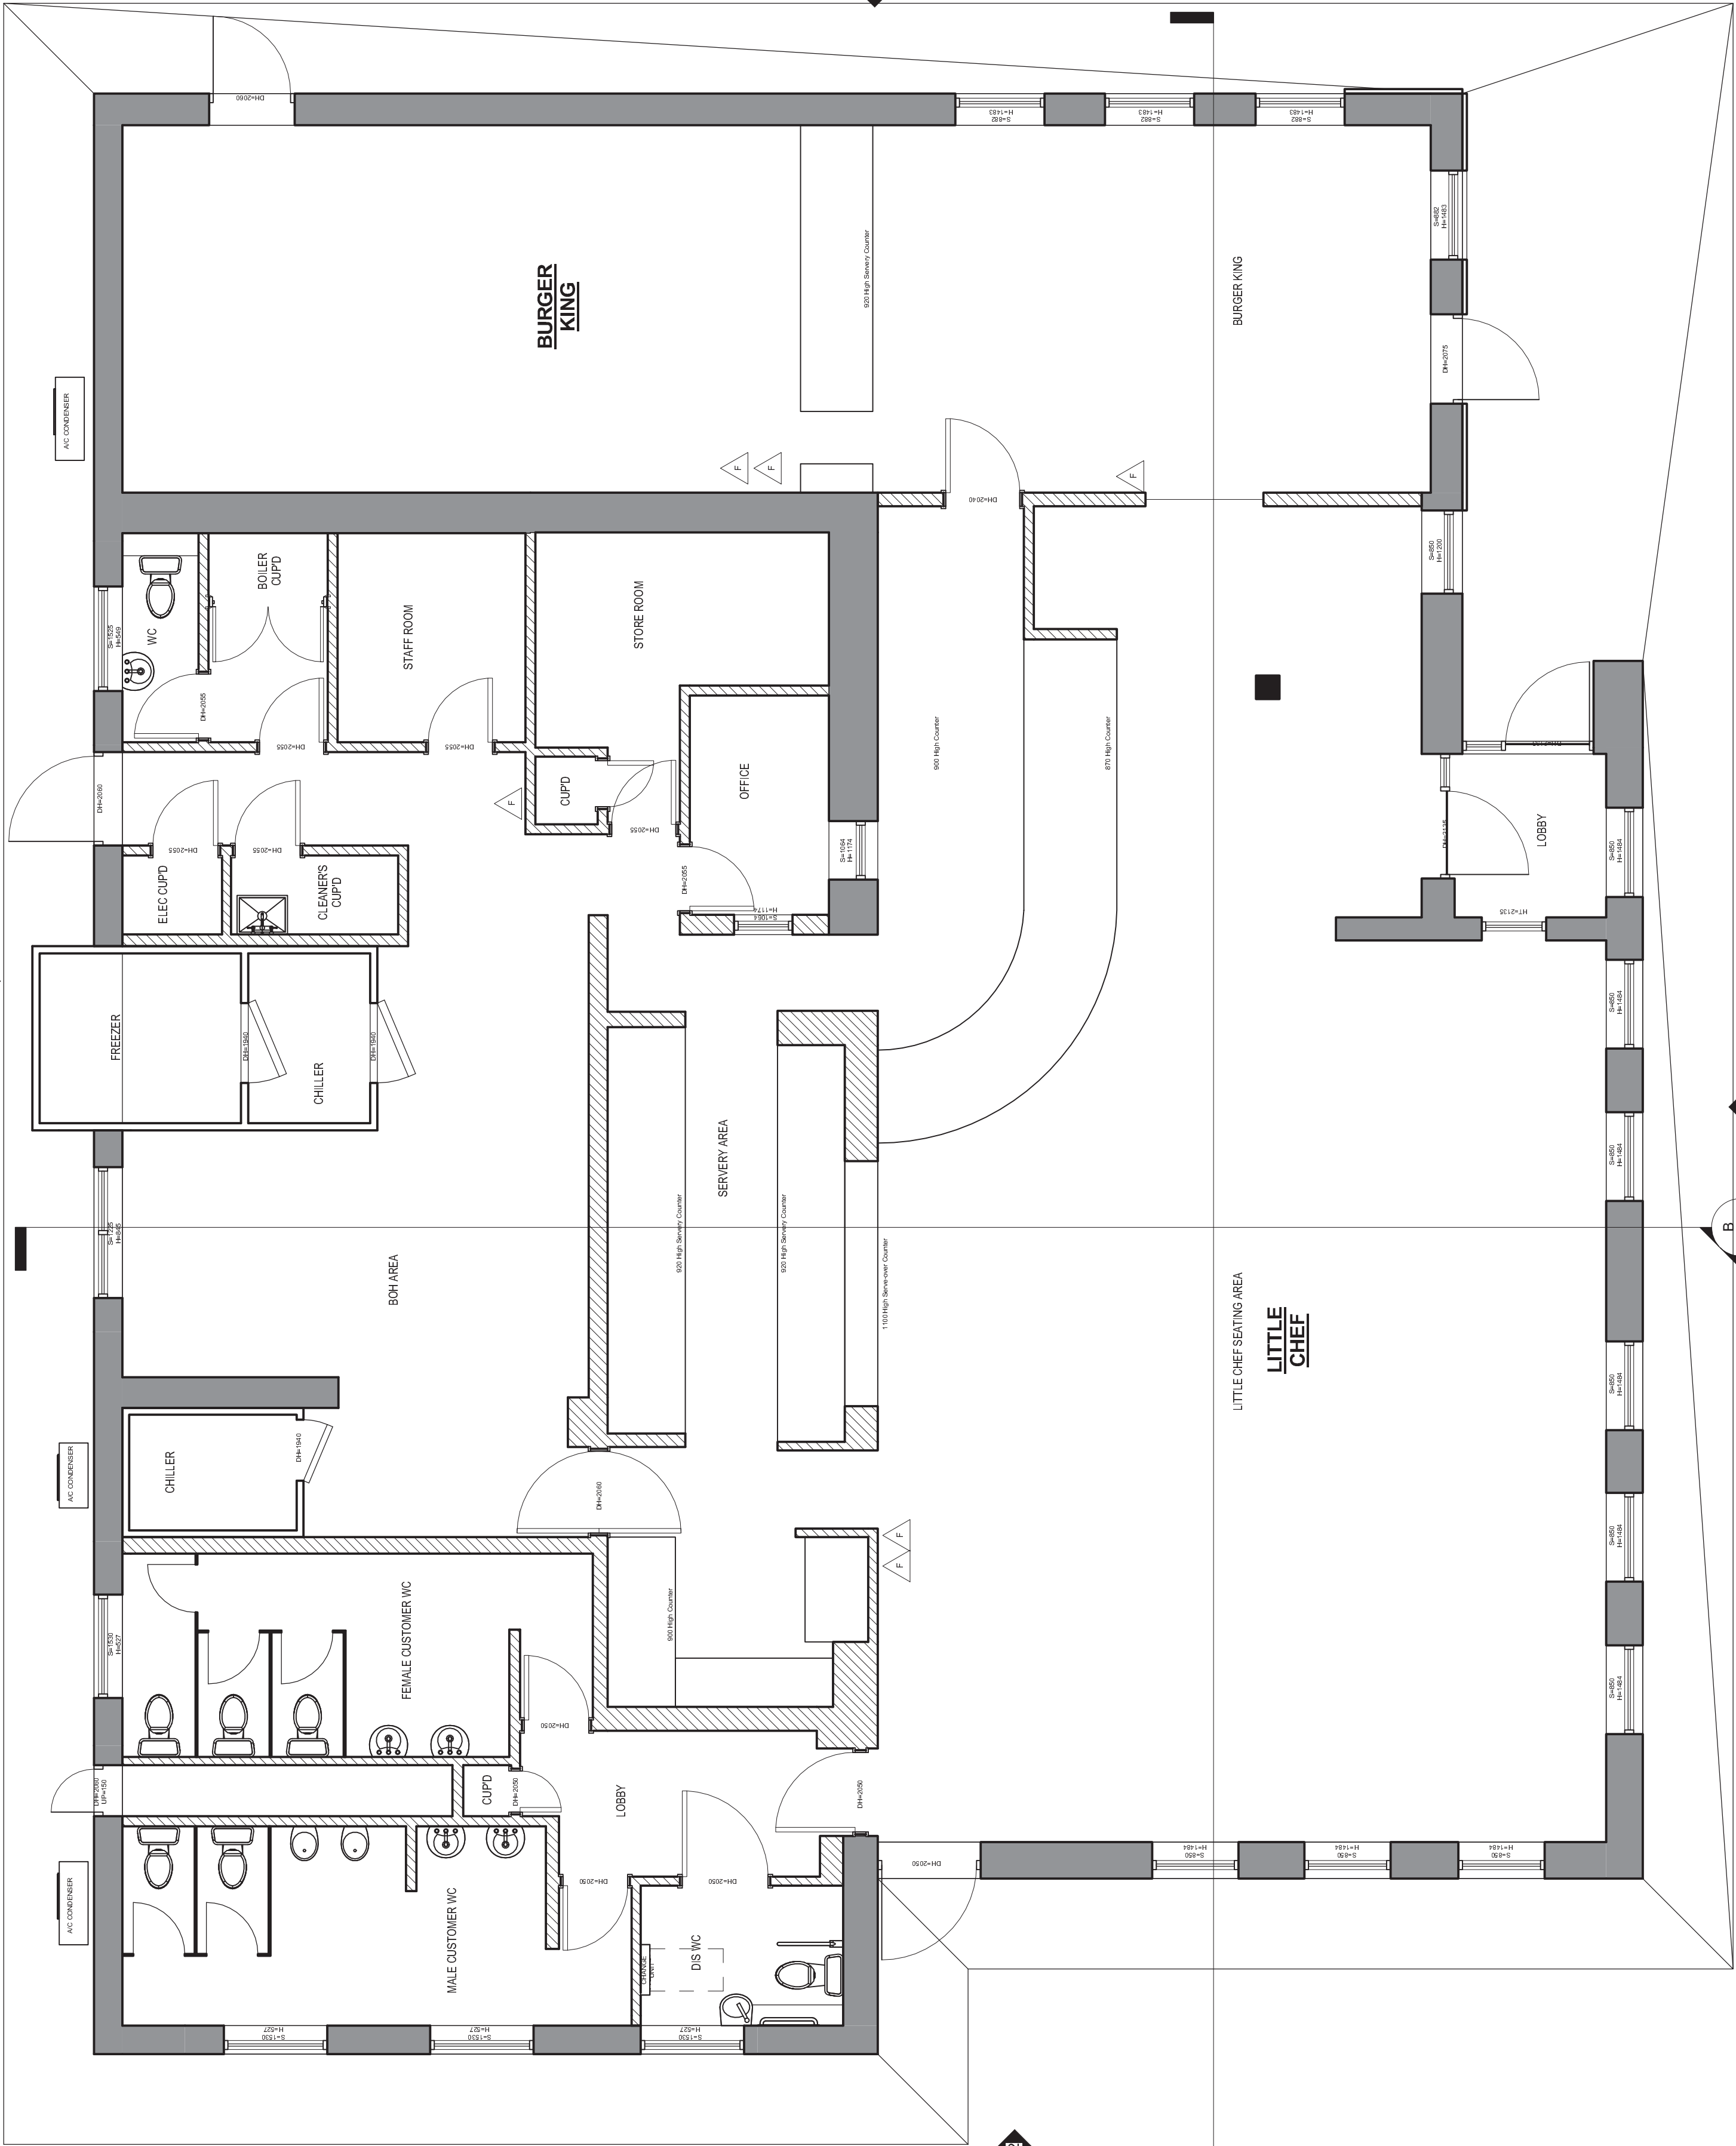

Scale: 1 : 50

Scale: 1:50

MAJOR SURVEY STAMP

EVOLVE RPS (LIMITED) SURVEY RETURN
(STAMP OF APPROVAL)

SURVEYORS STATEMENT

THIS SURVEY DRAWING HAS BEEN COMPLETED BY **ANDY FINCH**, USING THE DIMENSIONS I HAVE RECORDED FROM SITE. THIS SURVEYING PROJECT HAS BEEN CLASSED AS A MAJOR TYPE SURVEY AND THEREFORE I HAVE TAKEN FULL SITE DIMENSIONS IN ORDER TO PRODUCE THE RECORD SURVEY PROVIDED. LIMITED ACCESS WAS MADE AVAILABLE TO INSPECT CONCEALED AREAS AND THEREFORE A FULLY INTRUSIVE SURVEY SHOULD BE ARRANGED IF ADDITIONAL INFORMATION IS REQUIRED.

ANDY FINCH

REVIT MODELLERS STATEMENT

THIS REVIT MODEL HAS BEEN COMPLETED BY GREG BIERNACKI. USING THE SURVEY INFORMATION PROVIDED BY **ANDY FINCH**, I CAN CONFIRM THAT I RECEIVED ALL INFORMATION REQUIRED IN ORDER TO PRODUCE THIS MODEL AND THAT THE MODEL I HAVE PRODUCED IS AN ACCURATE REPRESENTATION OF THE BUILDING.

GREG BIERNACKI - 01-06-2017

SURVEY ROOM SCHEDULE - SQM		SURVEY ROOM SCHEDULE - SQFT	
NAME	AREA	NAME	AREA
BURGER KING	59 m²	BURGER KING	636 SF
LITTLE CHEF	232 m²	LITTLE CHEF	2499 SF
Grand total	291 m²	Grand total	3134 SF

FOH WALL LENGTH (FOR POSSIBLE WAINSCOT APPLICATION)	
LENGTH	DESCRIPTION

FOH WALL LENGTH (FOR POSSIBLE WAINSCOT APPLICATION)	LENGTH	DESCRIPTION
--	--------	-------------

[illegible]

ARCHITECT OF RECORD

THIS DRAWING IS A DESIGN DEVELOPMENT DOCUMENT. SITE SPECIFIC MODIFICATIONS MADE UNDER THE RESPONSIBLE CHARGE OF THE ARCHITECT AND/OR ENGINEER-OF-RECORD WILL BE REQUIRED PRIOR TO USING THIS DOCUMENT FOR BIDDING, PERMITTING, OR CONSTRUCTION.

PROJECT NAME: Fontwell

STORE #: _____
PROJECT #: _____
CONCEPT: _____
PALETTE: _____
ISSUE DATE: _____
DESIGN MANAGER: _____
LEED® AP: _____
PRODUCTION DESIGNER: _____
CHECKED BY: _____

SHEET TITLE:
EXISTING FLOOR PLAN

SCALE:
AS SHOWN

SHEET NUMBER:

SU-2001