





Key

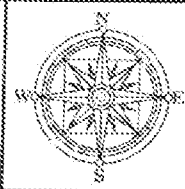

Proposed Monitoring Locations

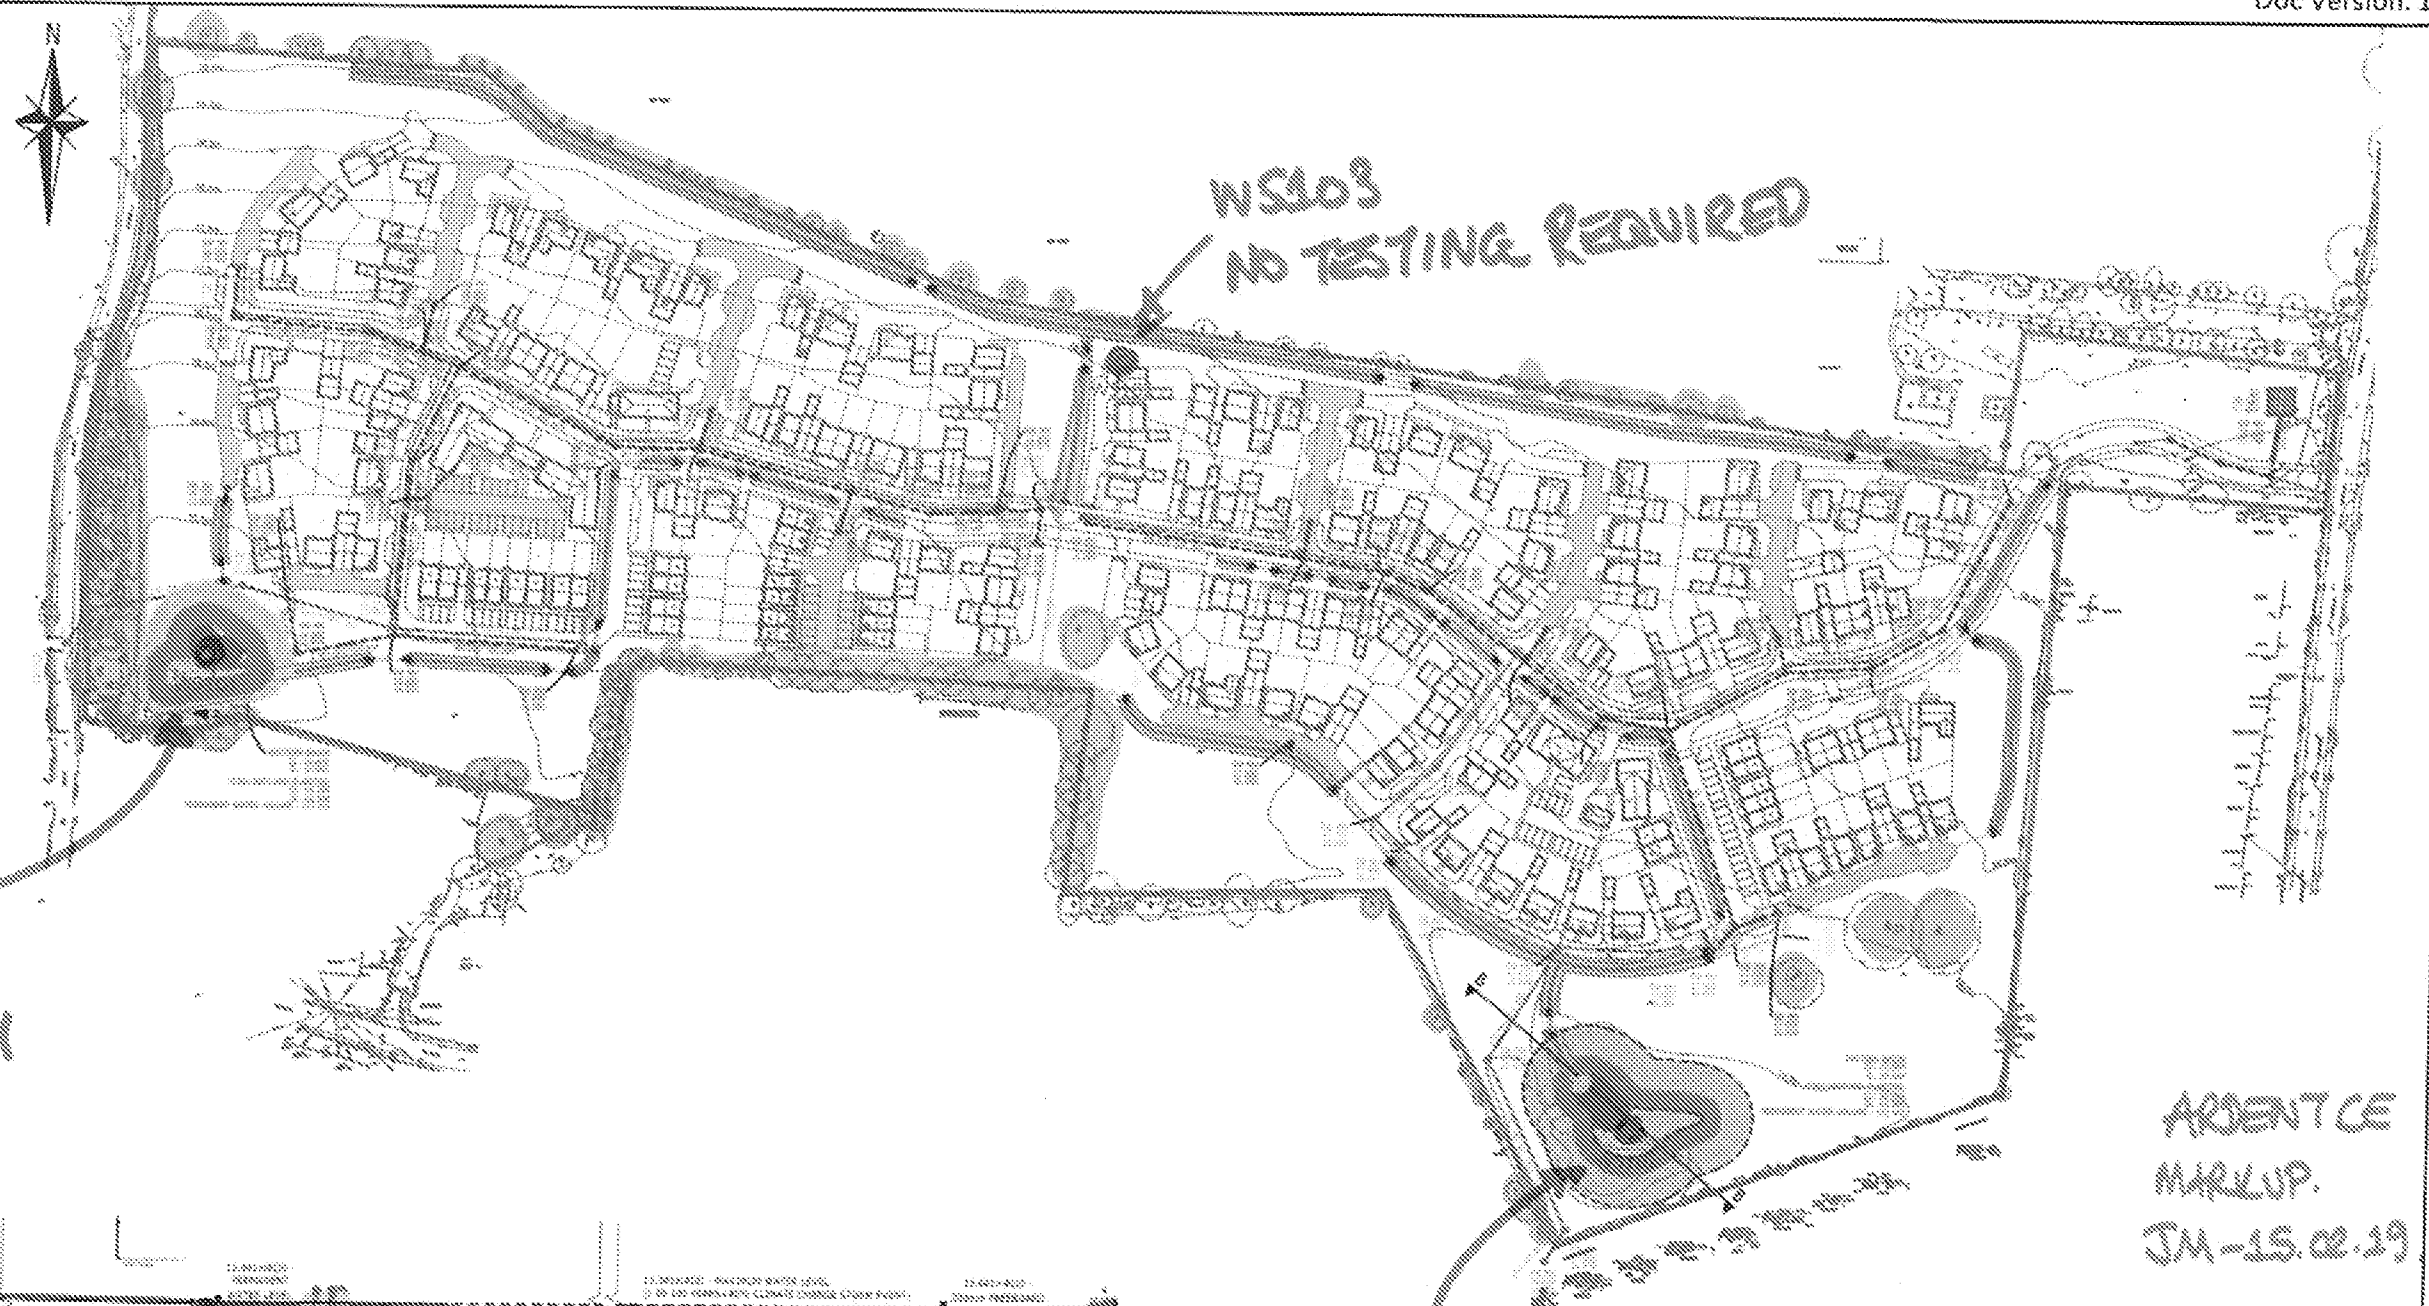

WS101.
BRE 365 TESTING
REQUIRED AT DEPTH
OF 12.01mAOD.
(APPROX 2.6m bgl)

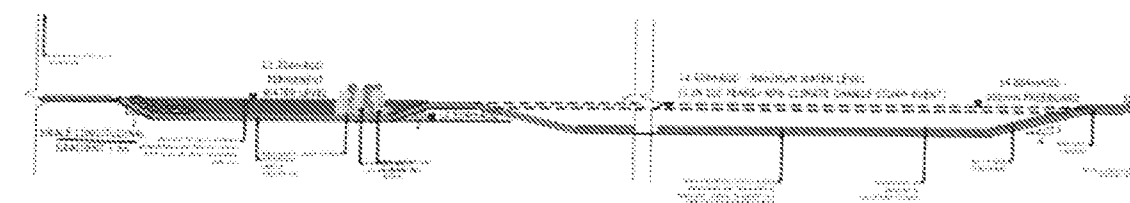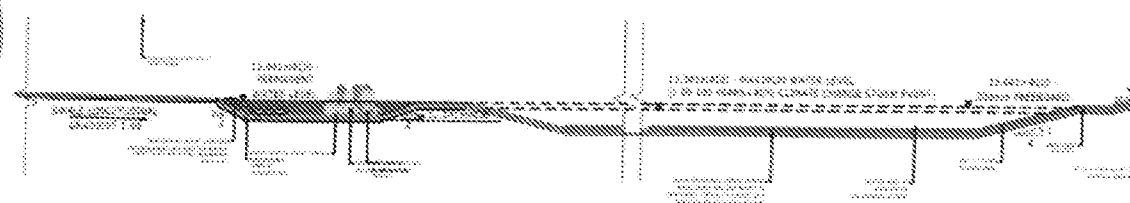

ARGENT CE
MARKUP.
JM-15.02.19

WS102.
BRE 365 TESTING REQUIRED AT
DEPTH OF 14.24mAOD.
(APPROX 2.8m bgl)

The client must not amend any drawing, design or other intellectual property produced by Omnia Environmental Consulting (OEC) without permission in writing from OEC in advance of any amendments being made. In the event that such written permission is not obtained in advance of the amendments being made OEC shall not be liable for any damage and/or losses occurring as a result of the amended drawing, design or intellectual property.

Omnia Environmental Consulting,
10 Manor Court, Barnes Wallis Road,
Seymour, Fareham,
PO15 5TH
T: 01489 808088
E: info@omnia-consulting.co.uk
W: www.omnia-consulting.co.uk



Job Title:

Walberton
Winter Groundwater Monitoring
SOLAR TESTING
LOCATION PLAN

Client:

Linden Homes (South)

Project No:

A11073

Drawn By:

A. King

Scale:

NTS

Date:

17/12/2018

Authorised By:

T. Mitchell

Notes:

Drawing Title:

Proposed Monitoring Locations