
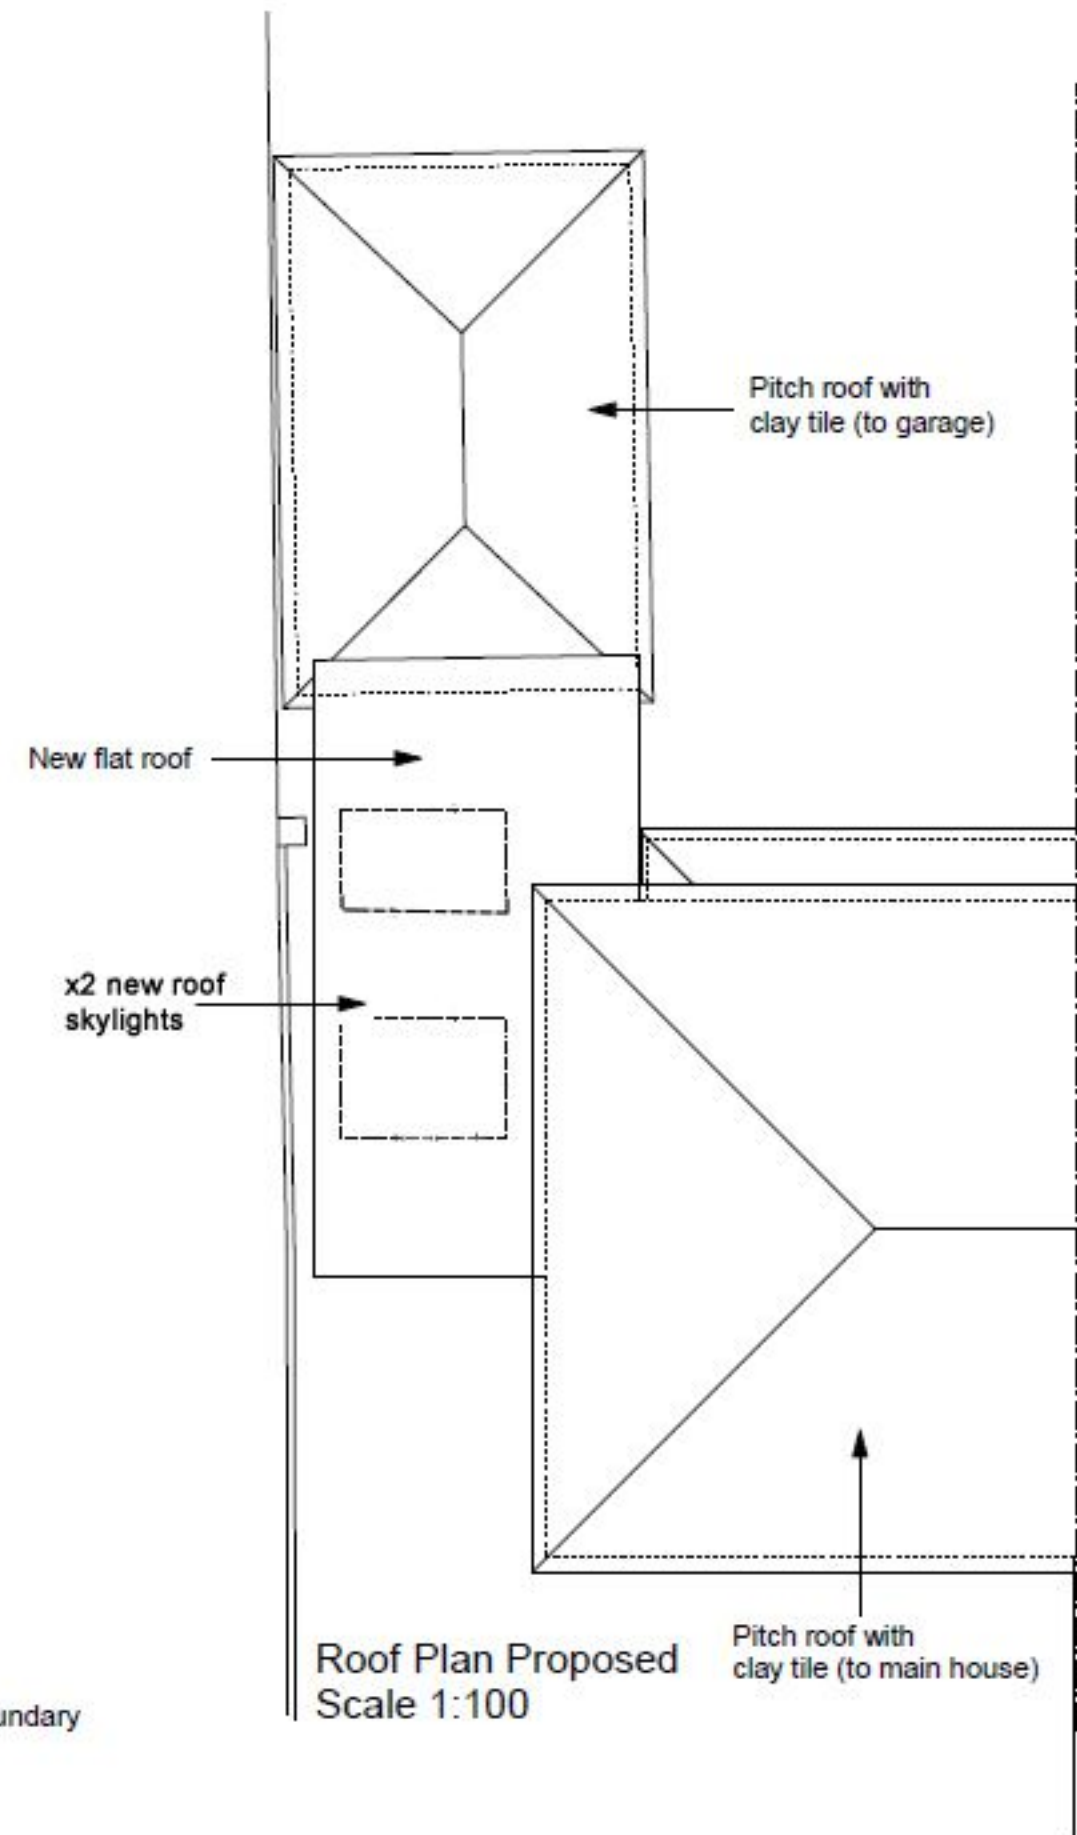


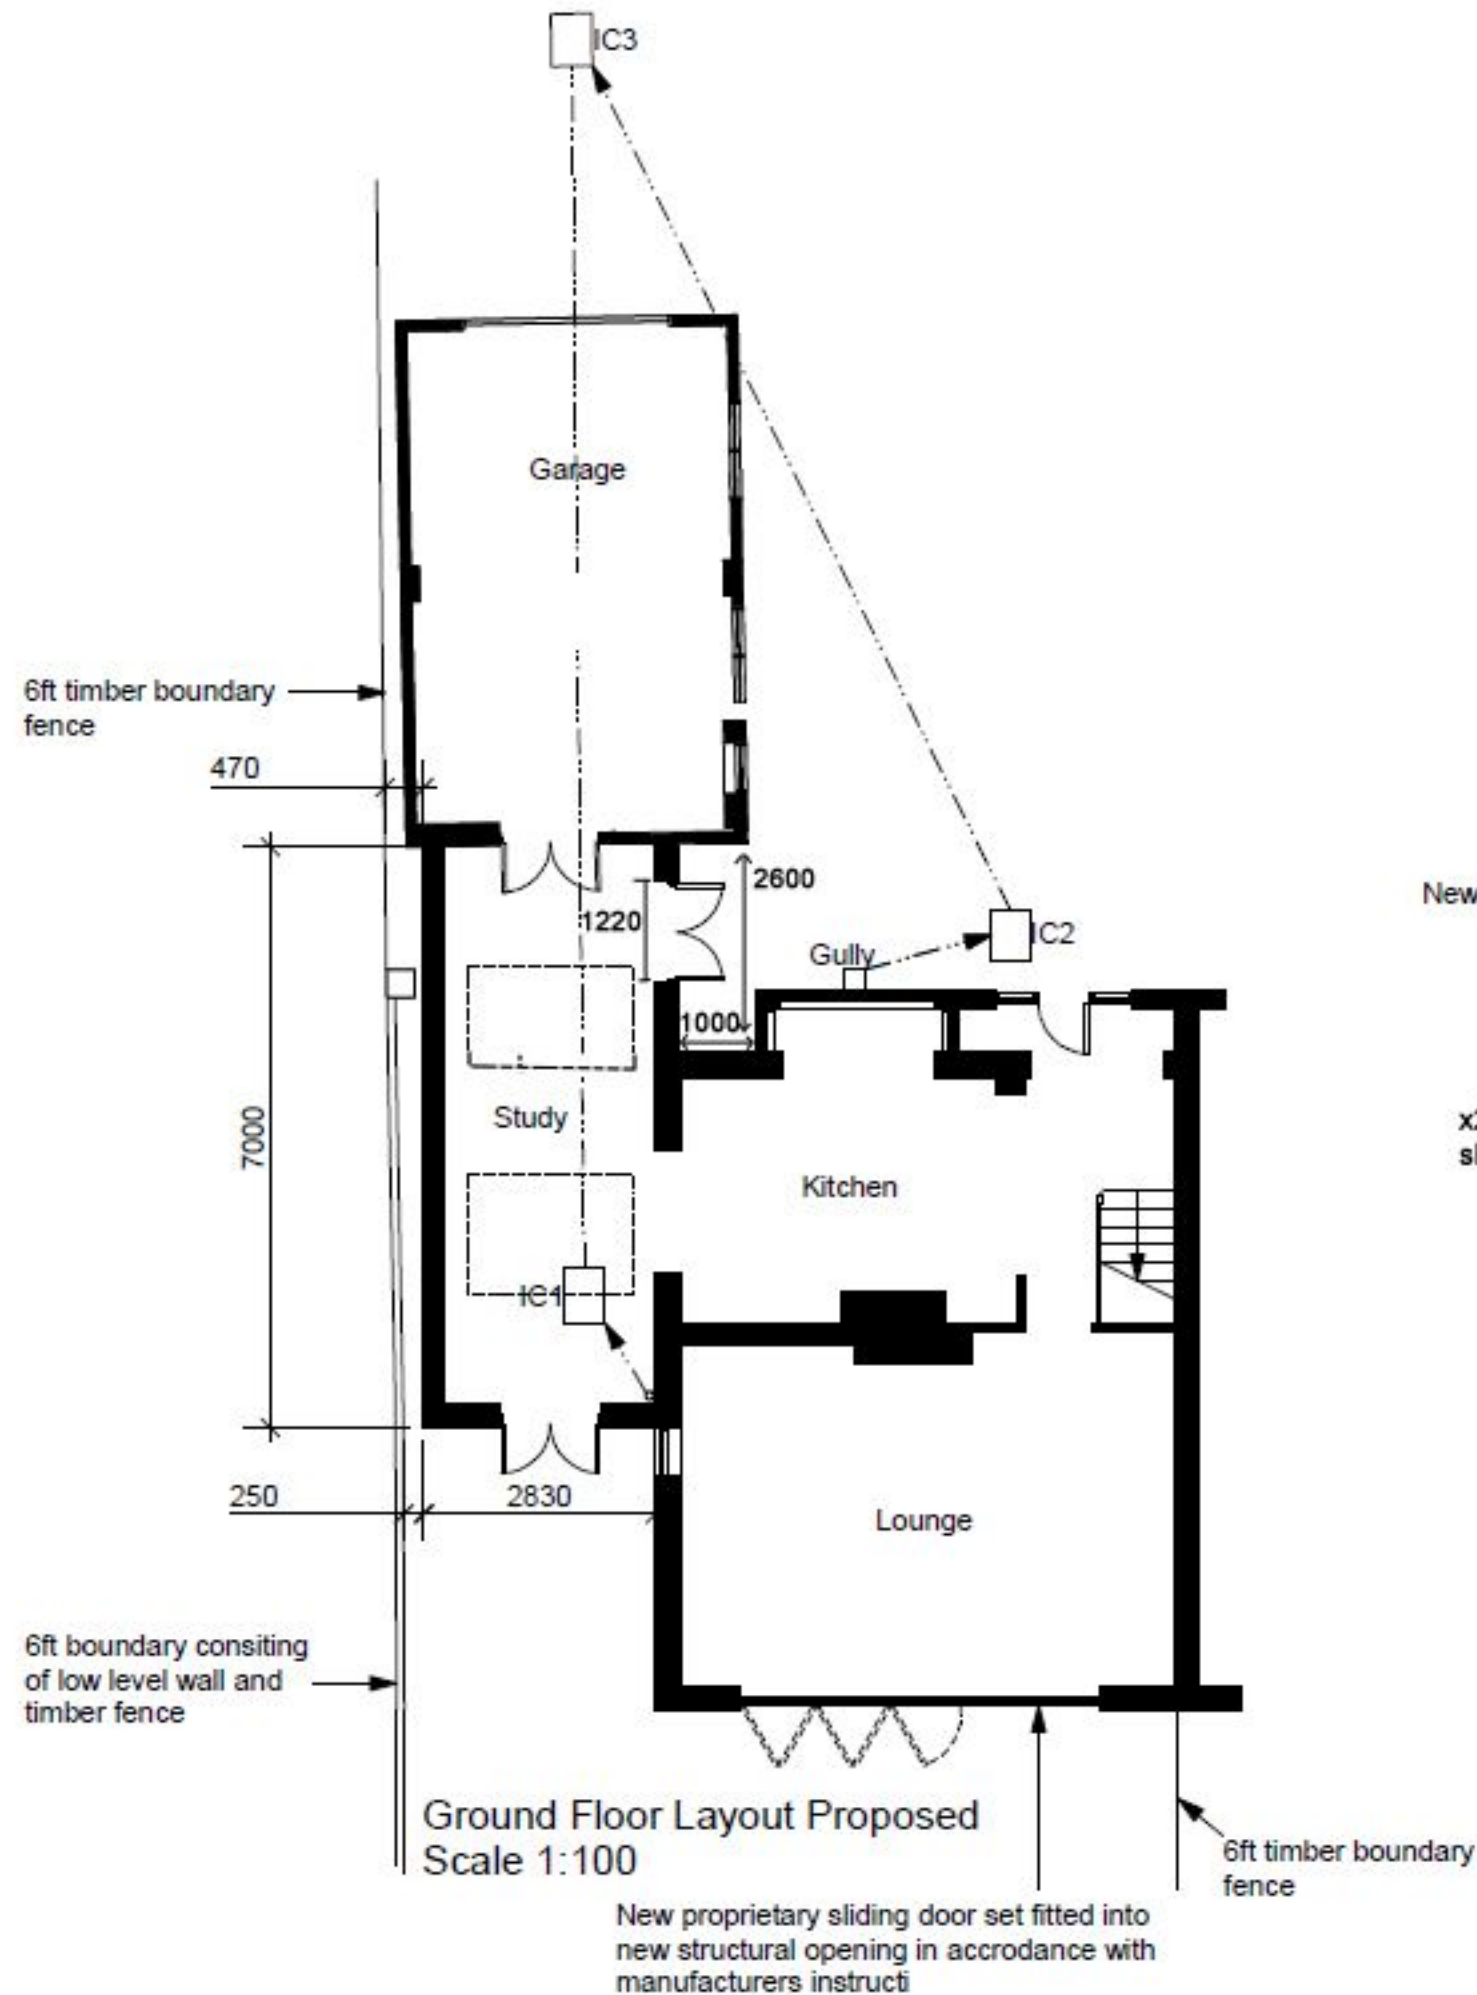

Note:
The first floor plan is not shown as it is not affected by the proposed extension and will remain as existing.

All dims and details to be checked on site prior to any commencement of work. This plan is not a full specification or schedule of work and has been produced solely for the purpose of obtaining the necessary local authority consents/approvals. For Party Wall etc. Act 1996 see Government booklet or website.	Status:		Client: Mr O Mayhew Carpenters Cottage Hoe Lane Flansham Bognor Regis West Sussex PO22 8NW	Revision: B	Project: Extension
	Preliminary	☐ Tender		Scale: N/A	Content: Proposed floor and roof plans
	Planning	☐ Construction		Date: Sept 18	
	Building Regulations	☒ As Built		Dwg No: 0M010	