

NOTES:

Dimensions to be checked on site before commencing work. Any discrepancies shall be reported to the architect immediately.

Do not scale from these drawings except for planning purposes.

Use figured dimensions only.

Where applicable this drawing is to be read in conjunction with other consultants' drawings.

All drawings to be read in conjunction with specification and all other drawings including structural engineer and mechanical and electrical drawings / specification




Existing South Elevation @ 1:100




Existing Window



Window Plan @ 1:10

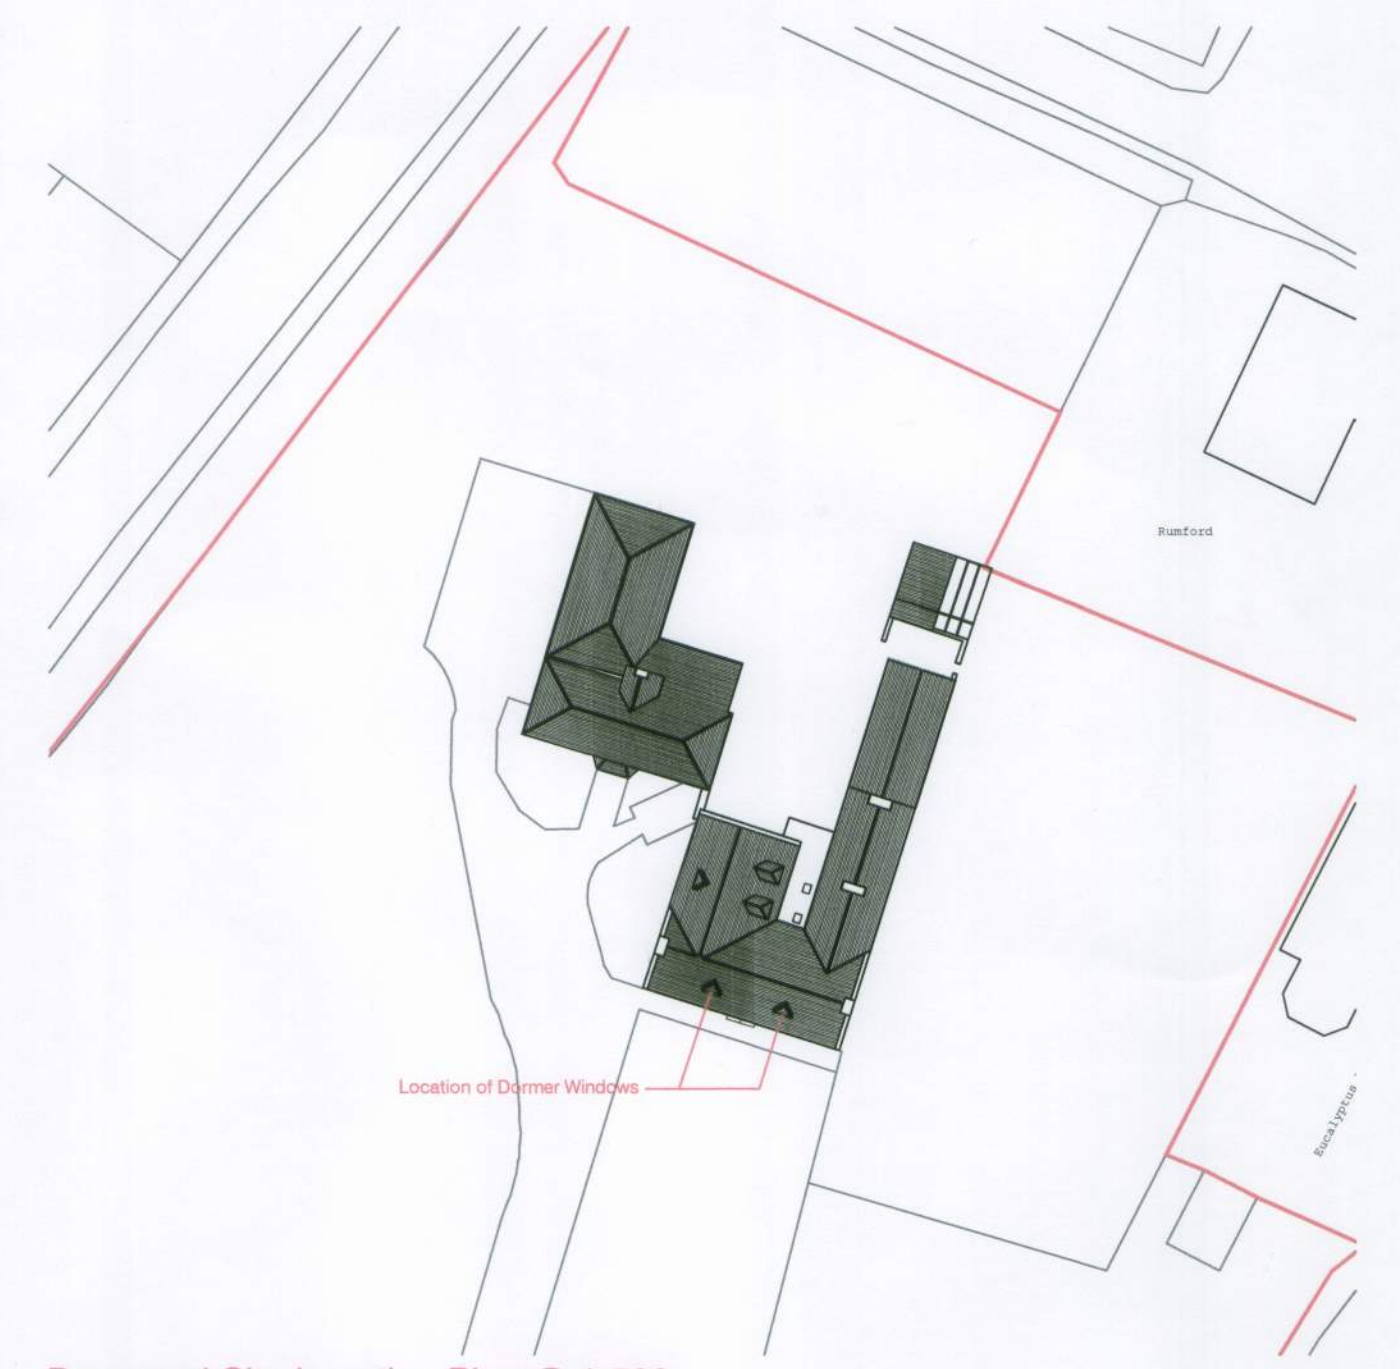

Proposed Site Location Plan @ 1:500
Ordnance Survey, (c) Crown Copyright 2012. All rights reserved. Licence number 100020449

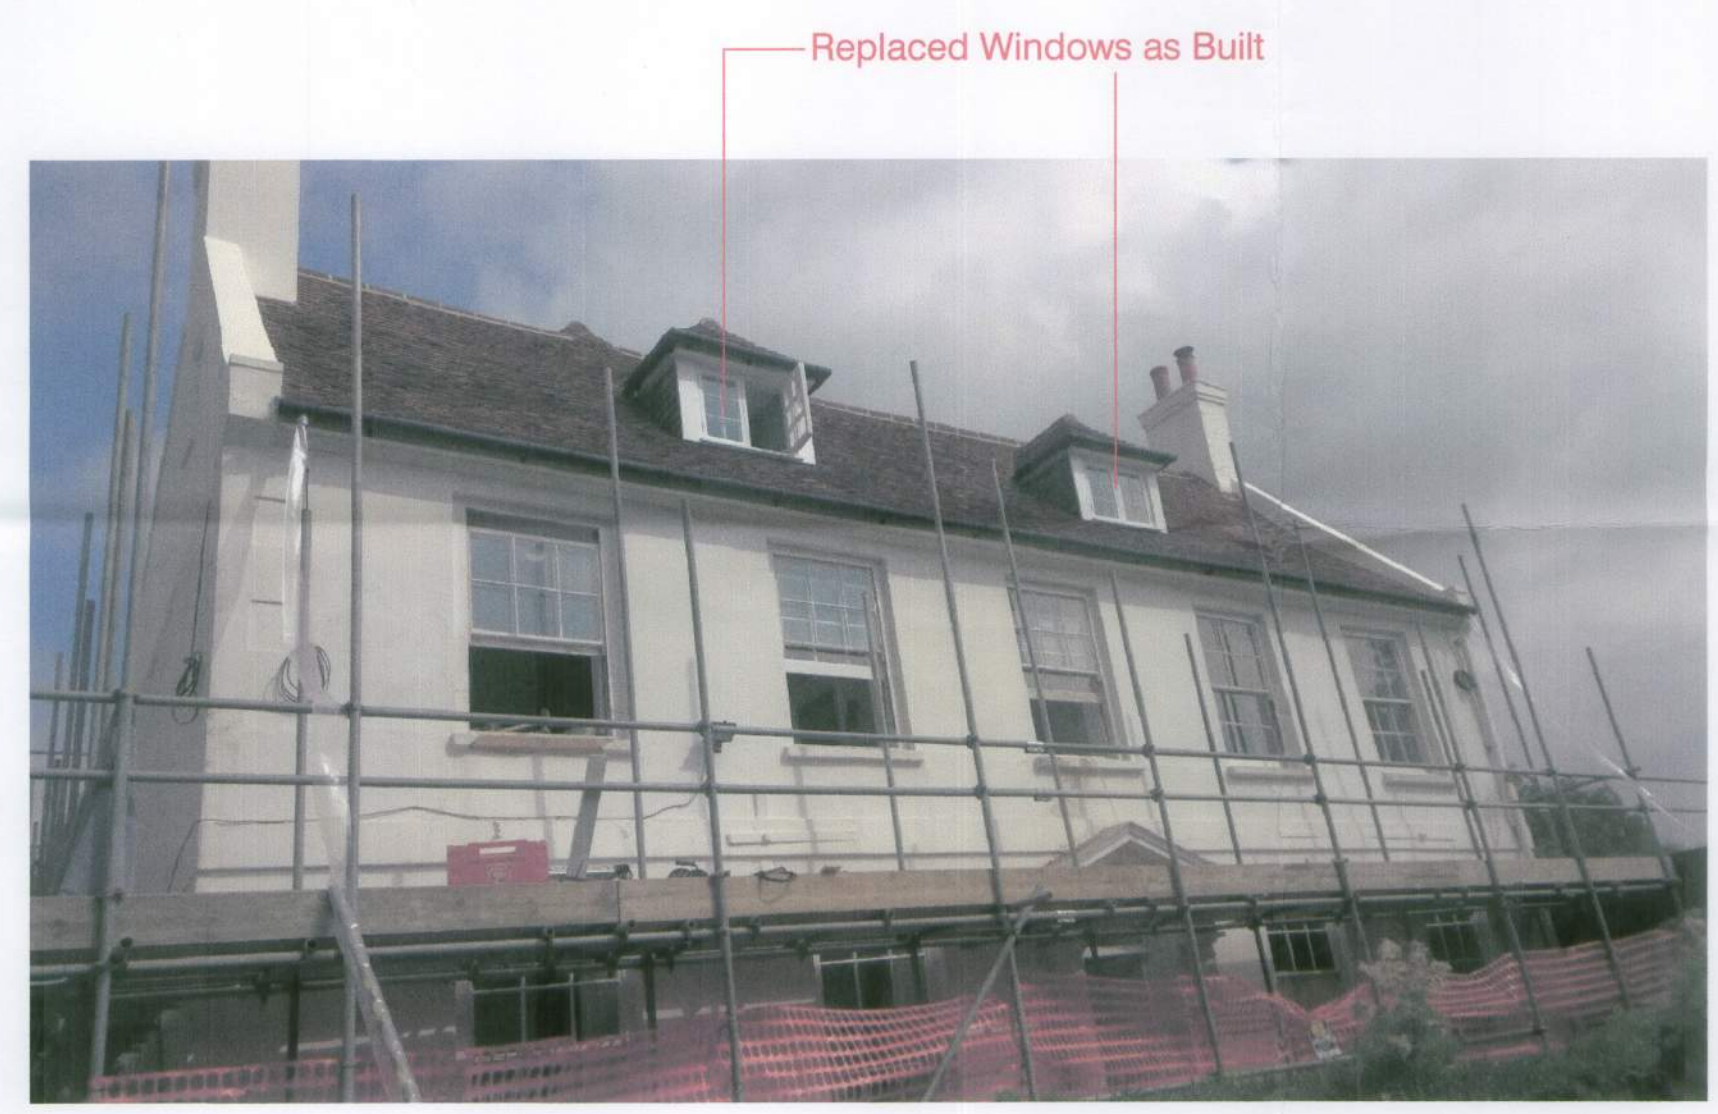


Replaced Windows as Built


Roof tiles to be retained

All of dormer structure including cheeks to be retained


Revised window height with 100mm lead upstand

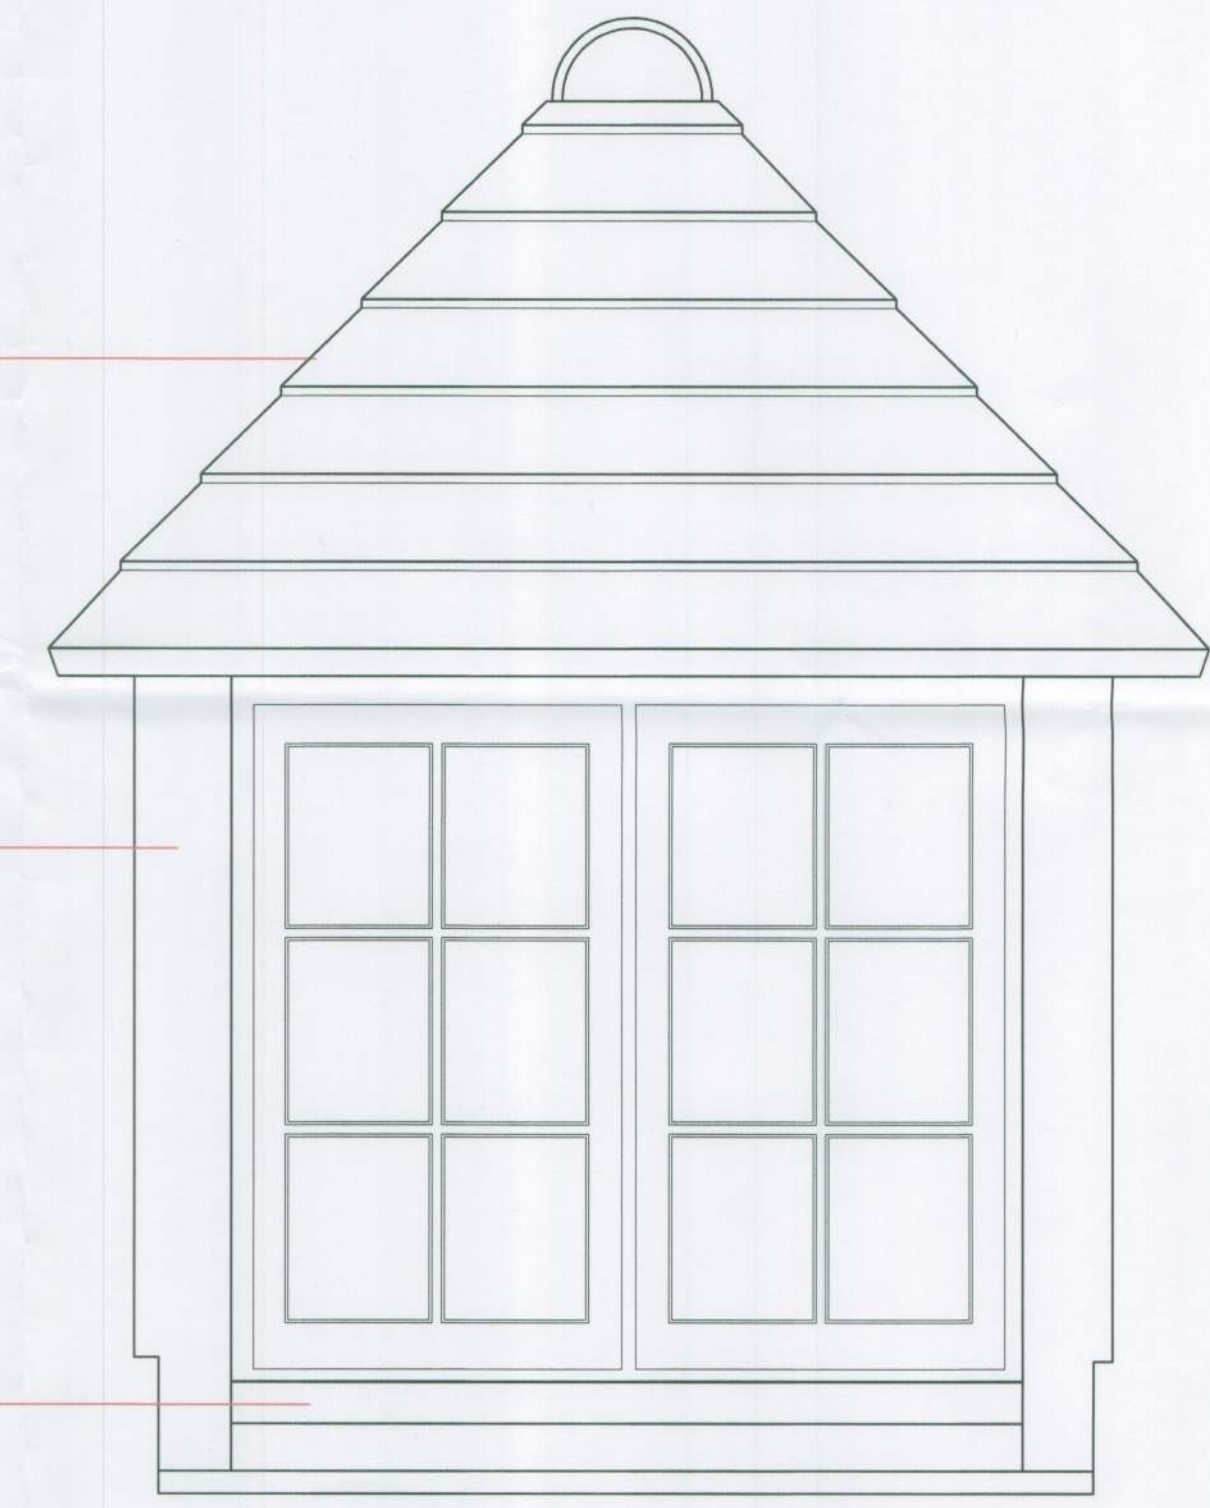

Window Elevation @ 1:10

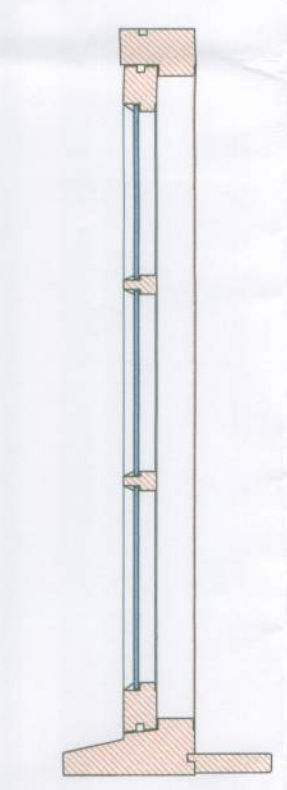

Window Section @ 1:10

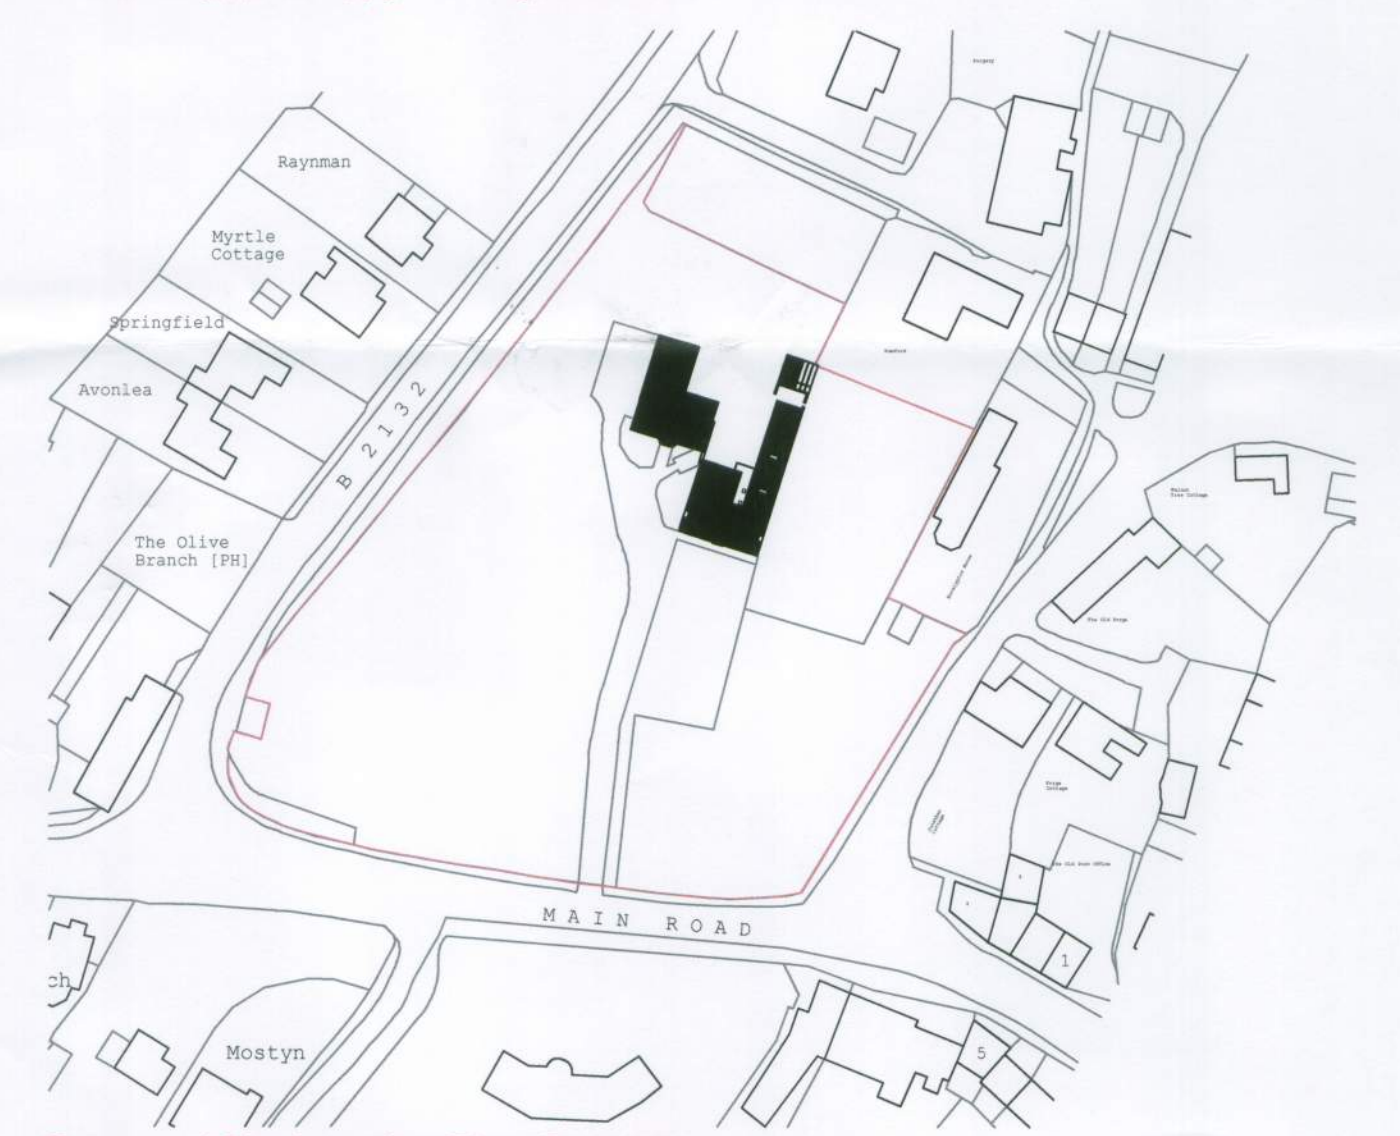

Proposed Site Location Plan @ 1:1250
Ordnance Survey, (c) Crown Copyright 2012. All rights reserved. Licence number 100020449



Proposed South Elevation @ 1:100



Replaced Window as Built

REV	DATE	AMENDMENT	DRAWN

hd
architects

Helyer Davies Architects Ltd
1 The Old Flour Mill,
Emsworth, PO10 7BT
01243 370 715
www.hdarchitects.co.uk mail@hdarchitects.co.uk

CLIENT
Mr Mike Harding

PROJECT
Proposed Renovation and Extension
Berri Court

DRAWING
Revised Dormer Cills

SCALE
Varies

DATE	Sept 2014	DRAWN	SR
DRAWING NUMBER	12127/3000	REVISION	