
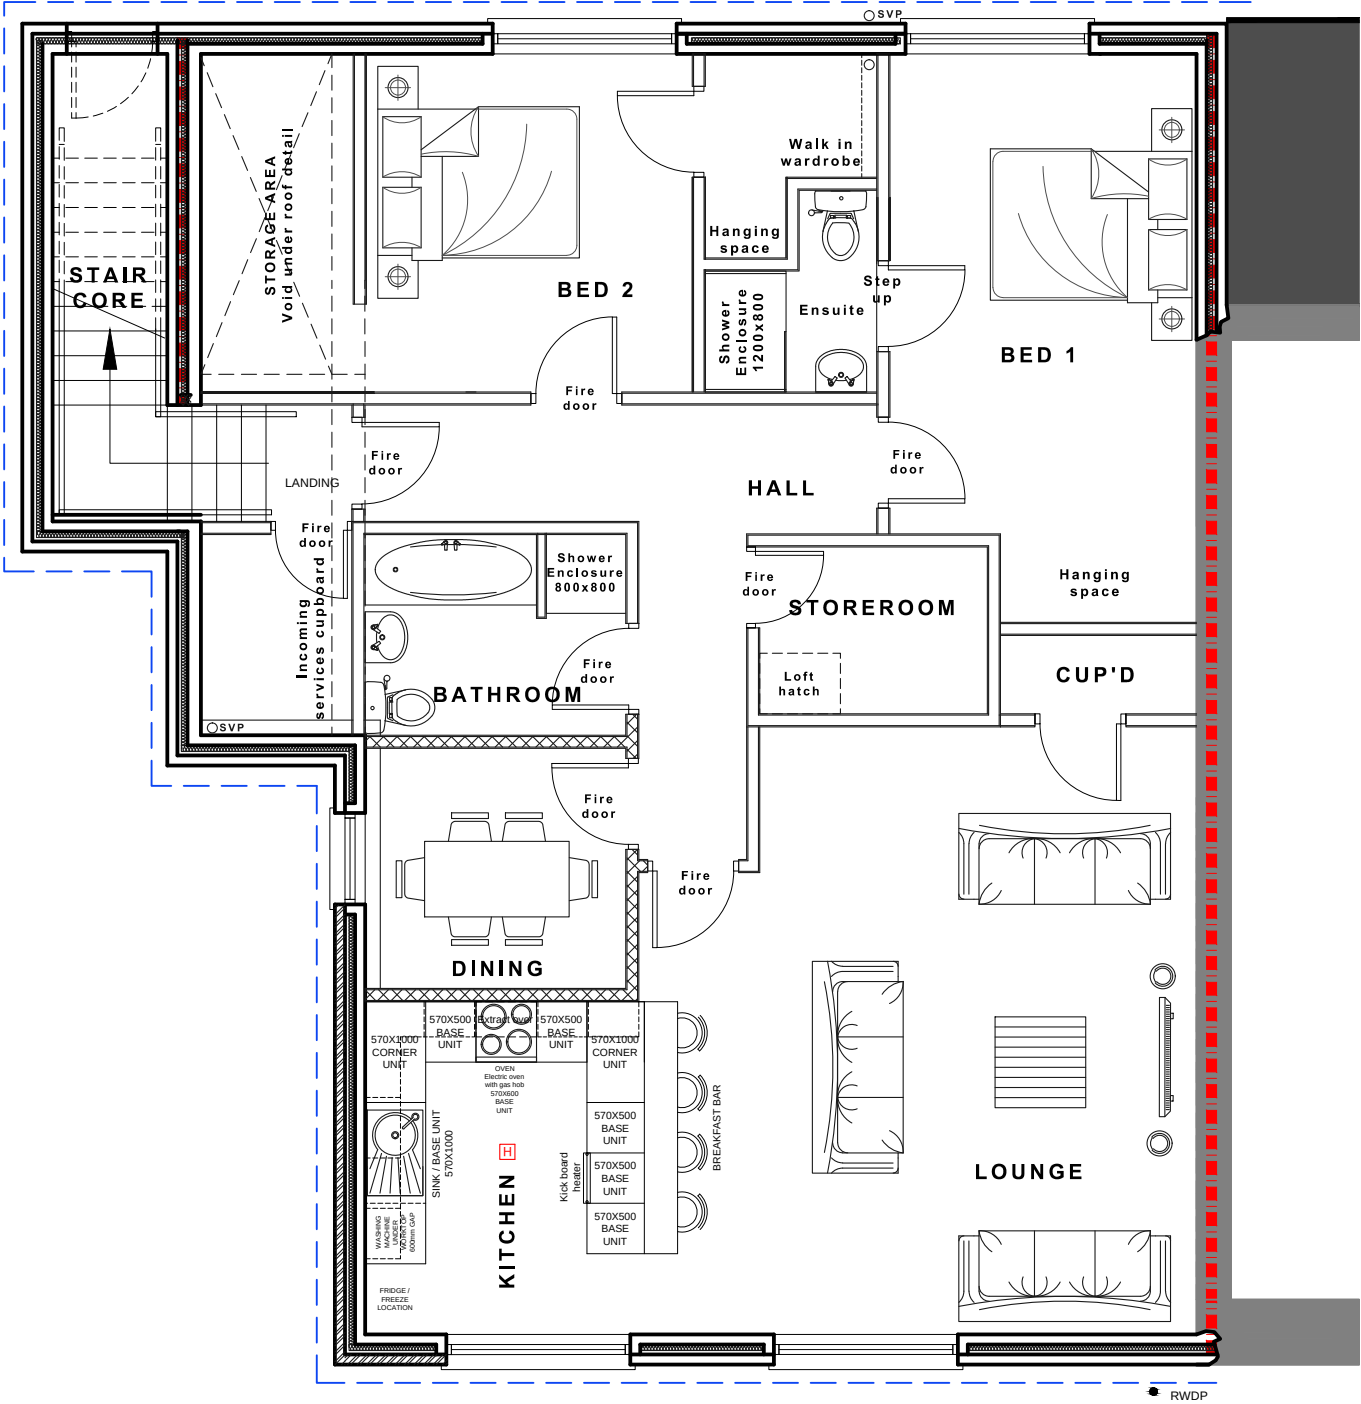


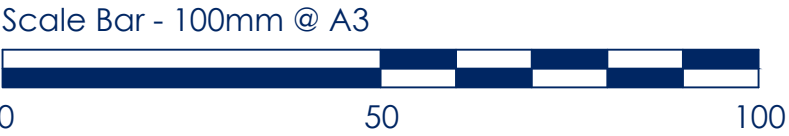

PROPOSED FIRST FLOOR LAYOUT

THIS DRAWING IS THE COPYRIGHT OF THE SOUTHERN CO-OPERATIVE AND MAY NOT BE COPIED, ALTERED OR REPRODUCED IN ANY FORM, OR PASSED TO A THIRD PARTY WITHOUT THE WRITTEN CONSENT OF THE SOUTHERN CO-OPERATIVE.

DO NOT SCALE FROM THIS DRAWING, EXCEPT FOR PLANNING PURPOSES. USE FIGURED DIMENSIONS ONLY.

DIMENSIONS SHOULD BE CHECKED AND VERIFIED ON SITE AND ANY DISCREPANCIES SHOULD BE REPORTED TO THE DESIGNER.

IF IN DOUBT ASK FOR CONFIRMATION.

SALES		
BOH		
GROSS		
FIRST	NA	NA
SUB-LET	NA	NA
MOTHBALLED	NA	NA

ISSUED FOR

AS BUILT

The Southern Co-operative

Retail and Business Development
1000 Lakeside, Western Road, Portsmouth. PO6 3FE
T: 023 9222 2500 | F: 023 9222 2650
E: garykentell@southerncoops.co.uk

DRAWING APPROVAL	SIGNATURE	DATE
DRAWING APPROVAL	SIGNATURE	DATE
DRAWING APPROVAL	SIGNATURE	DATE

PROJECT
FLAT 1
MAIN ROAD
YAPTON, WEST SUSSEX
BN18 0FY

DRAWING TITLE
1ST FLOOR FLAT - AS BUILT PLAN

DRAWING SCALE 1:75	SHEET SIZE A3	SHEET No. 1 of 1	DRAWN GPK	CHKD	DATE 20-10-2014
DRAWING NUMBER 14-YAPFT-001					REVISION -