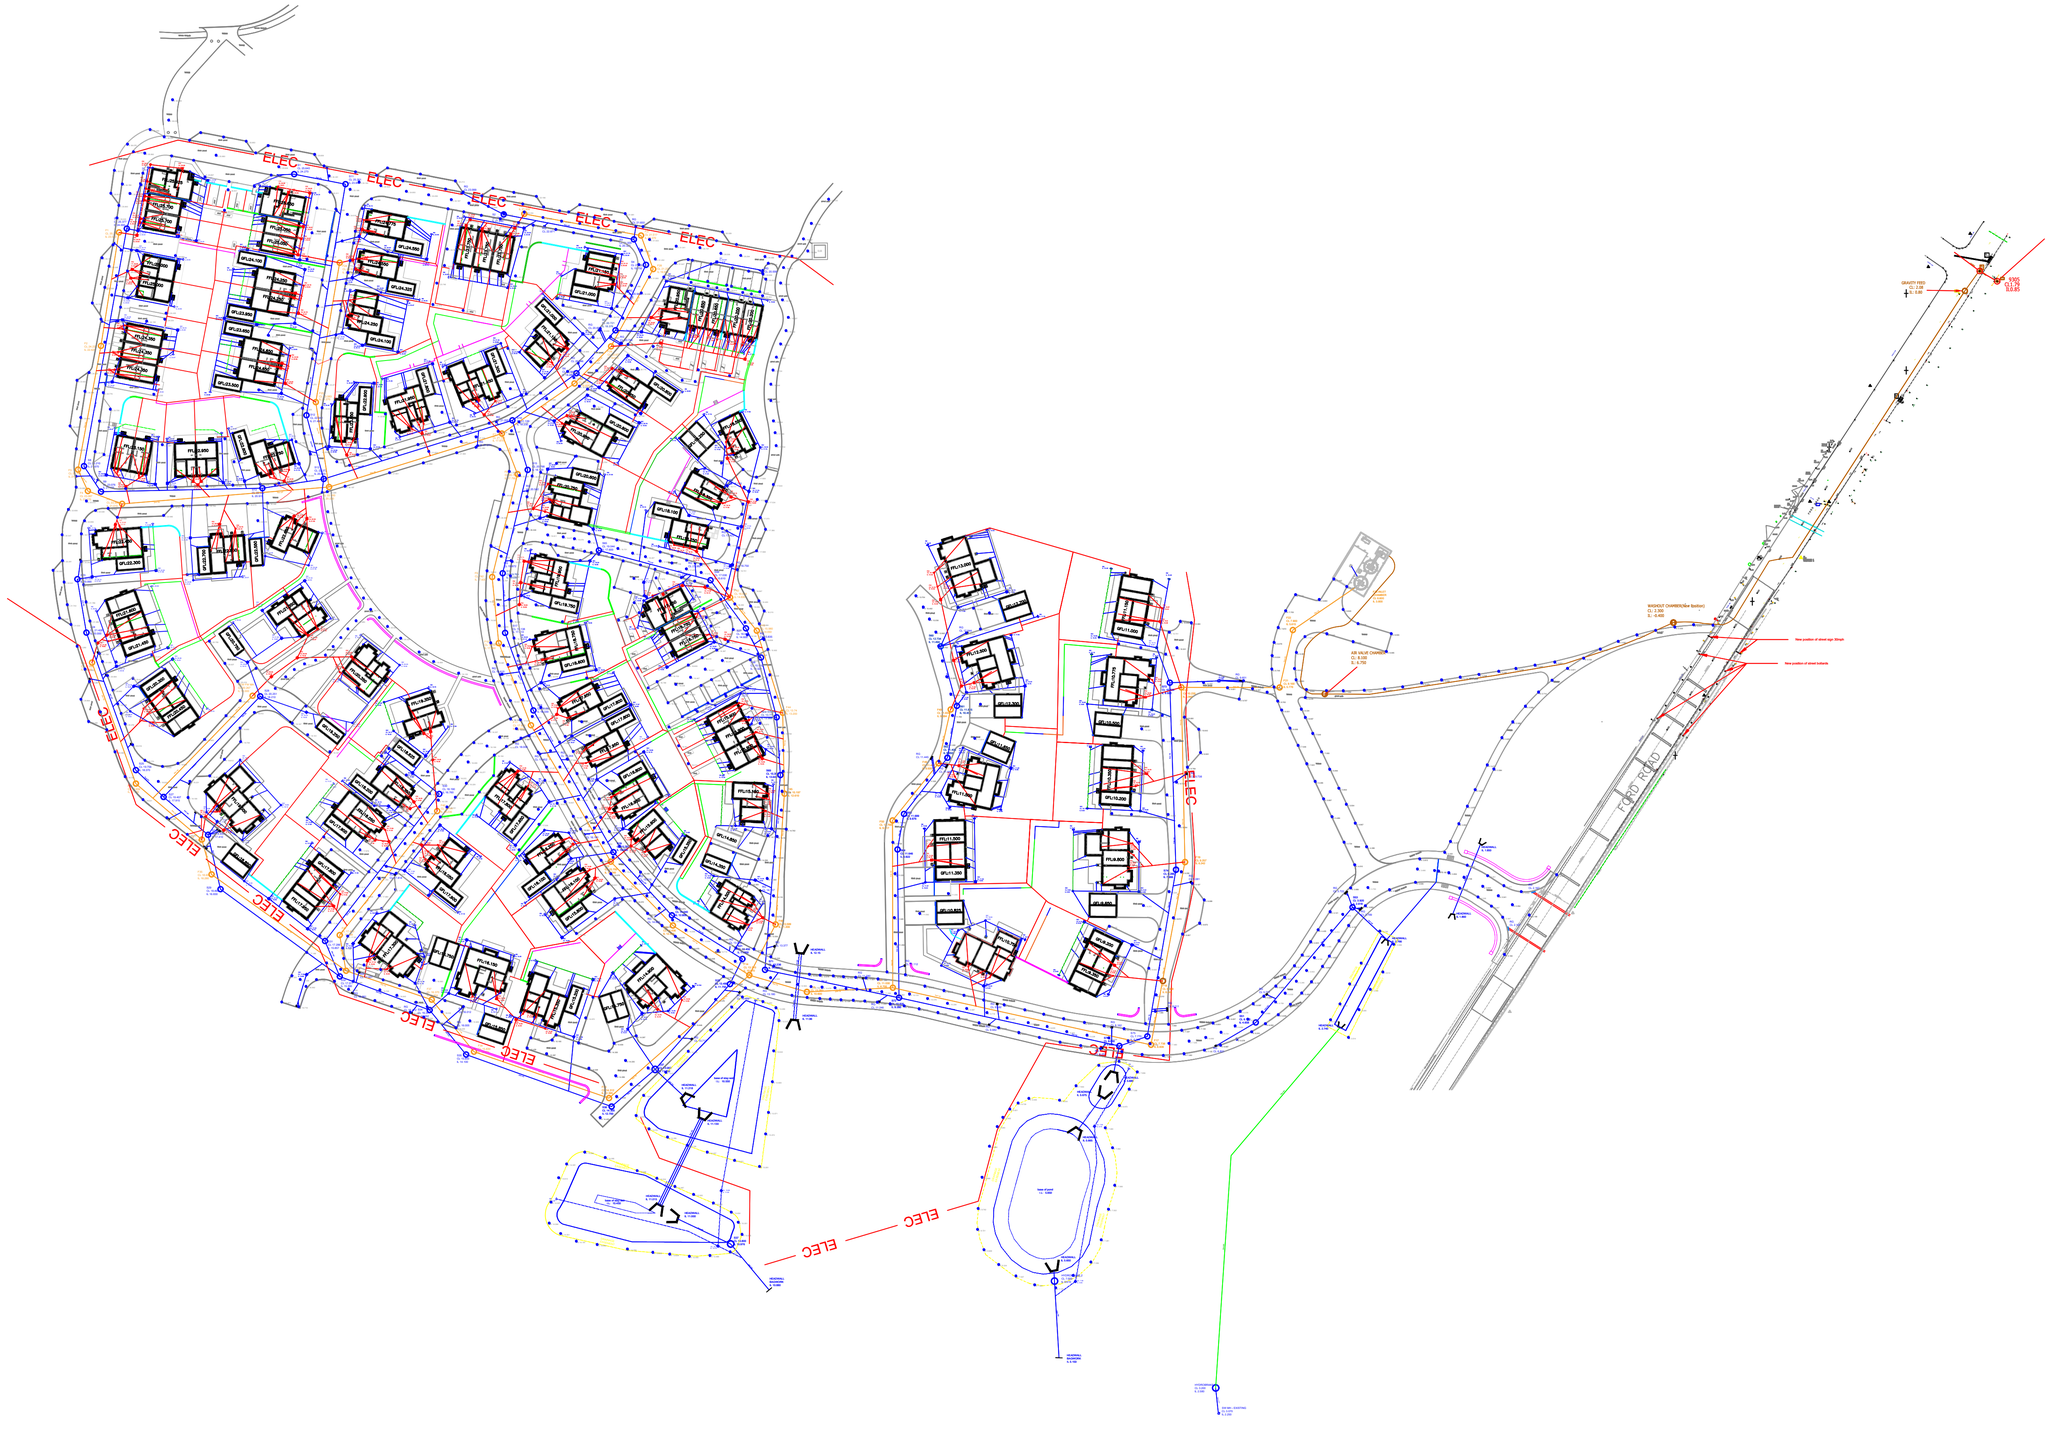

GENERAL NOTES

THIS DRAWING IS THE COPYRIGHT OF BSE3d ITD. AND SHALL NOT BE COPIED OR REPRODUCED WITHOUT PRIOR EXPRESS PERMISSION.

THIS DRAWING SHOULD NOT BE USED FOR SCALING. ANY SCALED DIMENSIONS ARE TO BE CONFIRMED BY THE CONTRACT ADMINISTRATOR.

UNLESS STATED OTHERWISE, ALL DIMENSIONS ARE IN MILLIMETRES.

MATERIALS AND WORKMANSHIP SHALL BE TO THE BEST OF THEIR RESPECTIVE KIND AND CONFORM WITH THE RELEVANT BRITISH & EUROPEAN STANDARDS, SPECIFICATIONS AND CODES OF PRACTICE.

THIS DRAWING SHALL BE READ IN CONJUNCTION WITH ALL OTHER DRAWINGS AND THE SERVICES SPECIFICATION DOCUMENT(S).

FAILURE TO RAISE QUERIES IN A TIMELY MANNER SHALL RESULT IN COSTS BOURNE DIRECTLY BY THE CONTRACTOR.

CDM RESIDUAL MECHANICAL, ELECTRICAL & PUBLIC HEALTH DESIGN RISKS AND RESIDUAL ENVIRONMENTAL RISKS
NO UNUSUAL RISKS ASSOCIATED WITH THIS ELEMENT OF WORK.
In accordance with the Construction Design Management Regulations 2015, BSE3D Consulting Engineers ltd has undertaken a design risk assessment for the elements of work shown on this drawing. The above are some but not all the residual risks identified in the risk assessment.

ABBREVIATIONS:
2x1 100Ø DUCT

	CONFIGURATION & SIZE IN MILLIMETRES	IL	INVERT LEVEL
		JB	JUNCTION BOX
0.50	DEPTH IN METRES	LP	LAMP POST
AV	AIR VALVE	MKR	MARKER POST
BH	BOREHOLE	MH	MANHOLE
BL	BLOCKED	NL	NOT LOCATED
BOL	BOLLARD	NSV	NO SERVICE VISIBLE
BC	BOLLARD COVER	RDG	RIDGE LEVEL
BPav	BRICK PAVING	RI	RISER
CCTV	CCTV CAMERA	RS	ROAD SIGN
CC	CONTROL CABINET	SA	SOAK AWAY
CL	COVER LEVEL	SL	SENSOR LOOP
CO	COLUMN	SV	SLUICE VALVE
CP	CATCH PIT	TMac	TARMAC
DP	DRAINPIPE	TPav	TACTILE PAVING
EOT	END OF TRACE	TR	TREE
EP	ELECTRIC POLE	VP	VENT PIPE
EV	EAVE LEVEL	WM	WATER METER
FRL	FLAT ROOF LEVEL	WO	WASHOUT
GV	GAS VALVE	WSV	WATER STOP VALVE
GY	GULLY	WV	WATER VALVE
IC	INSPECTION COVER	UTL	UNABLE TO LIFT
		UTT	UNABLE TO TRACE

Notes:
1.Dimensions should not be scaled. All dimensions should be checked onsite before proceeding with any works.

REVISION	COMMENTS
1.0	ISSUE FOR INFORMATION

KENWARD
Eastwood Farm
Rusper Road
Horsham
RH5 5BX
TEL: 01403 210218
E:ADMIN@KENWARD.CO.UK

Site:
Arundel Gate
Ford Road
Arundel, West Sussex
BN18 9EX

Drawing Title:
As Built Drawing

Scale	Drawn By	Date Drawn	Checked By
1:750	AR	18/08/2026	KC

Drawing No.	Revision
3125-01-02	As Built
Sheet No. 1 of 1	

DOCUMENT IS UN-CONTROLLED WHEN PRINTED