ARUN DISTRICT COUNCIL AB/76/17/CLE

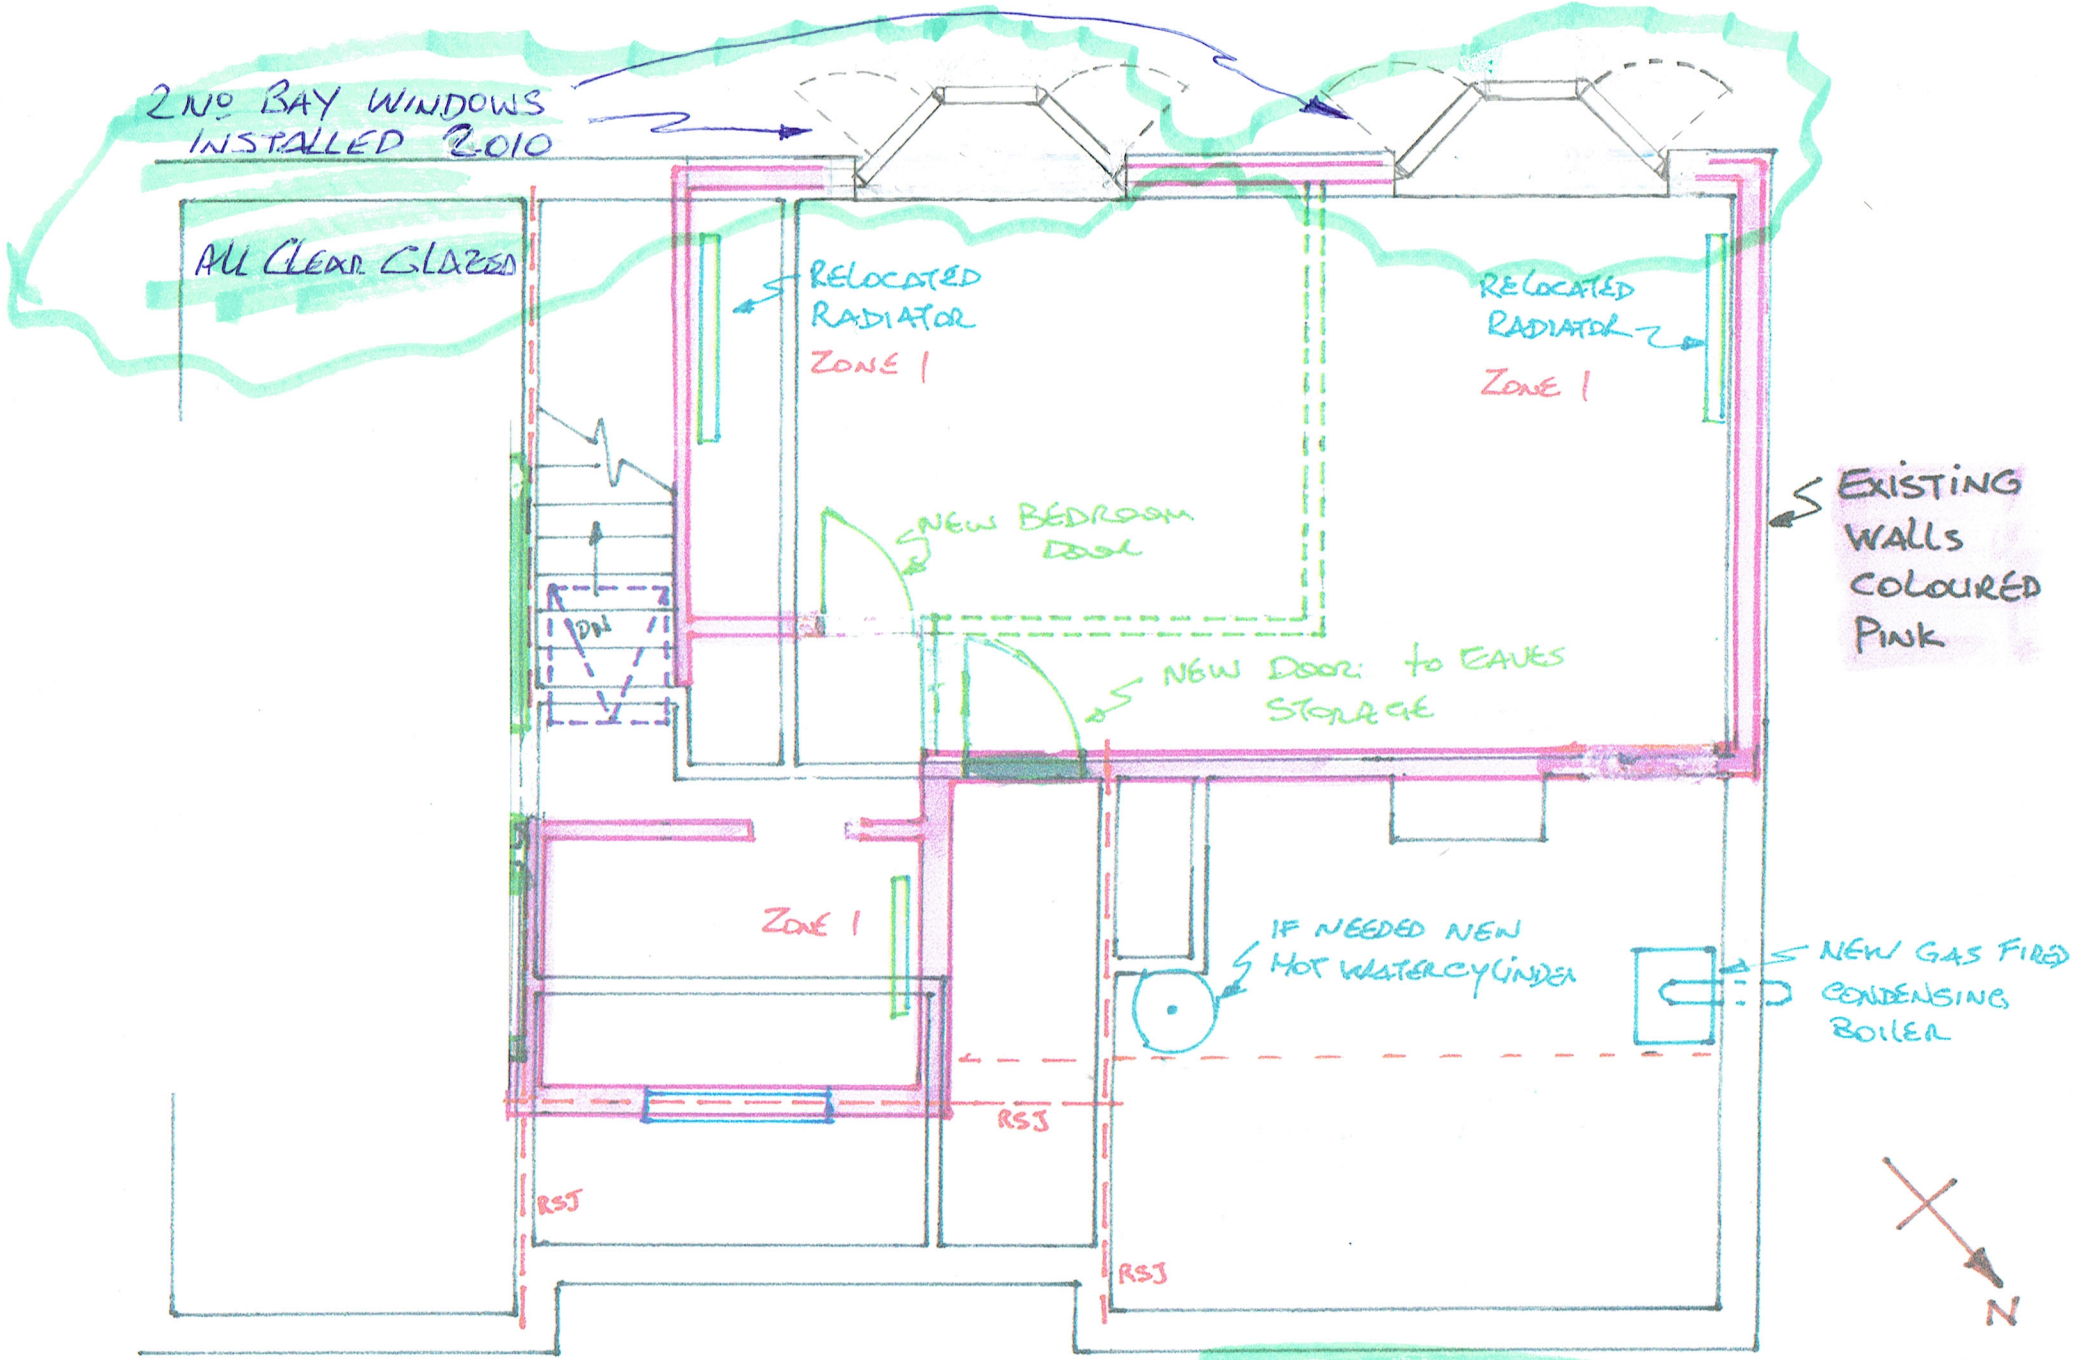

AS INSTALLED 2010

FRONT

FIRST FLOOR

scale 1:50

20/6/17